





Registered Surveyor's Certification
 We, VERIS AUSTRALIA P/L, hereby certify that the horizontal and vertical locations, and dimensions shown on this plan are a true and correct record of the As Constructed information.
 Signed: _____ Cadastrial Surveyor Reg No 54438 & 54439
 Dated: _____

ENGINEER'S CERTIFICATION
 I, _____ hereby certify that:
 1. The information contained in this drawing / document is in compliance with approved drawings and design.
 2. The new water and sewerage works defined by this drawing have been designed and constructed in accordance with the SEQ Code.
 3. This represents an accurate record of as-constructed works.
 4. I accept responsibility for the information contained in this drawing / document.
 RPEQ (signature) RPEQ No. _____ Date: _____

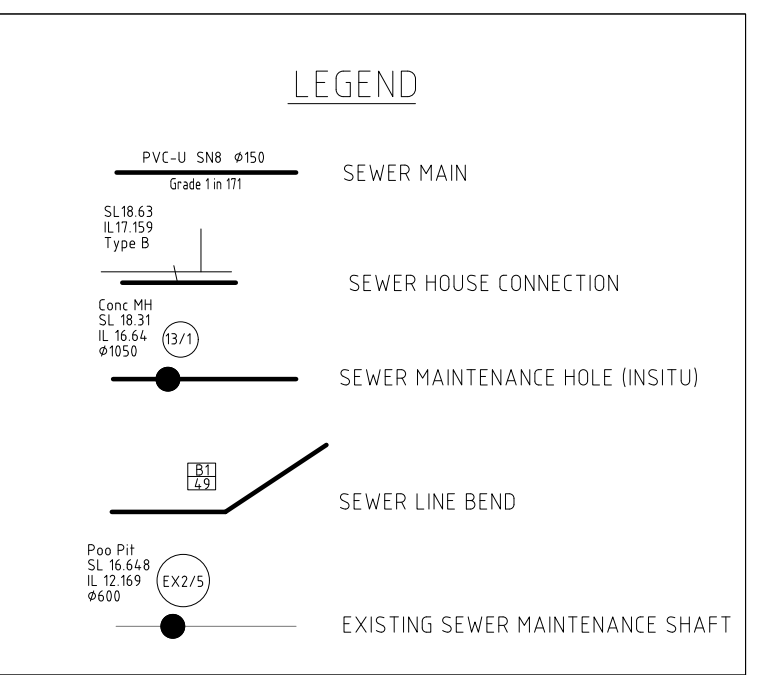

NOTES:
 • ALL PROPERTY CONNECTIONS ARE Ø100 uPVC-U S110

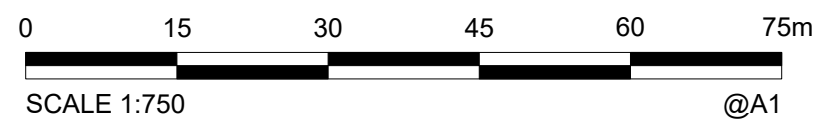

AS CONSTRUCTED

A1	D	28/01/2025	PROGRESS PLOT	JMc					
	C	17/12/2024	PROGRESS PLOT	JMc					
	B	26/09/2024	PROGRESS PLOT	JMc					
	A	26/08/2024	PROGRESS PLOT	JMc					
	INDEX	DATE		REVISIONS	DRAWN	CHECKED	PASSED	INITIALS	DATE


CONSULTING SURVEYOR
veris
 BRISBANE (07) 3668 4700 WHITSUNDAYS (07) 4945 6600
 MACKAY (07) 4957 9700 CAIRNS (07) 4522 9400
 veris.com.au
 ACN 616 735 727
 Veris Australia Pty Ltd

COVEY
 ASSOCIATES PTY LTD
 Consulting Civil & Structural Engineers
 Project Management & Planning
 124 DUPORTH AVENUE Ph (07) 5443 7777
 MAROOCHYDORE QLD 4558 Fax (07) 5443 7577
 E-MAIL: engineers@covey.com.au



Unitywater
 OW NUMBER TBC
 LILYWOOD LANDINGS
 STAGES 1A & 1B
 AS CONSTRUCTED SEWER

SHEET 1 OF 3 SHEETS	SCALE 1:750
REVISION DATE 28/01/2025	REVISION D
DISCIPLINE CODE C	
DRAWING NO. 401871-1A-1B-AS01-D	

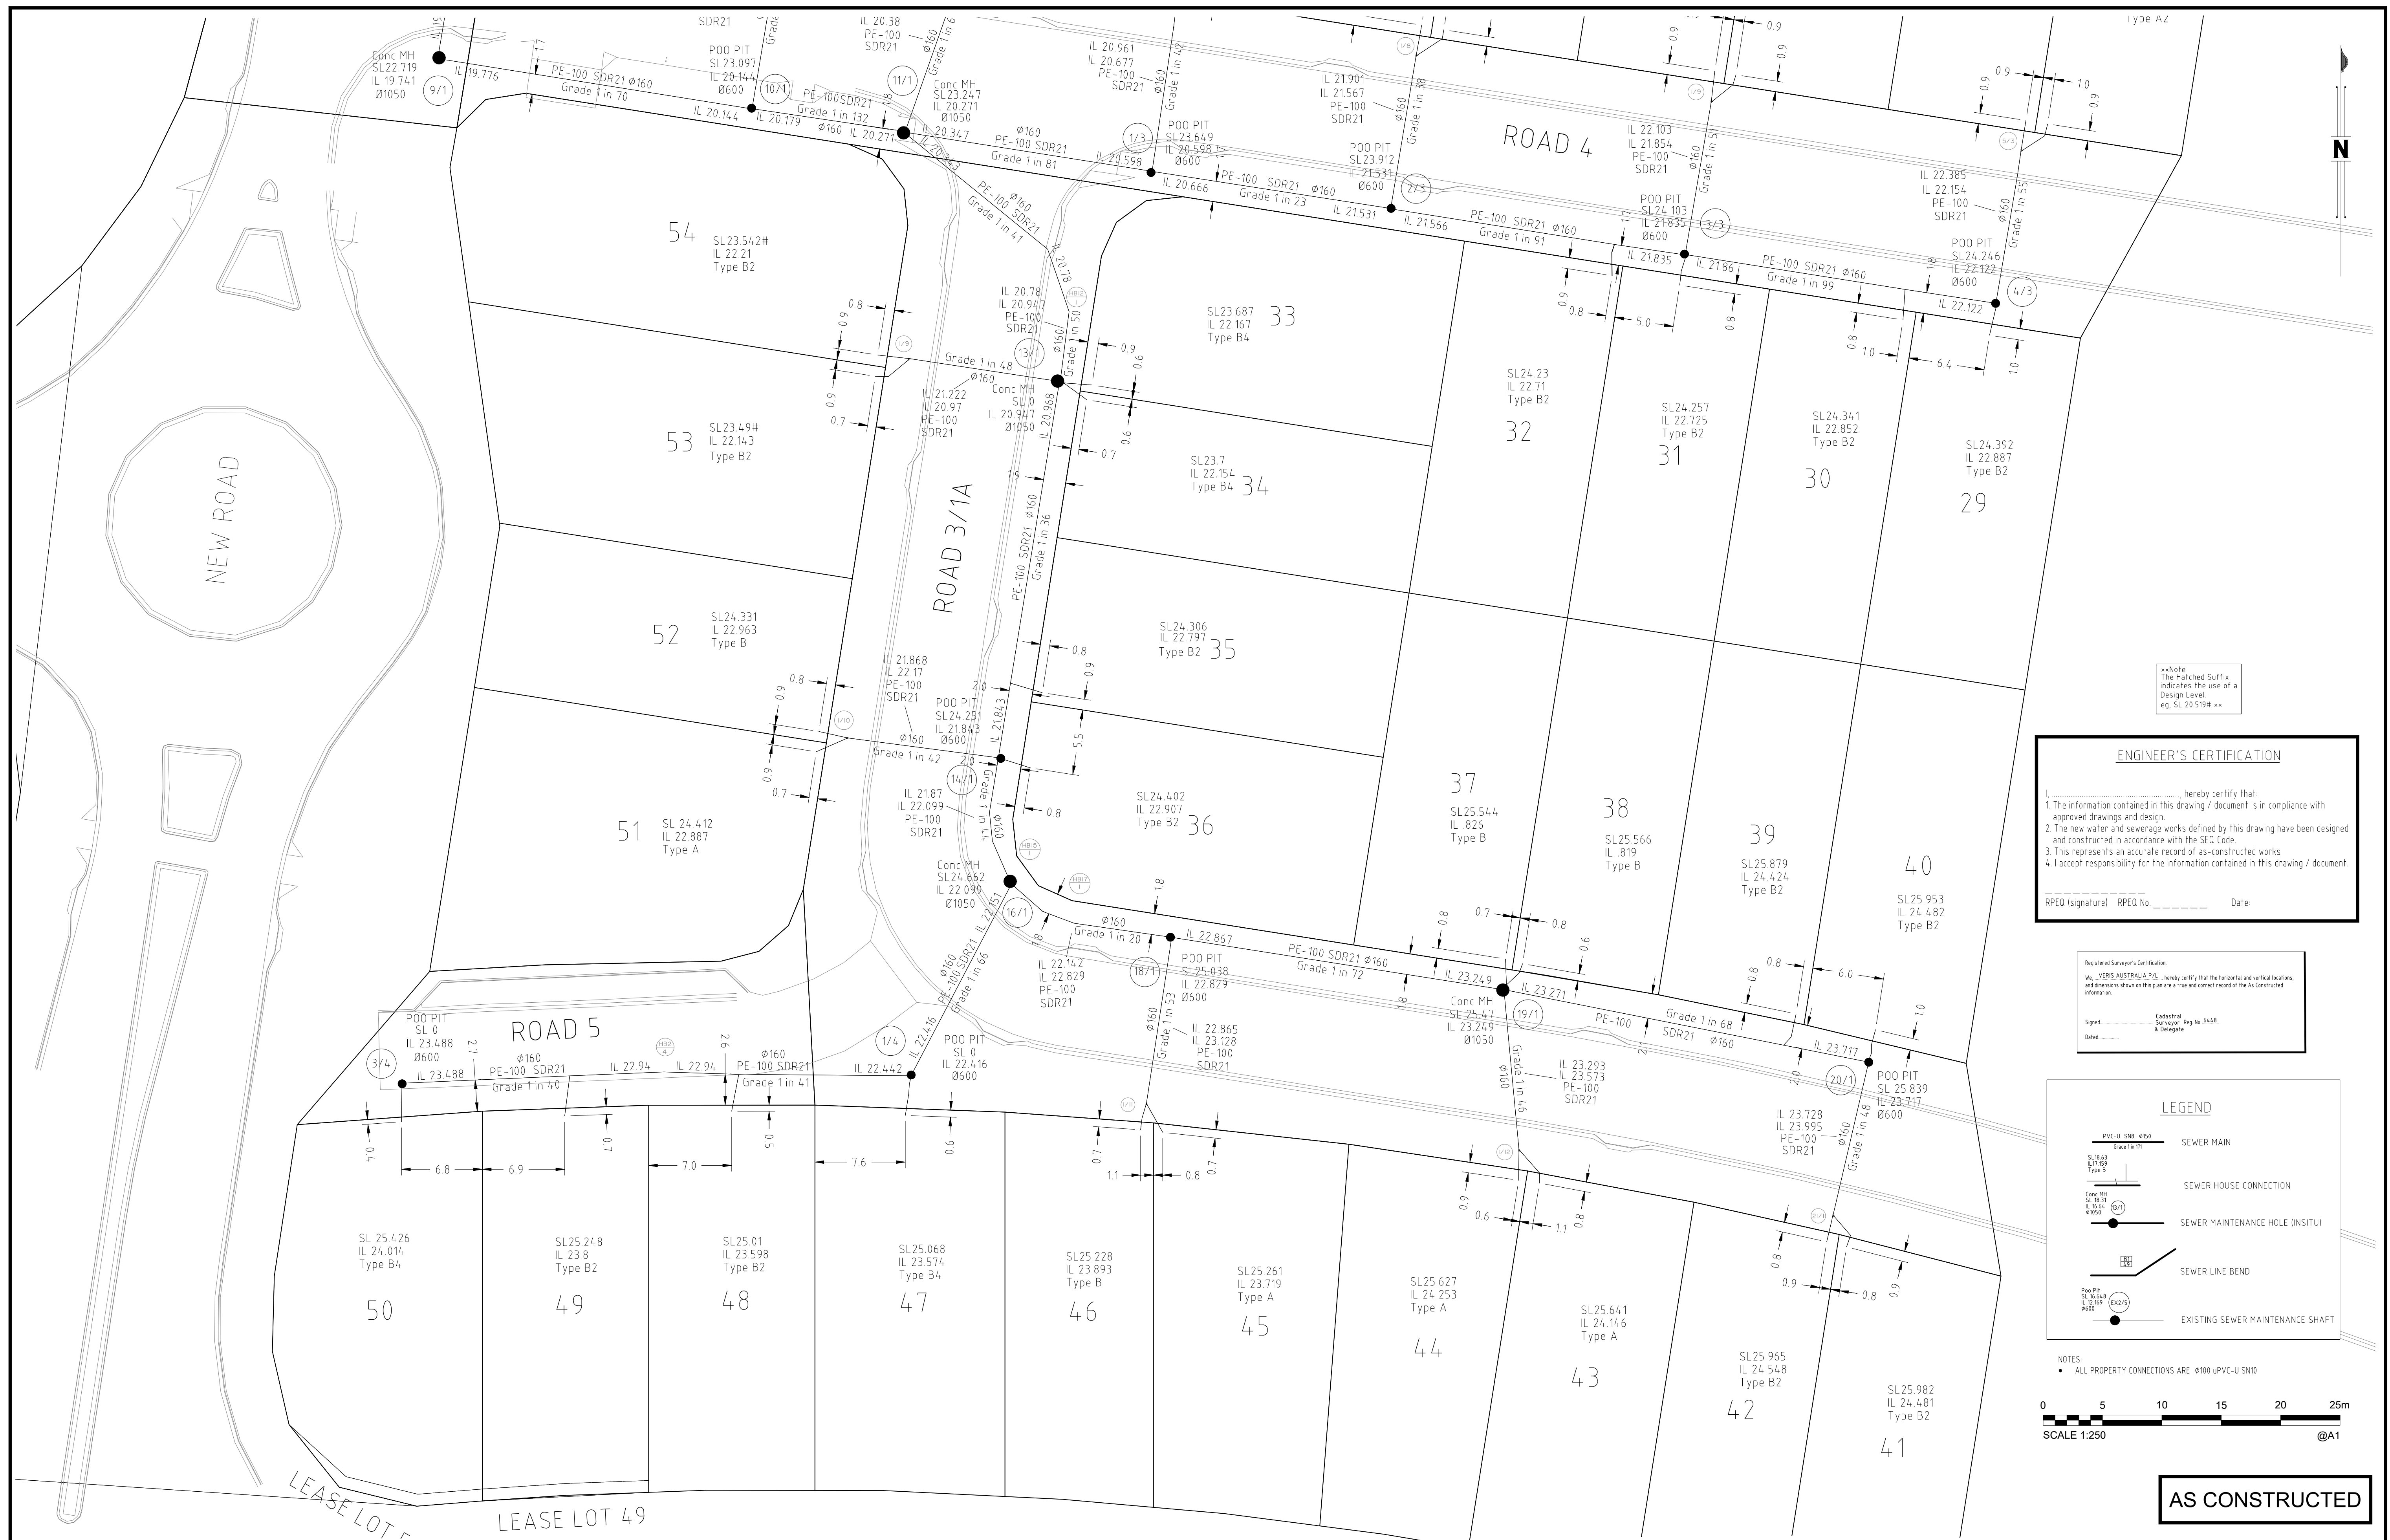

***Note
The Hatched Suffix
indicates the use of a
Design Level
eg. SL 26.519# ***

ENGINEER'S CERTIFICATION

I, _____, hereby certify that:


- The information contained in this drawing / document is in compliance with approved drawings and design.
- The new water and sewerage works defined by this drawing have been designed and constructed in accordance with the SEQ Code.
- This represents an accurate record of as-constructed works.
- I accept responsibility for the information contained in this drawing / document.

RPEO (signature) RPEO No. _____ Date _____

Registered Surveyor's Certification:

Me, _____, hereby certify that the horizontal and vertical locations, and dimensions shown on this plan are a true and correct record of the As Constructed information.

Signed: _____
Cadastral Surveyor Reg No. 85448
& Delegate
Date: _____

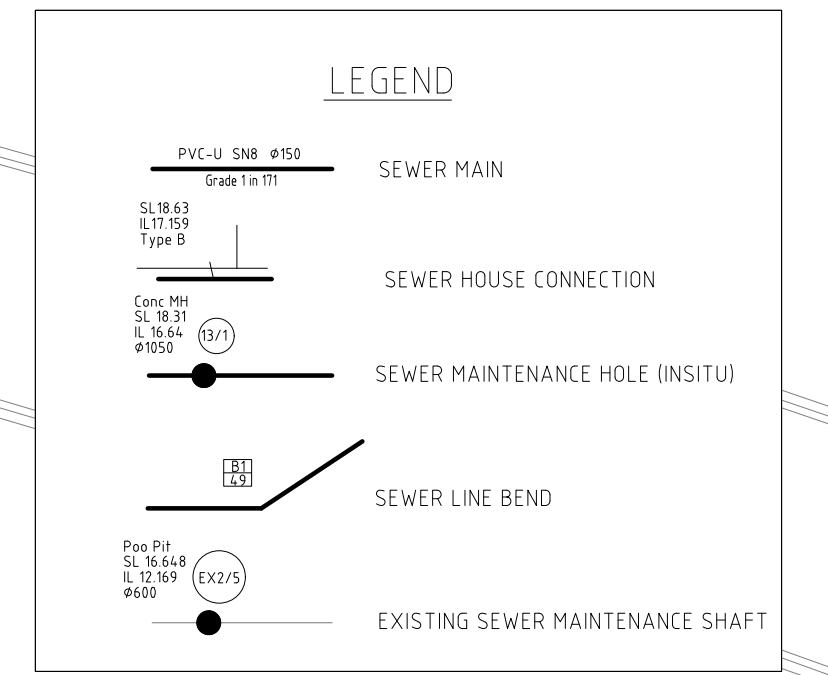

NOTES

- ALL PROPERTY CONNECTIONS ARE Ø100 uPVC-U S100

0 5 10 15 20 25m
SCALE 1:250 @A1

AS CONSTRUCTED

A1	D	28/01/2025	PROGRESS PLOT	JMc					
	C	17/12/2024	PROGRESS PLOT	JMc					
	B	26/09/2024	PROGRESS PLOT	JMc					
	A	26/08/2024	PROGRESS PLOT	JMc					
	INDEX		DATE	REVISIONS	DRAWN	CHECKED	PASSED	INITIALS	DATE

CONSULTING SURVEYOR

veris
BRISBANE WHITSUNDAYS
077 366 4700 (07) 4262 9400
MACKAY CAIRNS
(07) 4927 9700 (07) 4262 9400
ACN 615 735 727
Veris Australia Pty Ltd

CONSULTING ENGINEER

COVEY
ASSOCIATES PTY LTD
124 DUPORTH AVENUE
MAROOCHYDOORE QLD 4558
Ph (07) 5443 7777
Fax (07) 5443 7577
E-MAIL: engineers@covey.com.au

Consulting Civil & Structural Engineers
Project Management & Planning



Unitywater

OW NUMBER TBC
LILYWOOD LANDINGS
STAGES 1A & 1B
AS CONSTRUCTED SEWER

SHEET 3 OF 3 SHEETS	SCALE 1:250
REVISION DATE 28/01/2025	REVISION D
DISCIPLINE CODE C	
DRAWING NO. 401871-1A-1B-AS01-D	