

SHEET 2

SHEET 3



ENGINEER'S CERTIFICATION

I, _____ being a Certificated/Registered Engineer and
 (Engineer's Name)
 duly authorised representative of _____ EGIS CONSULTING P/L
 (Consulting firm or company)

Hereby:-

- certify the information contained in this drawing/file is an accurate "as constructed" representation of the works;
- accept responsibility for the "as constructed" information contained in this drawing/file; and
- acknowledge the "as constructed" information contained in this drawing/file may be relied on by the Council and others.


Certification for Stages 1A&1B by _____ on _____
 (Stage No) (Signature) (Date)

for _____ EGIS CONSULTING P/L
 (Company Name)
 Registered Professional Engineering Company of Queensland _____
 (Number)

REGISTERED SURVEYOR'S CERTIFICATION

We, VERIS AUSTRALIA PTY LTD., hereby certify that the vertical and horizontal locations and dimensions shown on this plan are a true and correct record and were located by survey.

Delegate Cadastral Surveyor (sig) Reg. Surveyor No. 6448 Date: _____

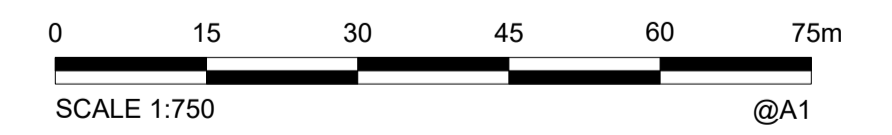

| REV. | DRAWING REVISIONS |
|------|----------------------------|
| | REVISION DESCRIPTION |
| A | PROGRESSES PLOT 16/12/2024 |
| B | PROGRESSES PLOT 28/01/2025 |
| C | PROGRESSES PLOT 07/02/2025 |

| REFERENCE DRAWINGS | DESCRIPTION |
|--------------------|-------------|
| | |

| DESIGN FILE No. | CONSTRUCT. No. | DESIGNED DATE | DATE |
|-----------------|--------------------|---------------|------------|
| | | | |
| SURVEY FILE No. | R01871-1A-1B-ASW01 | DRAWN | JMc |
| FIELD BOOK | | DATE | 16/12/2024 |
| LOG BOOK | | CHECKED | |
| LEVEL DATUM | AHD | DATE | |
| DATUM | | | |



MORETON BAY REGIONAL COUNCIL
 CABOOLTURE DISTRICT OFFICE
 2 HASKING STREET CABOOLTURE QLD 4510
 PO BOX 159 CABOOLTURE QLD 4510
 Telephone: (07) 5433 0100
 Fax: (07) 5433 4000

OW NUMBER TBC
 STAGES 1A & 1B LILYWOOD LANDINGS
 AS CONSTRUCTED
 STORMWATER DRAINAGE

| MBRC SUBDIVISION REFERENCE | |
|----------------------------|------|
| DA/---/--- | |
| No. 1 OF 3 PLANS | REV. |
| DRAWING NUMBER | |
| 401871-1A-1B-ASW01 | C |

ENGINEER'S CERTIFICATION

I, _____ being a Certified/Registered Engineer and
 (Engineer's Name)
 duly authorised representative of EGIS CONSULTING P/L
 (Consulting firm or company)

Hereby:-

- certify the information contained in this drawing/file is an accurate "as constructed" representation of the works;
- accept responsibility for the "as constructed" information contained in this drawing/file; and
- acknowledge the "as constructed" information contained in this drawing/file may be relied on by the Council and others.


Certification for Stages 1A & 1B by _____ on _____
 (Stage No) (Signature) (Date)

for EGIS CONSULTING P/L
 (Company Name)
 Registered Professional Engineering Company of Queensland
 (Number)

REGISTERED SURVEYOR'S CERTIFICATION

We, VERIS AUSTRALIA PTY. LTD., hereby certify that the vertical and horizontal locations and dimensions shown on this plan are a true and correct record and were located by survey.

Delegate Cadastral Surveyor (sig) Reg. Surveyor No. 6448 Date: _____

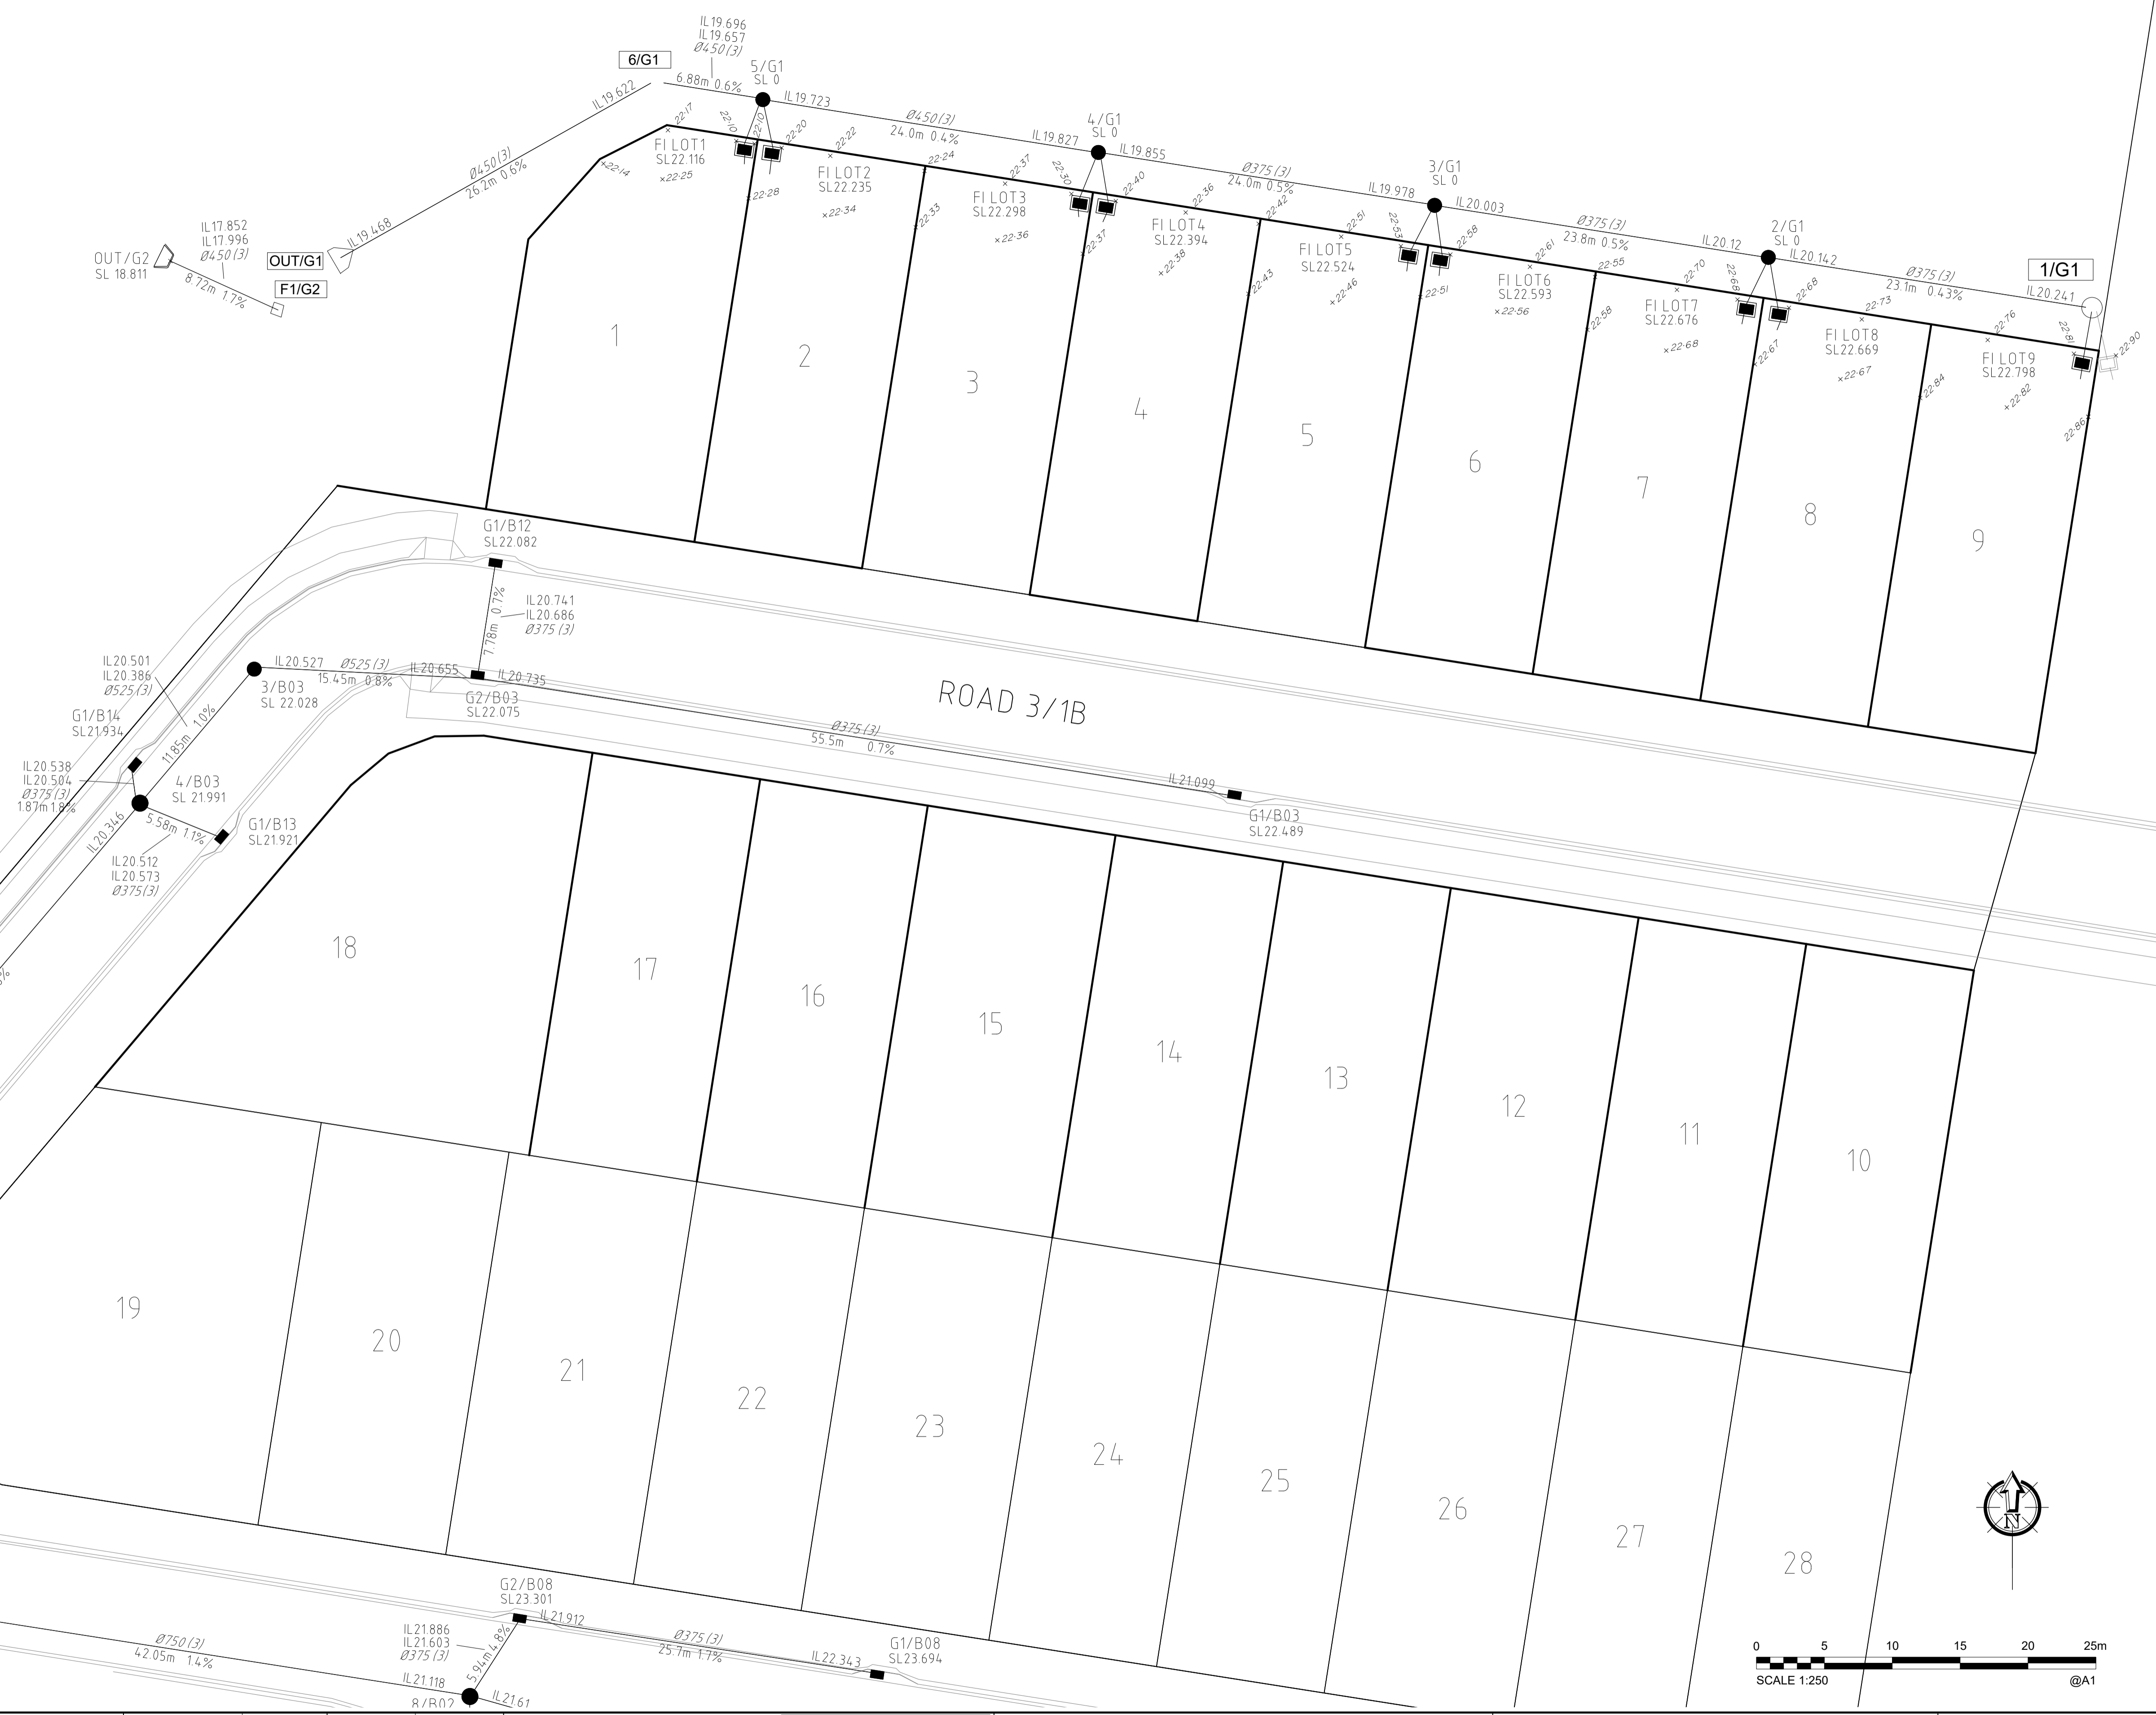


1004

| REV. | REVISION DESCRIPTION | DATE |
|------|----------------------|------------|
| A | PROGRESSES PLOT | 16/12/2024 |
| B | PROGRESSES PLOT | 28/01/2025 |
| C | PROGRESSES PLOT | 07/02/2025 |

| REFERENCE DRAWINGS | DESCRIPTION |
|--------------------|-------------|
| | |

| DESIGN FILE No. | DESIGNED DATE | DESIGNED BY |
|-----------------|---------------|-------------|
| | | JMc |
| SURVEY FILE No. | DRAWN DATE | DRAWN BY |
| | 16/12/2024 | |
| FIELD BOOK | CHECKED DATE | CHECKED BY |
| | | |
| LOG BOOK | DATE | DATE |
| | | |
| LEVEL DATUM | DATUM | DATUM |
| | AHD | |

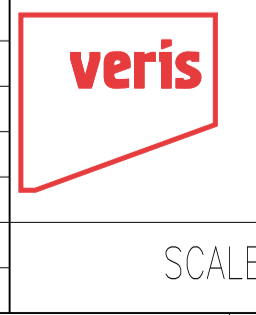

BRISBANE (07) 3666 4700
 MACKAY (07) 4957 9100
 WHITSUNDAYS (07) 4943 6600
 CAIRNS (07) 4252 9400
 veris.com.au
 ACN 815 735 727
 Veris Australia Pty Ltd



MORETON BAY REGIONAL COUNCIL
 CABOOLTURE DISTRICT OFFICE
 2 HASKING STREET CABOOLTURE QLD 4510
 Telephone: (07) 5433 0100
 Fax: (07) 5433 4000

OW NUMBER TBC
 STAGES 1A & 1B LILYWOOD LANDINGS
 AS CONSTRUCTED
 STORMWATER DRAINAGE

| MBRC SUBDIVISION REFERENCE | |
|----------------------------|------|
| DA/---/--- | |
| No. 2 OF 3 PLANS | |
| DRAWING NUMBER | REV. |
| 401871-1A-1B-ASW01 | C |

SCALE 1:250 ORIGINAL SIZE A1

