


COORDINATE DATUM NOTE:
 HORIZONTAL COORDINATES(E,N) SUPPLIED ARE MAPPING GRID OF AUSTRALIA(MGA),
 ZONE 56 BASED ON THE UNIVERSAL TRANSVERSE MERCATOR PROJECTION AND THE
 GEOCENTRIC DATUM OF AUSTRALIA 1994.
 HORIZONTAL DATUM DERIVED FROM PM33280, E 492232.092, N 7002357.242.
 LEVELS SUPPLIED ARE ON THE AUSTRALIAN HEIGHT DATUM(AHD)
 LEVEL DATUM DERIVED FROM PSM108673 RL 17.338 (AHD)


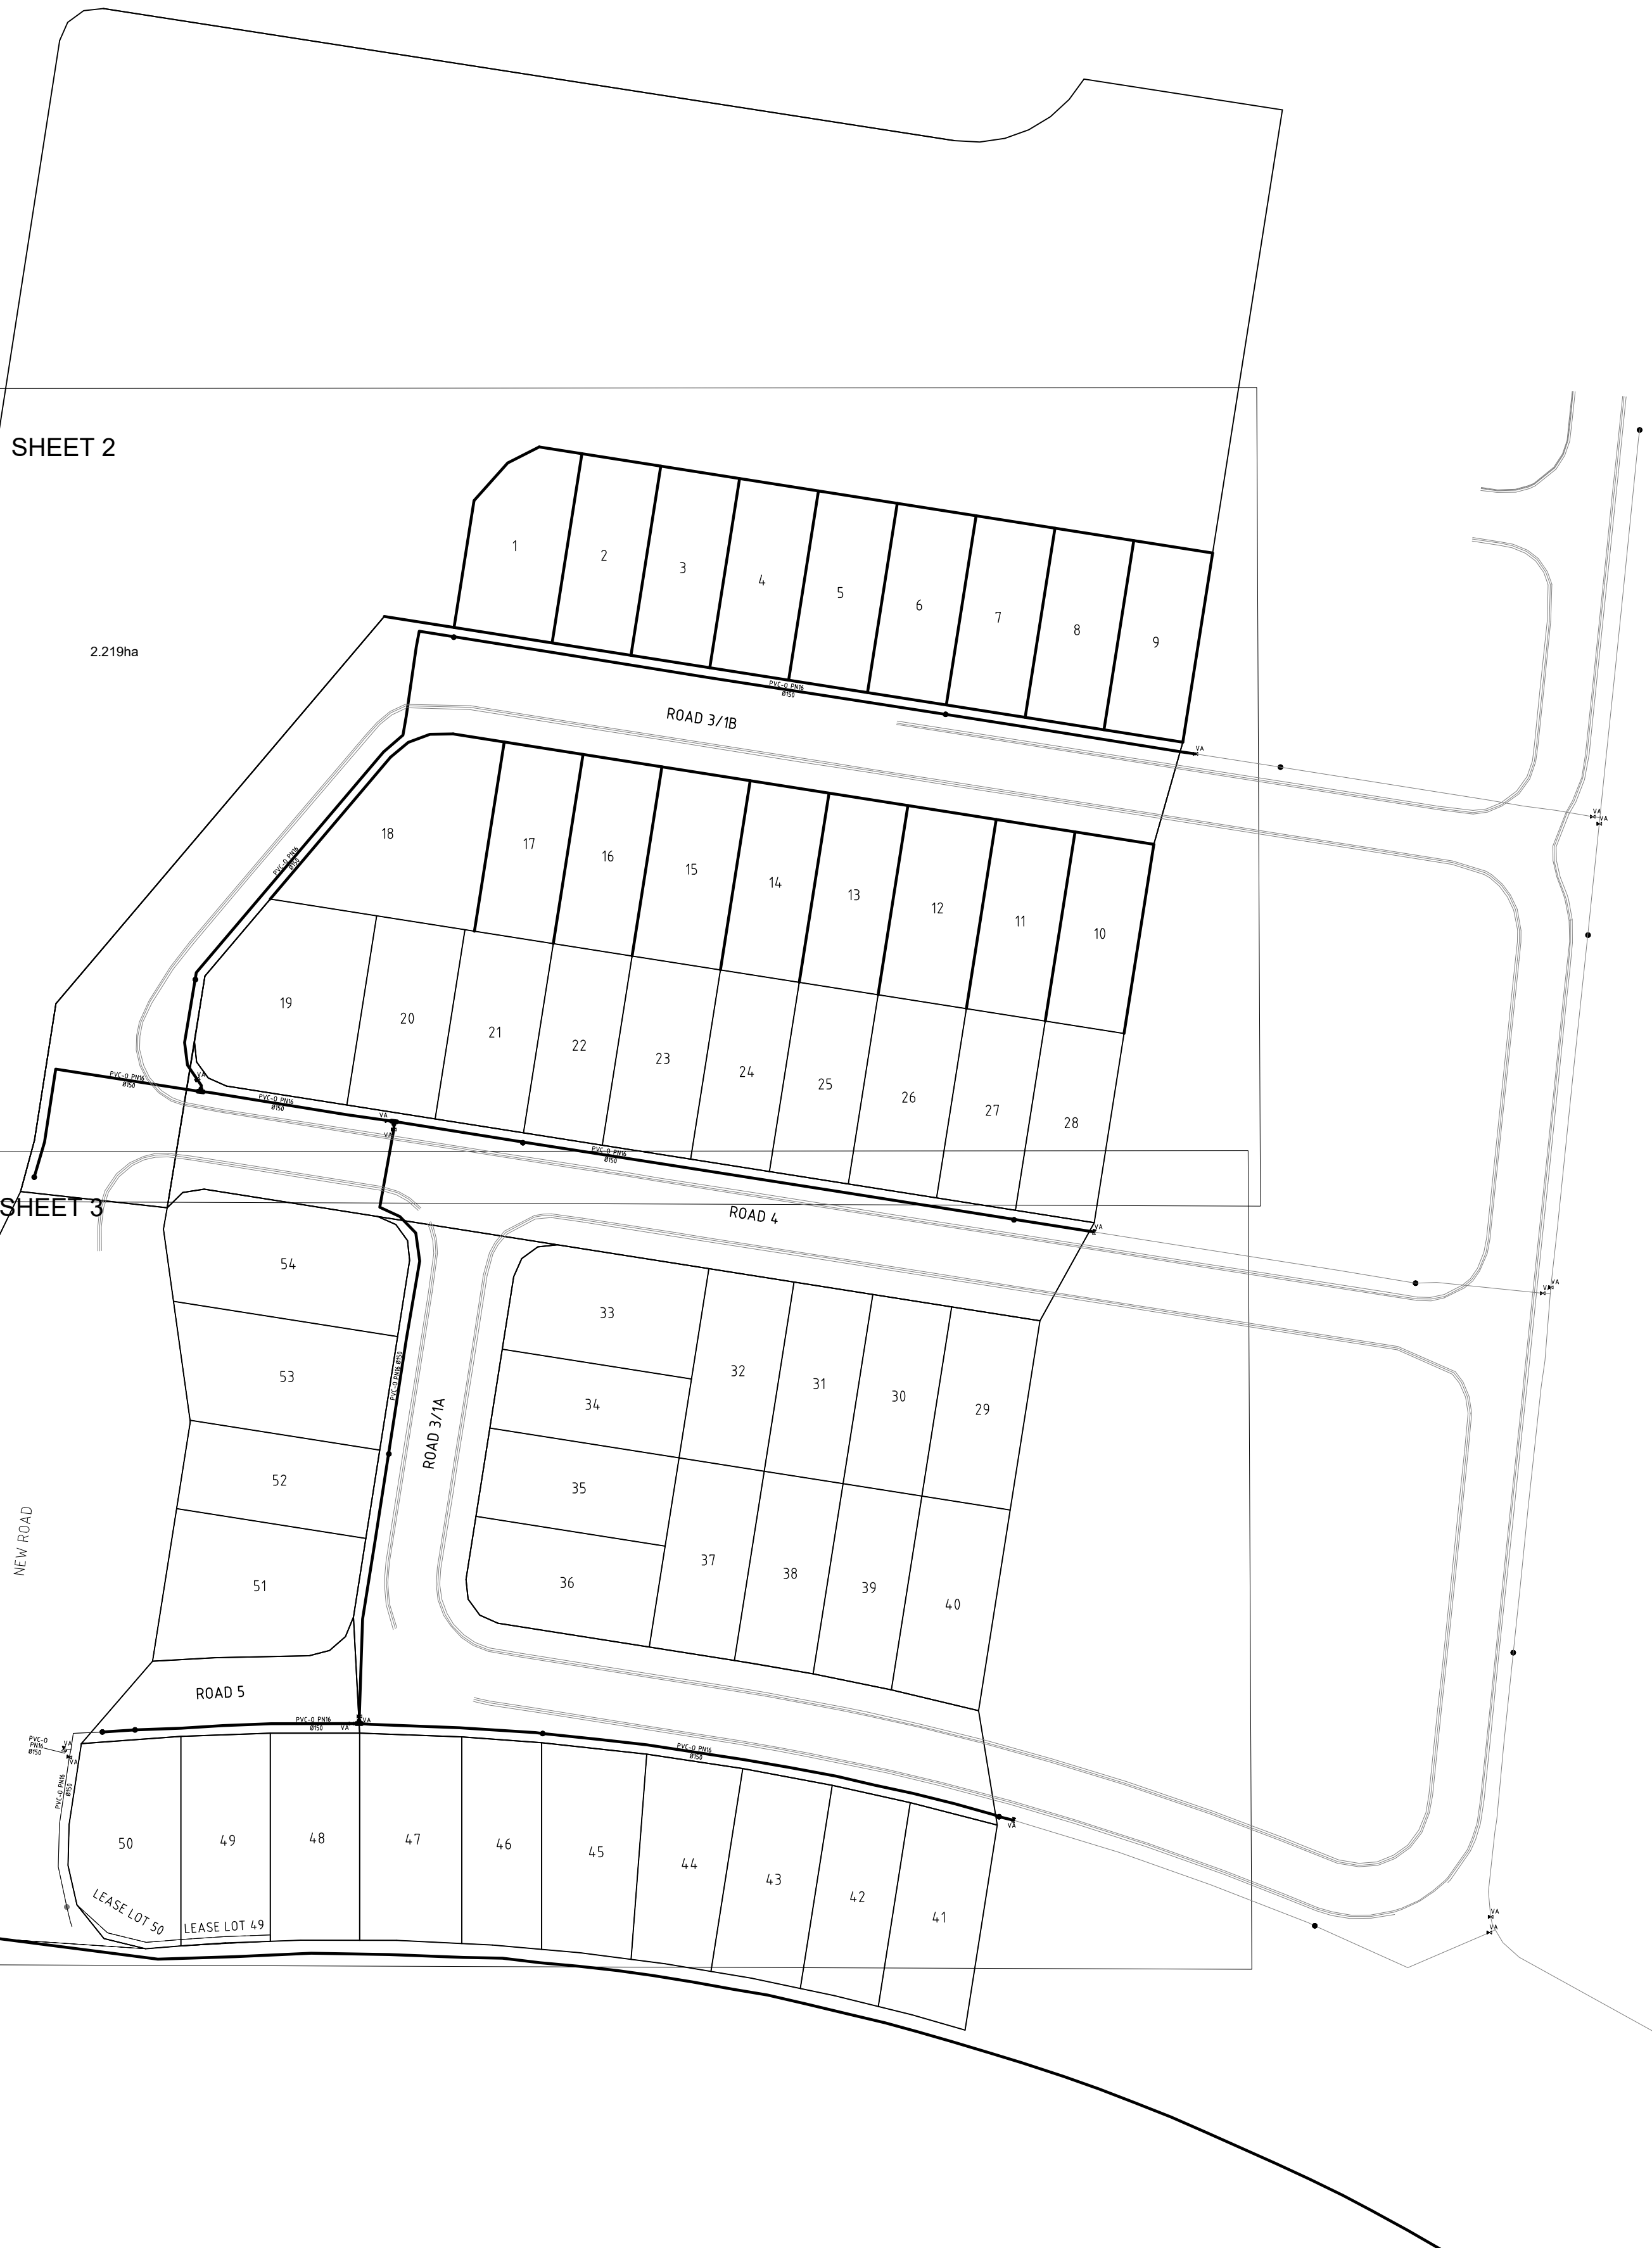


SHEET 2

SHEET 3

Registered Surveyor's Certification
 We, VERIS AUSTRALIA P/L, hereby certify that the horizontal and vertical locations,
 and dimensions shown on this plan are a true and correct record of the As Constructed
 information.
 Signed: _____ Cadastrial Surveyor Reg No 8648 & Delegate
 Dated: _____

ENGINEER'S CERTIFICATION
 I, _____ hereby certify that:
 1. The information contained in this drawing / document is in compliance with approved drawings and design.
 2. The new water and sewerage works defined by this drawing have been designed and constructed in accordance with the SEQ Code.
 3. This represents an accurate record of as-constructed works.
 4. I accept responsibility for the information contained in this drawing / document.
 RPEQ (signature) RPEQ No. _____ Date: _____

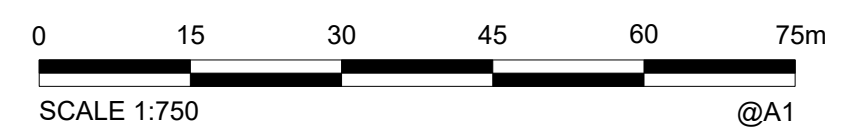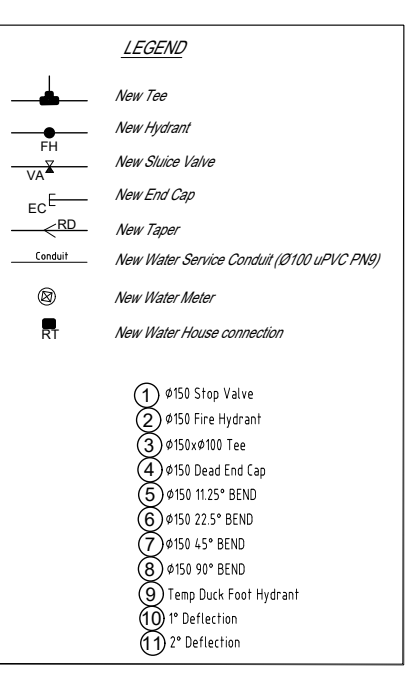

AS CONSTRUCTED

A1	B	26/09/2024	PROGRESS PLOT	JMc			DRAWN	JMc	09/05/2024
	A	09/05/2024	PROGRESS PLOT	JMc			CHECKED		
				REVISIONS			DRAWN	CHECKED	PASSED
	INDEX	DATE		REVISIONS	DRAWN	CHECKED	PASSED	INITIALS	DATE

CONSULTING SURVEYOR
veris
 BRISBANE WHITSUNDAYS
 (07) 3666 4700 (07) 4945 6600
 MACKAY CAIRNS
 (07) 4907 9700 (07) 4252 3400
 veris.com.au
 ACN 615 735 727
 Veris Australia Pty Ltd

egis
 © 2023 Egis Consulting Pty Ltd
 www.egis-group.com


Unitywater

Unitywater
 DW NUMBER TBC
 LILYWOOD LANDINGS
 STAGES 1A & 1B
 AS CONSTRUCTED WATER

SHEET 1 OF 3 SHEETS	SCALE 1:750
REVISION DATE 26/09/2024	REVISION B
DISCIPLINE CODE C	
DRAWING NO.	4-01871-1A-1B-AW01-B

COORDINATE DATUM NOTE:
 HORIZONTAL COORDINATES(E,N) SUPPLIED ARE MAPPING GRID OF AUSTRALIA(MGA),
 ZONE 56 BASED ON THE UNIVERSAL TRANSVERSE MERCATOR PROJECTION AND THE
 GEOCENTRIC DATUM OF AUSTRALIA 1994.
 HORIZONTAL DATUM DERIVED FROM PM33280, E 492232.092, N 7002357.242.
 LEVELS SUPPLIED ARE ON THE AUSTRALIAN HEIGHT DATUM(AHD)
 LEVEL DATUM DERIVED FROM PSM108673 RL 17.338 (AHD)

2.219ha

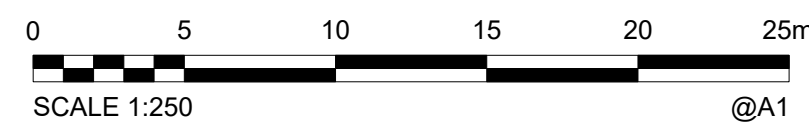

ENGINEER'S CERTIFICATION

I, _____ hereby certify that:
 1. The information contained in this drawing / document is in compliance with approved drawings and design.
 2. The new water and sewerage works defined by this drawing have been designed and constructed in accordance with the SEQ Code.
 3. This represents an accurate record of as-constructed works.
 4. I accept responsibility for the information contained in this drawing / document.


RPEQ (signature) RPEQ No. _____ Date: _____

Registered Surveyor's Certification

We, VERIS AUSTRALIA PTY LTD, hereby certify that the horizontal and vertical locations, and dimensions shown on this plan are a true and correct record of the As Constructed information.

Signed: _____ Cadellina
 Surveyor Reg No. 6448
 & Delegate

Dated: _____

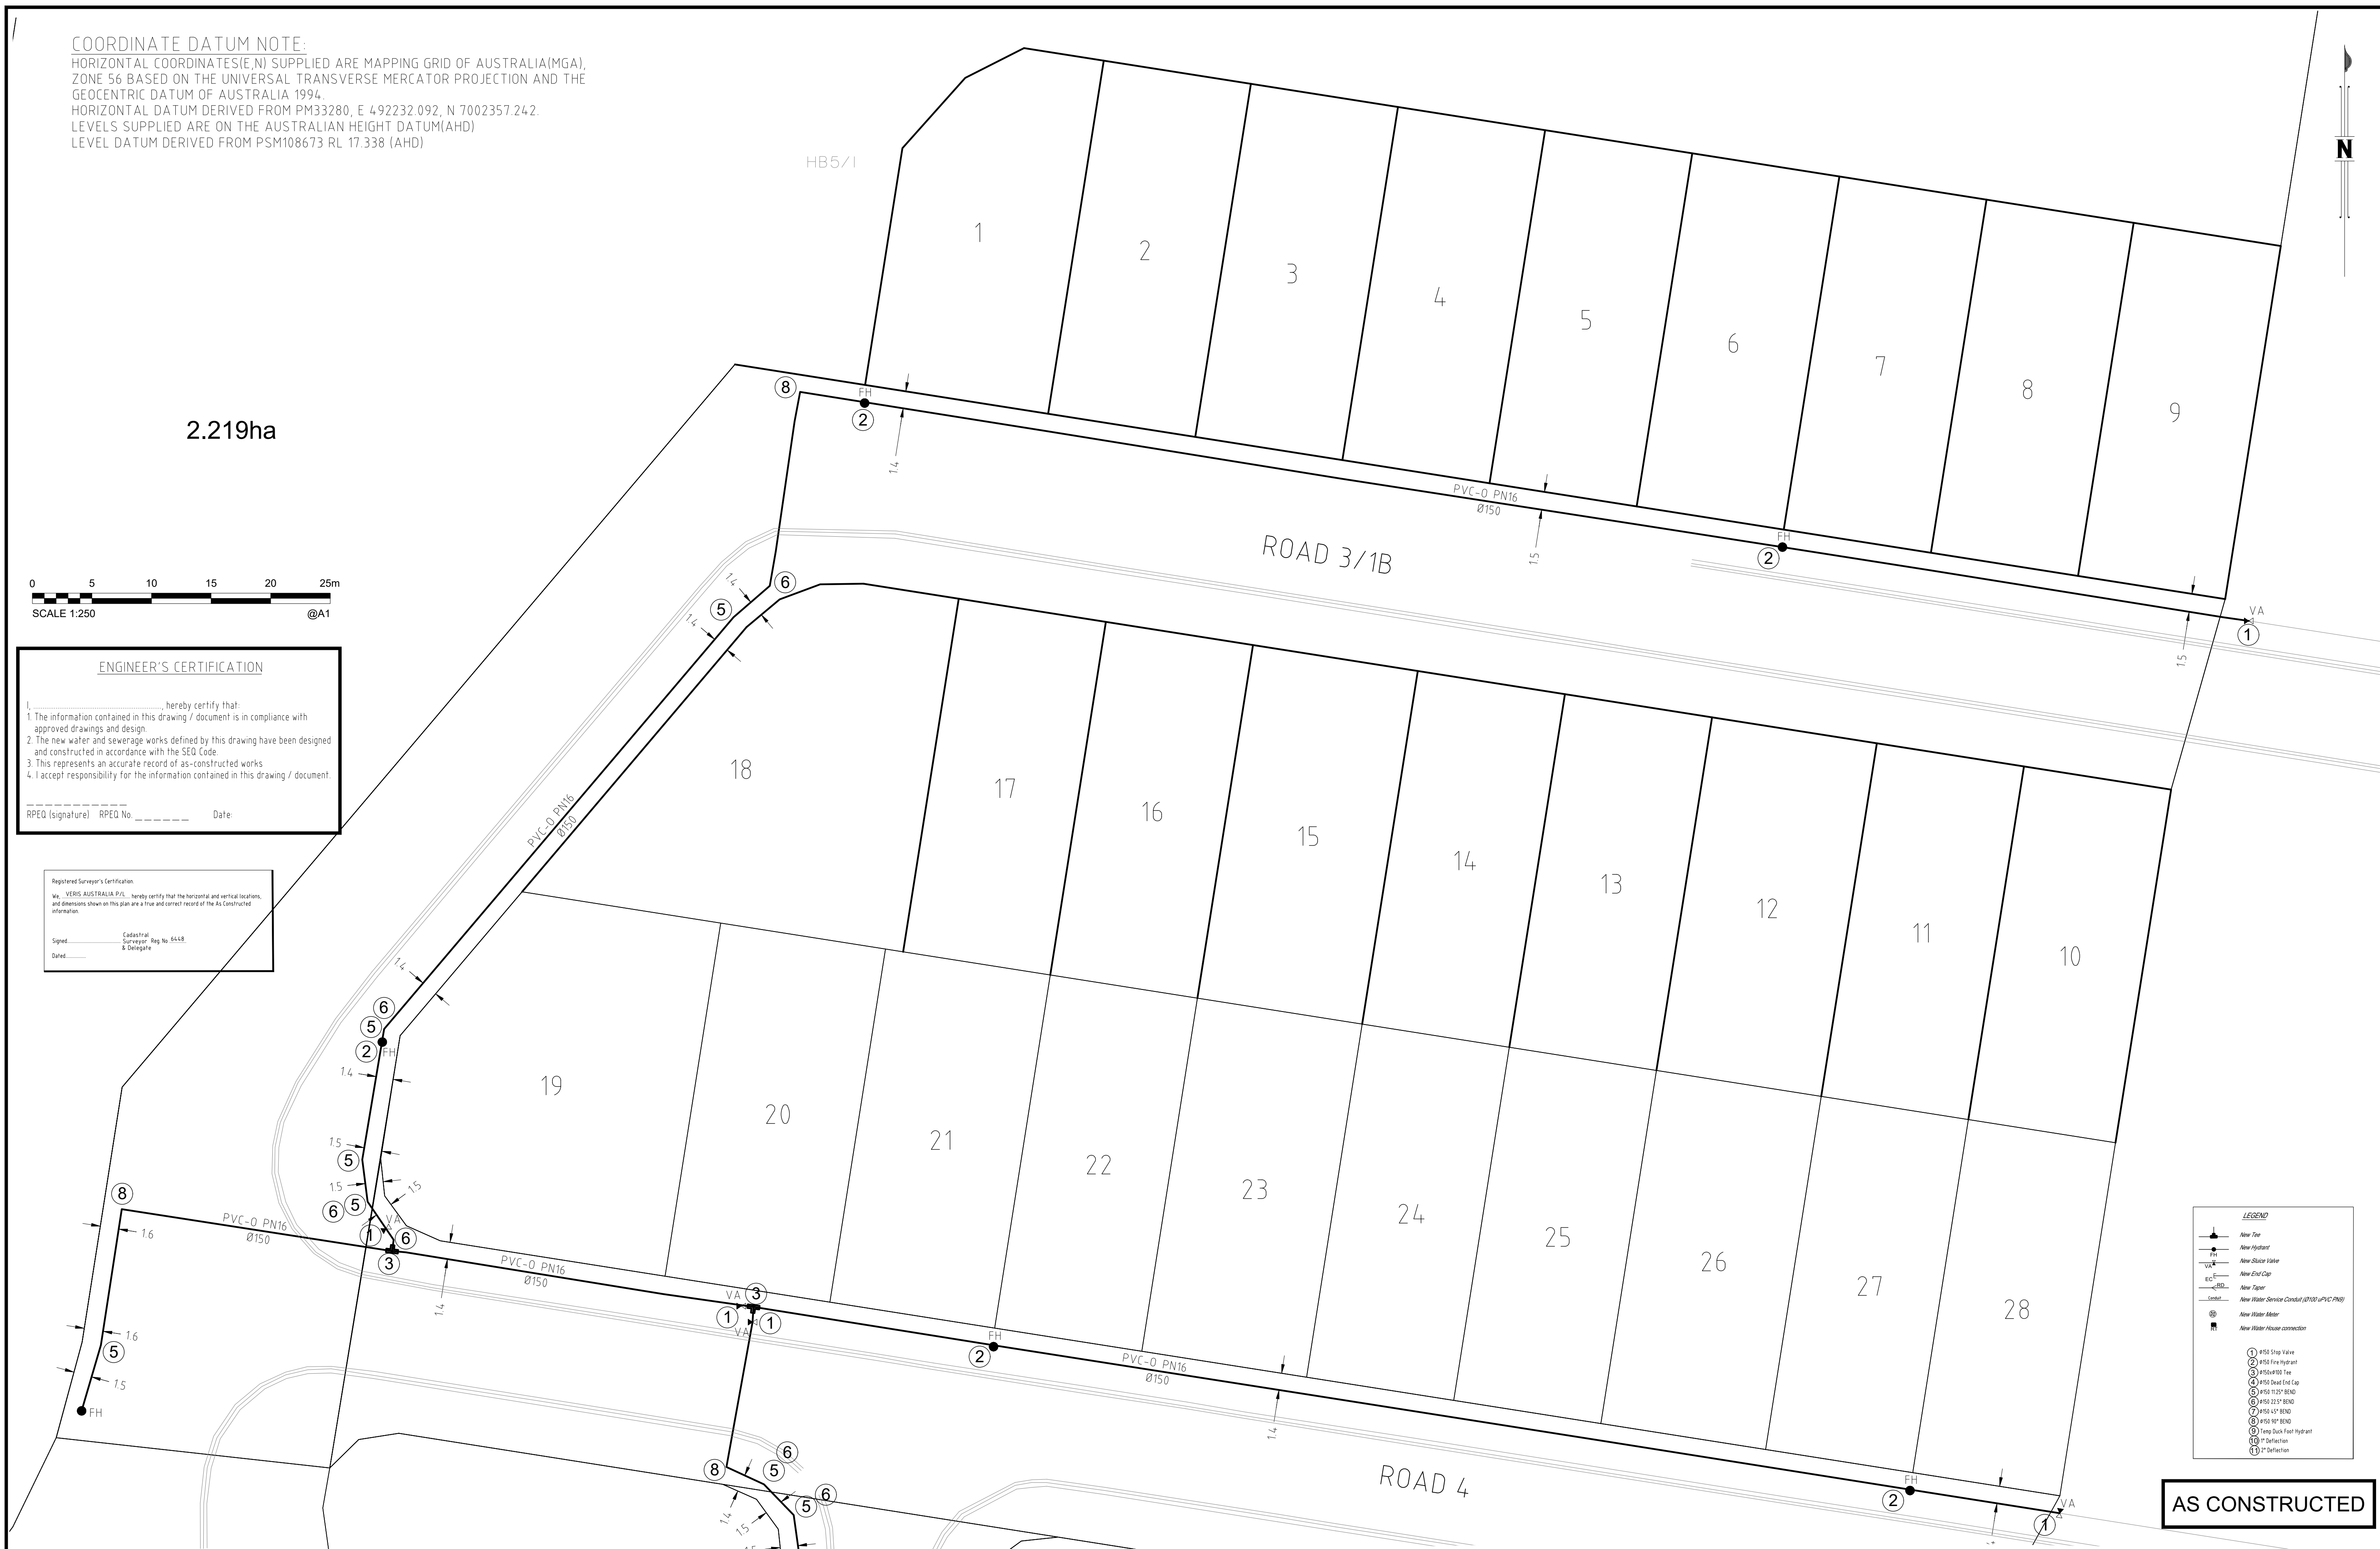

LEGEND

- ▲ New Valve
- New Hydrant
- New Sluice Valve
- New End Cap
- New Tee
- New Water Service Connection (Ø100 uPVC PR9)
- New Water Meter
- New Water Meter connection

- ① Ø150 Stop Valve
- ② Ø150 Fire Hydrant
- ③ Ø150xØ100 Tee
- ④ Ø150 Dual End Cap
- ⑤ Ø150 115° BEND
- ⑥ Ø150 22.5° BEND
- ⑦ Ø150 45° BEND
- ⑧ Ø150 90° BEND
- ⑨ 1500mm Deep Hydrant
- ⑩ 150mm Deflection
- ⑪ 150mm Deflection

AS CONSTRUCTED

A1	B	26/09/2024	PROGRESS PLOT	JMc	DRAWN	JMc	09/05/2024
	A	09/05/2024	PROGRESS PLOT	JMc	CHECKED		
	INDEX		DATE	REVISIONS	DRAWN	CHECKED	PASSED

CONSULTING SURVEYOR
veris
 BRISBANE WHITSUNDAYS
 (07) 3956 4700 (07) 4644 9900
 MACKAY CAIRNS
 (07) 4957 9700 (07) 4252 9400
 veris.com.au
 ACN 615 735 727
 Veris Australia Pty Ltd

egis
 © 2023 Egis Consulting Pty Ltd
 www.egis-group.com

Unitywater

Unitywater
 DW NUMBER TBC
 LILYWOOD LANDINGS
 STAGES 1A & 1B
 AS CONSTRUCTED WATER

SHEET 2 OF 3 SHEETS	SCALE 1:250
REVISION DATE 26/09/2024	REVISION B
DISCIPLINE CODE C	
DRAWING NO. 401871-1A-1B-AW01-B	

