


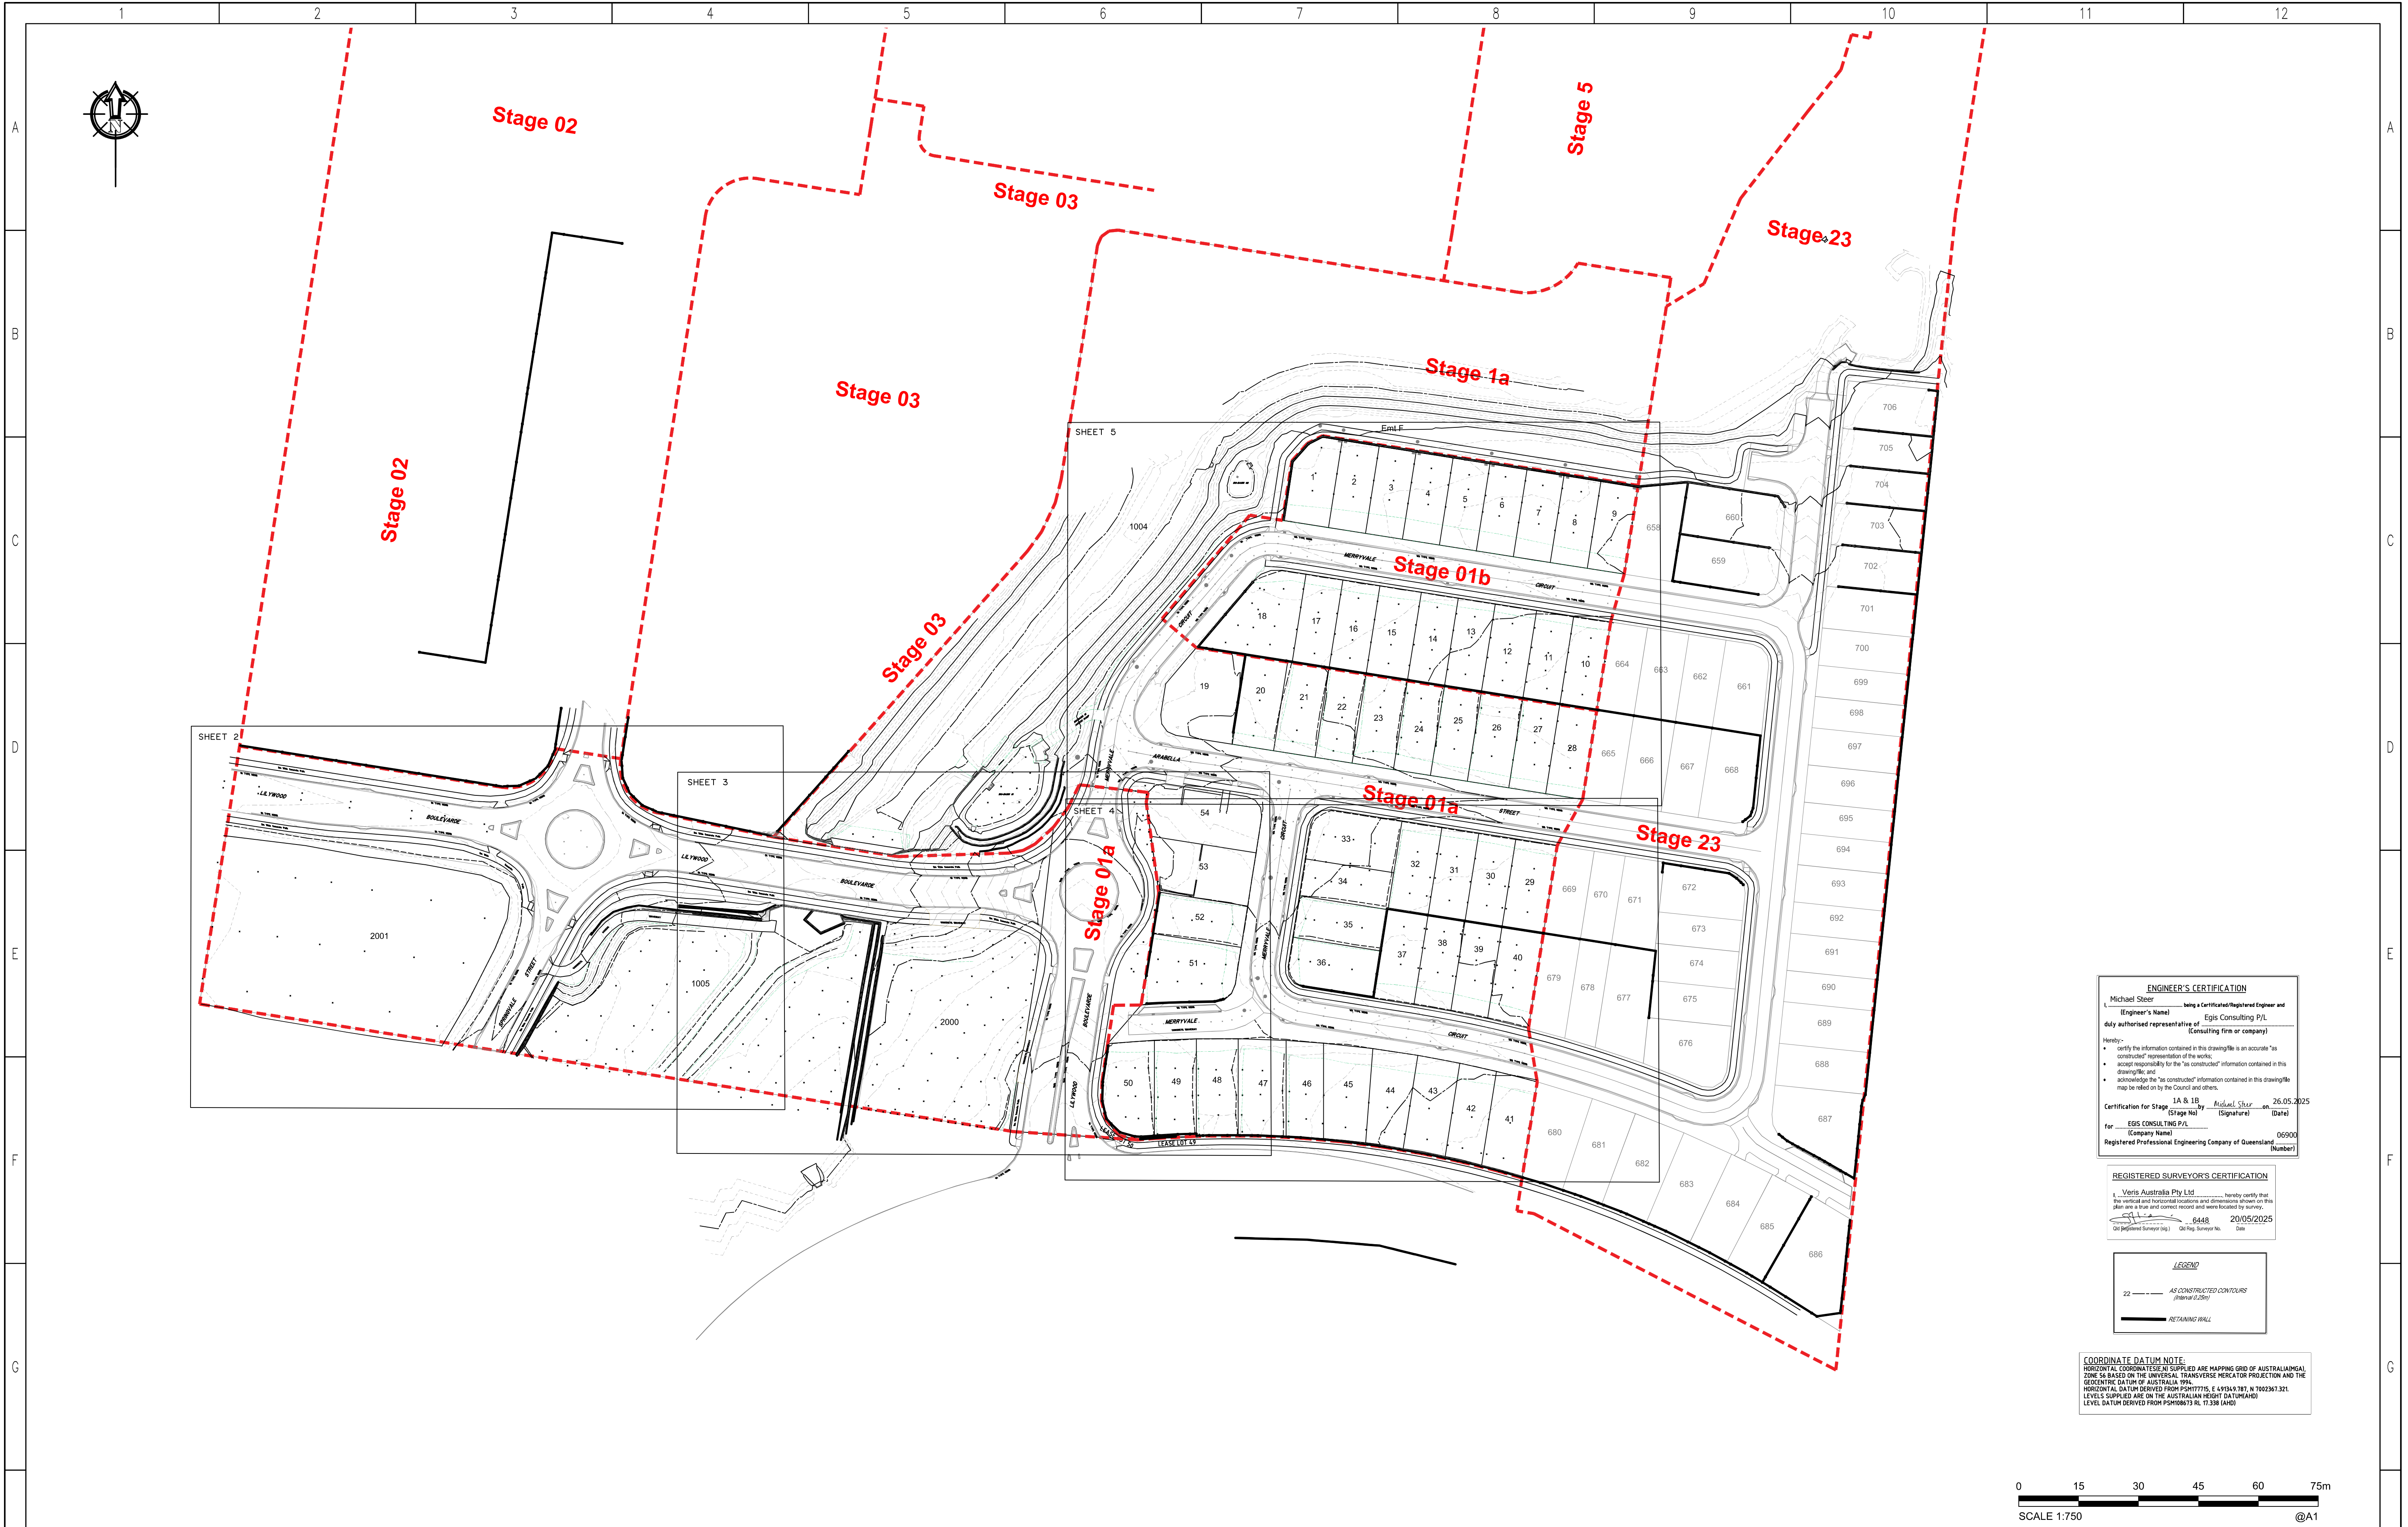

ENGINEER'S CERTIFICATION
Michael Steel (Engineer's Name) being a Certified/Registered Engineer and duly authorised representative of Egis Consulting P/L (Consulting firm or company)
Hereby:
• certify the information contained in this drawing/plan is an accurate "as constructed" representation of the works;
• accept responsibility for the "as constructed" information contained in this drawing/plan; and
• acknowledge the "as constructed" information contained in this drawing/plan may be relied on by the Council and others.
Certification for Stage 1A & 1B by Michael Steel on 26.05.2025
for EGIS CONSULTING P/L (Company Name) 06900 (Number)
Registered Professional Engineering Company of Queensland

REGISTERED SURVEYOR'S CERTIFICATION
I, Veris Australia Pty Ltd, hereby certify that the vertical and horizontal locations and dimensions shown on this plan are a true and correct record and were located by survey.
6448 20/05/2025
Dr [Signature] (Dr [Signature], Surveyor No. [Number])

LEGEND
22 ——— AS CONSTRUCTED CONTOURS (Interval 0.25m)
————— RETAINING WALL

COORDINATE DATUM NOTE:
HORIZONTAL COORDINATES AS SUPPLIED ARE MAPPING GRID OF AUSTRALIA (MGA), ZONE 54, BASED ON THE UNIVERSAL TRANSVERSE MERCATOR PROJECTION AND THE GEODETIC DATUM OF AUSTRALIA 1994.
HORIZONTAL DATUM DERIVED FROM PSAD77715, E 49363.197, N 7822361.321.
LEVELS SUPPLIED ARE ON THE AUSTRALIAN HEIGHT DATUM (AHD).
LEVEL DATUM DERIVED FROM PSIGN9673 RL 71.338 (AHD).


DRAWING REVISIONS		REFERENCE DRAWINGS		DESIGN FILE No.	DESIGNED
REV.	REVISION DESCRIPTION	DESCRIPTION		CONSTRUCT. No.	DATE
A	ORIGINAL 25/02/2025			SURVEY FILE No. R01871-1A-1B-AEW01	JMc
B	PROGRESS 25/03/2025			FIELD BOOK	DATE 25/02/2025
C	PROGRESS 07/05/2025	ADD 2 SHEETS. INCLUDE 2000, 2001 & 1005		LOG BOOK	CHECKED
				LEVEL DATUM	AHD
				DATUM	

CONSULTING SURVEYOR
BRISBANE (07) 3696 4700
MACKAY (07) 4907 9700
veris.com.au
ACN 615 735 727
Veris Australia Pty Ltd

© 2023 Egis Consulting Pty Ltd
www.egis-group.com

MORETON BAY REGIONAL COUNCIL
CABOOLTURE DISTRICT OFFICE
2 HASKING STREET CABOOLTURE QLD 4510
PO BOX 159 CABOOLTURE QLD 4510
Telephone: (07) 5433 0100
Fax: (07) 5433 4000

OW NUMBER TBC STAGES 1A & 1B LILYWOOD LANDINGS AS CONSTRUCTED EARTHWORKS		MBRC SUBDIVISION REFERENCE DA/2021/4669 No. 1 OF 5 PLANS DRAWING NUMBER 401871-1A-1B-AEW01-C		REV. C
---	--	--	--	-----------

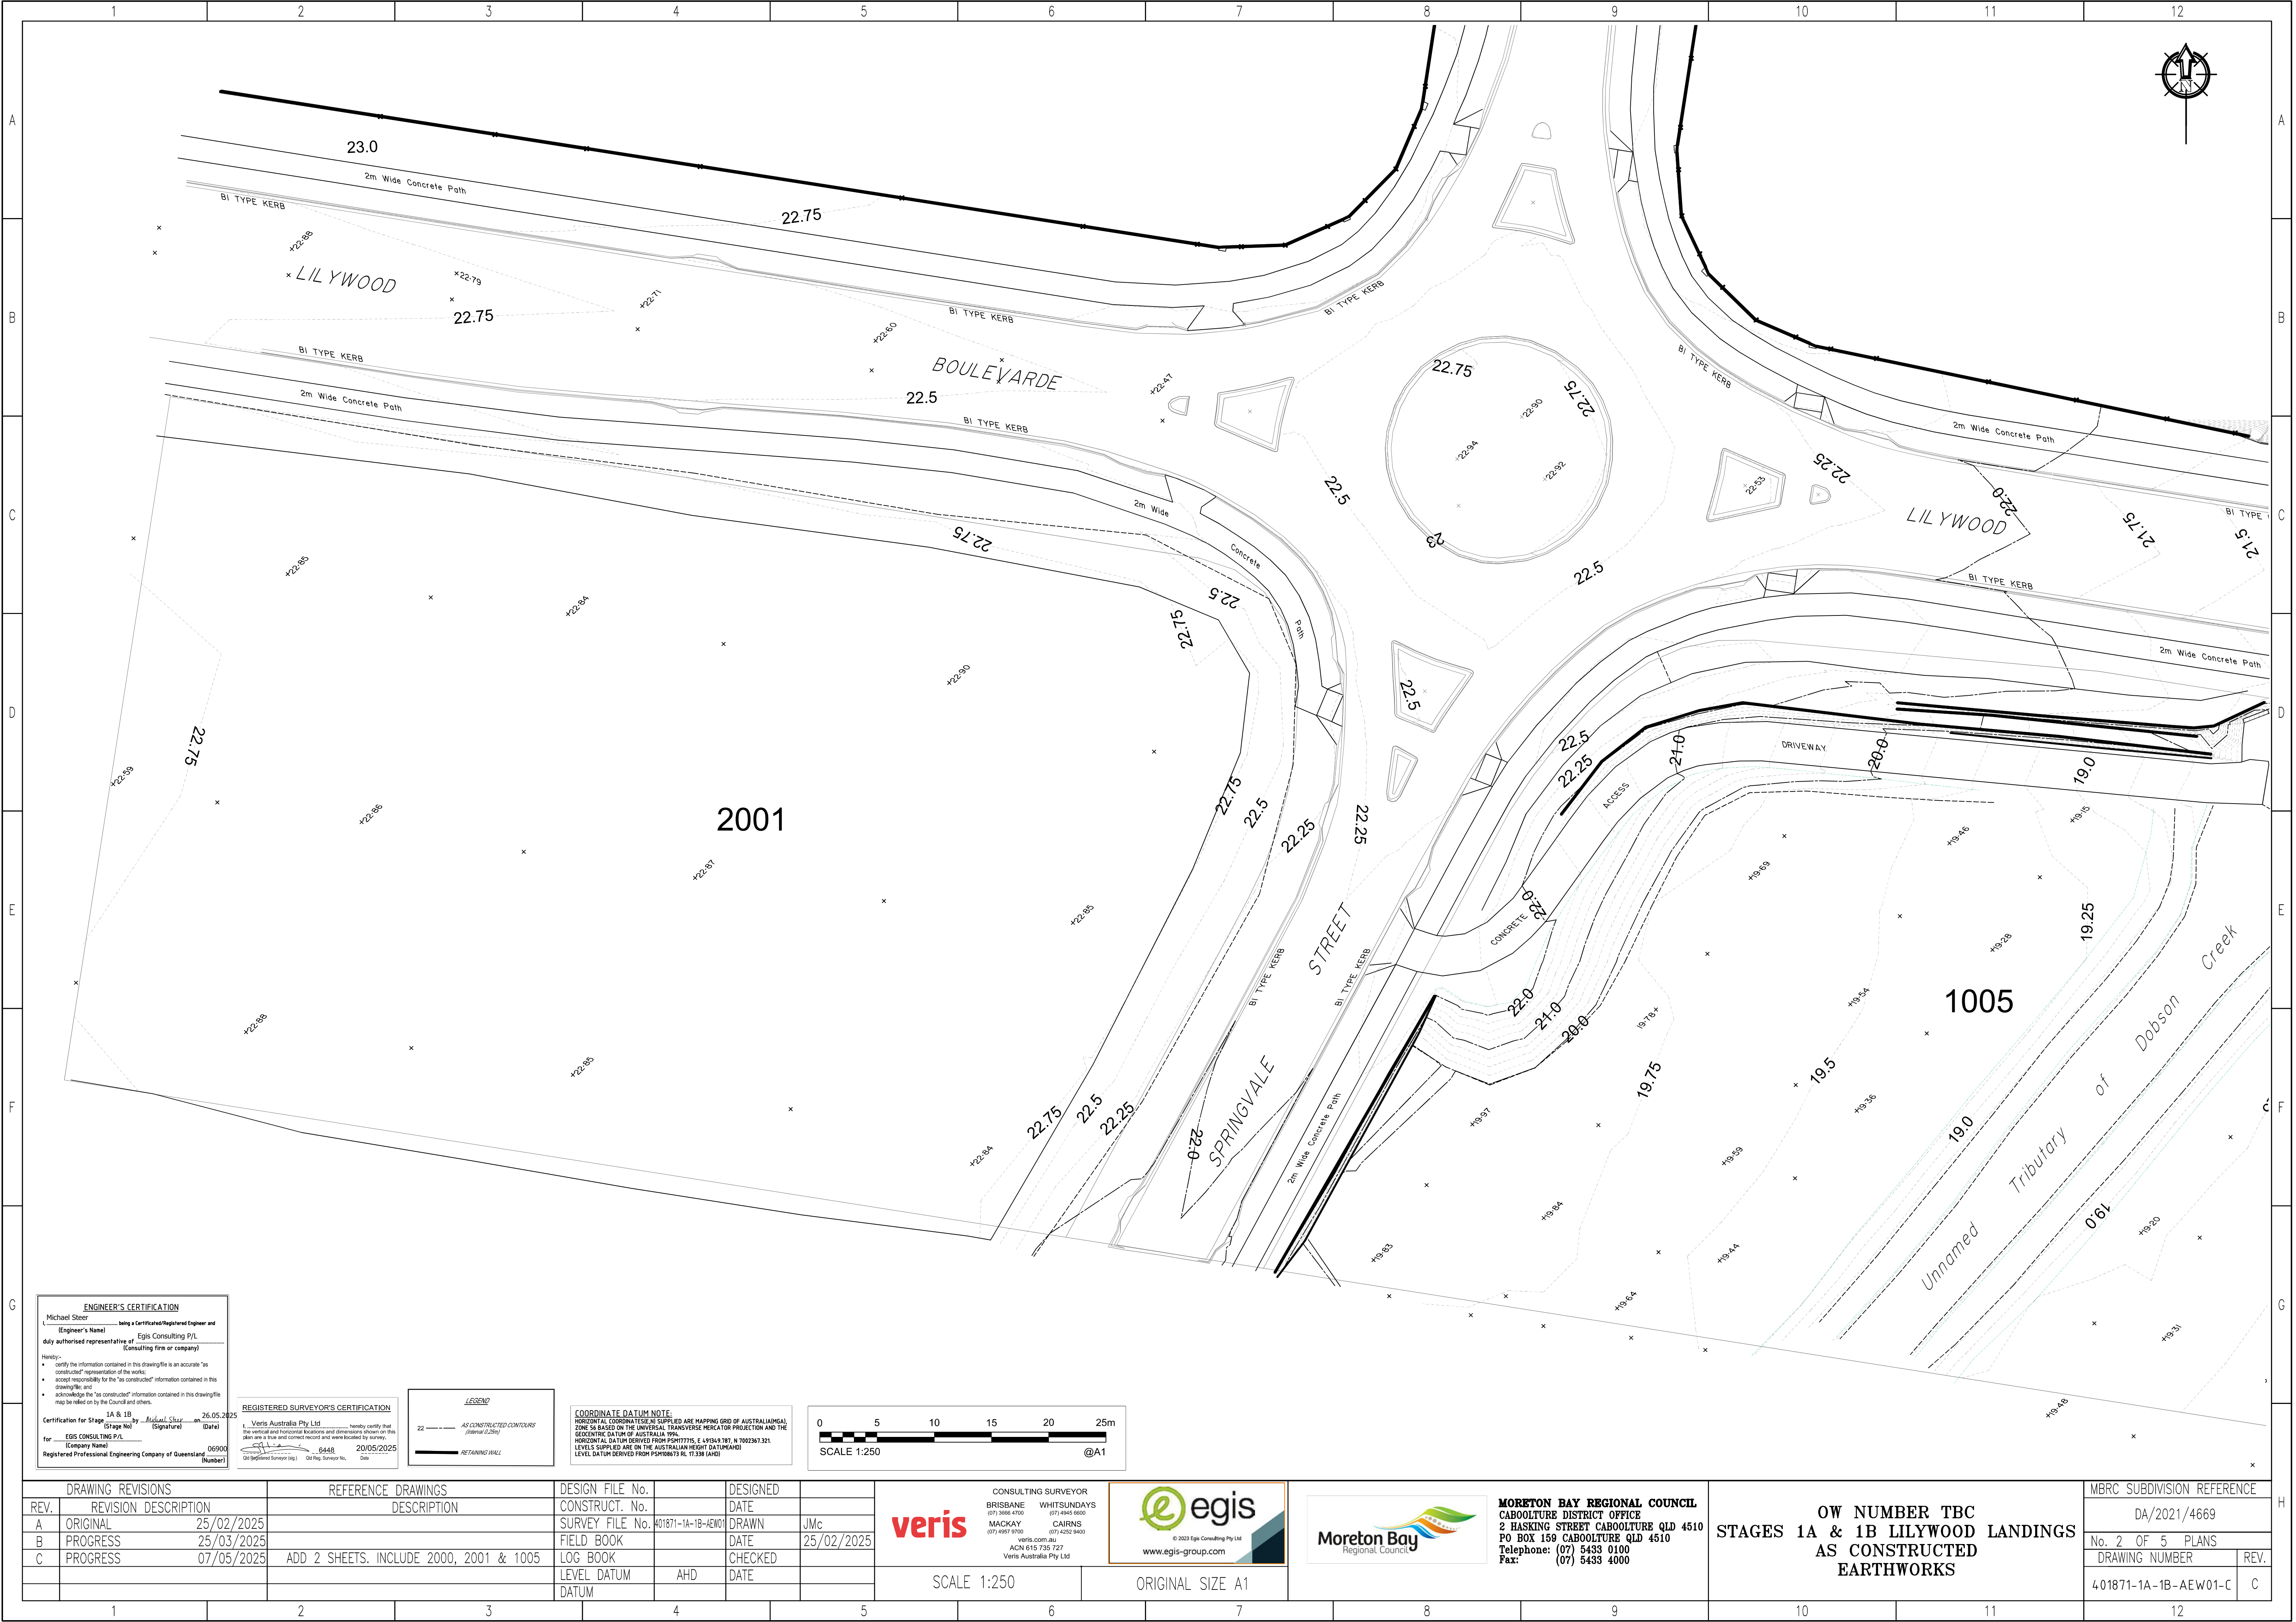


ENGINEER'S CERTIFICATION
Michael Steer being a Certified/Registered Engineer and
(Engineer's Name)
duly authorised representative of Egis Consulting P/L
(Consulting firm or company)
I hereby:
• certify the information contained in this drawing is an accurate "as constructed" representation of the works;
• accept responsibility for the "as constructed" information contained in this drawing; and
• acknowledge the "as constructed" information contained in this drawing may be relied on by the Council and others.
Certification for Stage 1A & 1B by Michael Steer on 26/05/2025
(Signature) (Date)
for Egis Consulting P/L
(Company Name)
Registered Professional Engineering Company of Queensland
(Number) 06900

REGISTERED SURVEYOR'S CERTIFICATION
Veris Australia Pty Ltd hereby certify that
the vertical and horizontal locations and dimensions shown on this
plan are a true and correct record and were located by survey.
Date 20/05/2025
Qld Registered Surveyor (No.) 6448 Qld Reg. Surveyor No. Date

LEGEND
--- AS CONSTRUCTED CONTOURS
(internal 0.20m)
--- RETAINING WALL

COORDINATE DATUM NOTE:
HORIZONTAL COORDINATES SUPPLIED ARE MAPPROJ GRID OF AUSTRALIA (MGA)
ZONE 56 BASED ON THE UNIVERSAL TRANSVERSE MERCATOR PROJECTION AND THE
GEODETIC DATUM OF AUSTRALIA 1994.
HORIZONTAL DATUM DERIVED FROM GDA2011, E 491347.787, N 706267.321
LEVELS SUPPLIED ARE ON THE AUSTRALIAN HEIGHT DATUM (AHD)
LEVEL DATUM DERIVED FROM PORTSMOUTH RL 17.33M (AHD)

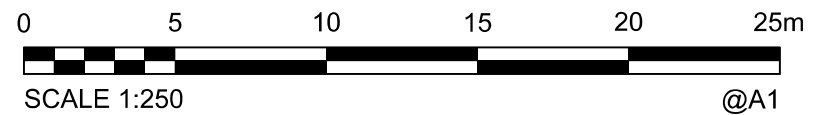

DRAWING REVISIONS		REFERENCE DRAWINGS		DESIGN FILE No.		DESIGNED	
REV.	REVISION DESCRIPTION	DESCRIPTION		CONSTRUCT. No.		DATE	
A	ORIGINAL 25/02/2025			SURVEY FILE No. R01871-1A-1B-AEW01		DRAWN JMc	
B	PROGRESS 25/03/2025			FIELD BOOK		DATE 25/02/2025	
C	PROGRESS 07/05/2025	ADD 2 SHEETS. INCLUDE 2000, 2001 & 1005		LOG BOOK		CHECKED	
				LEVEL DATUM AHD		DATE	
				DATUM			

veris

CONSULTING SURVEYOR
BRISBANE WHITSUNDAYS
(07) 3666 4700 (07) 4945 6600
MACKAY CAIRNS
(07) 4927 2010 (07) 4202 9400
veris.com.au
ACN 615 735 727
Veris Australia Pty Ltd



MORETON BAY REGIONAL COUNCIL
CABOOLTURE DISTRICT OFFICE
2 HASKING STREET CABOOLTURE QLD 4510
PO BOX 159 CABOOLTURE QLD 4510
Telephone: (07) 5433 0100
Fax: (07) 5433 4000

OW NUMBER TBC
STAGES 1A & 1B LILYWOOD LANDINGS
AS CONSTRUCTED
EARTHWORKS

MBRC SUBDIVISION REFERENCE	
DA/2021/4669	
No. 2 OF 5 PLANS	
DRAWING NUMBER	REV.
401871-1A-1B-AEW01-C	C



ENGINEER'S CERTIFICATION
I, Michael Steer, being a Certified/Registered Engineer and
(Engineer's Name)
duly authorised representative of
(Consulting firm or company)
Hereby:
• certify the information contained in this drawing is an accurate 'as
constructed' representation of the works;
• accept responsibility for the 'as constructed' information contained in this
drawing; and
• acknowledge the 'as constructed' information contained in this drawing
may be relied on by the Council and others.
Certification for Stage 1A & 1B on 26.05.2025
(Stage No) (Signature) (Date)
for EGIS CONSULTING P/L
(Company Name)
Registered Professional Engineering Company of Queensland 06900
(Number)

REGISTERED SURVEYOR'S CERTIFICATION
I, Veris Australia Pty Ltd, hereby certify that
the vertical and horizontal positions and dimensions shown on this
plan are a true and correct record and were located by survey.
Veris Australia Pty Ltd 6448 20/05/2025
(Company Name) (Date)
Registered Professional Surveyor (No.) Qld Reg. Surveyor No.

LEGEND
22 --- AS CONSTRUCTED CONTOURS
(Interval 0.20m)
--- RETAINING WALL

COORDINATE DATUM NOTE:
HORIZONTAL COORDINATES ARE SUPPLIED ARE MAPPING GRID OF AUSTRALIAN MAP
ZONE 56 BASED ON THE UNIVERSAL TRANSVERSE MERCATOR PROJECTION AND THE
GEODETIC DATUM OF AUSTRALIA 1994.
HORIZONTAL DATUM DERIVED FROM PSAD1971, E 49154.787, N 7002367.321
LEVEL DATUM DERIVED FROM PSAD1971, E 49154.787, N 7002367.321
LEVEL DATUM DERIVED FROM PSAD1971, E 49154.787, N 7002367.321

0 5 10 15 20 25m
SCALE 1:250 @A1

DRAWING REVISIONS		REFERENCE DRAWINGS		DESIGN FILE No.		DESIGNED	
REV.	REVISION DESCRIPTION	DESCRIPTION		CONSTRUCT.	No.	DATE	
A	ORIGINAL	25/02/2025		SURVEY FILE	No.	DRAWN	JMc
B	PROGRESS	25/03/2025		FIELD BOOK		DATE	25/02/2025
C	PROGRESS	07/05/2025	ADD 2 SHEETS. INCLUDE 2000, 2001 & 1005	LOG BOOK		CHECKED	
				LEVEL DATUM	AHD	DATE	
				DATUM			

veris

CONSULTING SURVEYOR
BRISBANE WHITSUNDAYS
(07) 3666 4700 (07) 4945 6600
MACKAY CAIRNS
(07) 4507 2000 (07) 4202 9400
veris.com.au
ACN 615 735 727
Veris Australia Pty Ltd

egis
© 2023 Egis Consulting Pty Ltd
www.egis-group.com

Moreton Bay
Regional Council

MORETON BAY REGIONAL COUNCIL
CABOOLTURE DISTRICT OFFICE
2 HASKING STREET CABOOLTURE QLD 4510
PO BOX 159 CABOOLTURE QLD 4510
Telephone: (07) 5433 0100
Fax: (07) 5433 4000

OW NUMBER TBC
STAGES 1A & 1B LILYWOOD LANDINGS
AS CONSTRUCTED
EARTHWORKS

MBRC SUBDIVISION REFERENCE	
DA/2021/4669	
No. 3 OF 5 PLANS	REV.
DRAWING NUMBER	
401871-1A-1B-AEW01-C	C




ENGINEER'S CERTIFICATION
Michael Steer being a Certified/Registered Engineer and
(Engineer's Name) Egis Consulting P/L
duly authorised representative of (Consulting firm or company)
I hereby:-
• certify the information contained in this drawing is an accurate "as constructed" representation of the works;
• accept responsibility for the "as constructed" information contained in this drawing; and
• acknowledge the "as constructed" information contained in this drawing may be relied on by the Council and others.
Certification for Stage 1A & 1B Michael Steer 26.05.2025
(Signature) (Date)
for EGIS CONSULTING P/L 6448 20/05/2025
(Company Name) (Number)
Registered Professional Engineering Company of Queensland

REGISTERED SURVEYOR'S CERTIFICATION
I, Vera Australia Pty Ltd, hereby certify that
the vertical and horizontal positions and dimensions shown on this
plan are a true and correct record and were located by survey.
20/05/2025
On Registered Survey (S) 6448 Date
Oil Ref. Number No.

LEGEND
--- AS CONSTRUCTED CONTOURS
(Interval 0.25m)
--- RETAINING WALL

COORDINATE DATUM NOTE:
HORIZONTAL COORDINATES SUPPLIED ARE MAPING GRID OF AUSTRALIAN
ZONE 56 BASED ON THE UNIVERSAL TRANSVERSE MERCATOR PROJECTION AND THE
GEODETIC DATUM OF AUSTRALIA 1984.
HORIZONTAL DATUM DERIVED FROM POINT 777777, E 49349787, N 7002367321.
LEVELS SUPPLIED ARE ON THE AUSTRALIAN HEIGHT DATUM (AHD)
LEVEL DATUM DERIVED FROM POINT 777777, N 777777, E 49349787, N 7002367321.

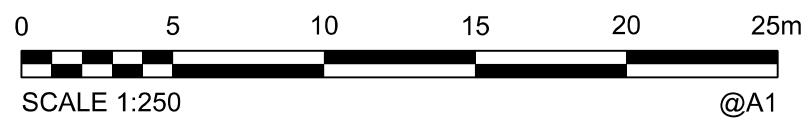


DRAWING REVISIONS		REFERENCE DRAWINGS		DESIGN FILE No.		DESIGNED	
REV.	REVISION DESCRIPTION	DESCRIPTION		CONSTRUCT.	No.	DATE	
A	ORIGINAL	25/02/2025		DRAWN		JMc	
B	PROGRESS	25/03/2025		DATE	25/02/2025		
C	PROGRESS	07/05/2025	ADD 2 SHEETS. INCLUDE 2000, 2001 & 1005	LOG BOOK		CHECKED	
				LEVEL DATUM	AHD	DATE	
				DATUM			

CONSULTING SURVEYOR
BRISBANE (07) 3666 4700
MACKAY (07) 4501 9100
CAIRNS (07) 4202 9400
veris.com.au
ACN 615 735 727
Vera Australia Pty Ltd

© 2023 Egis Consulting Pty Ltd
www.egis-group.com

MORETON BAY REGIONAL COUNCIL
CABOOLTURE DISTRICT OFFICE
2 HASKING STREET CABOOLTURE QLD 4510
PO BOX 159 CABOOLTURE QLD 4510
Telephone: (07) 5433 0100
Fax: (07) 5433 4000

OW NUMBER TBC STAGES 1A & 1B LILYWOOD LANDINGS AS CONSTRUCTED EARTHWORKS		MBC SUBDIVISION REFERENCE DA/2021/4669 No. 4 OF 5 PLANS DRAWING NUMBER 401871-1A-1B-AEW01-C		REV. C
---	--	---	--	-----------

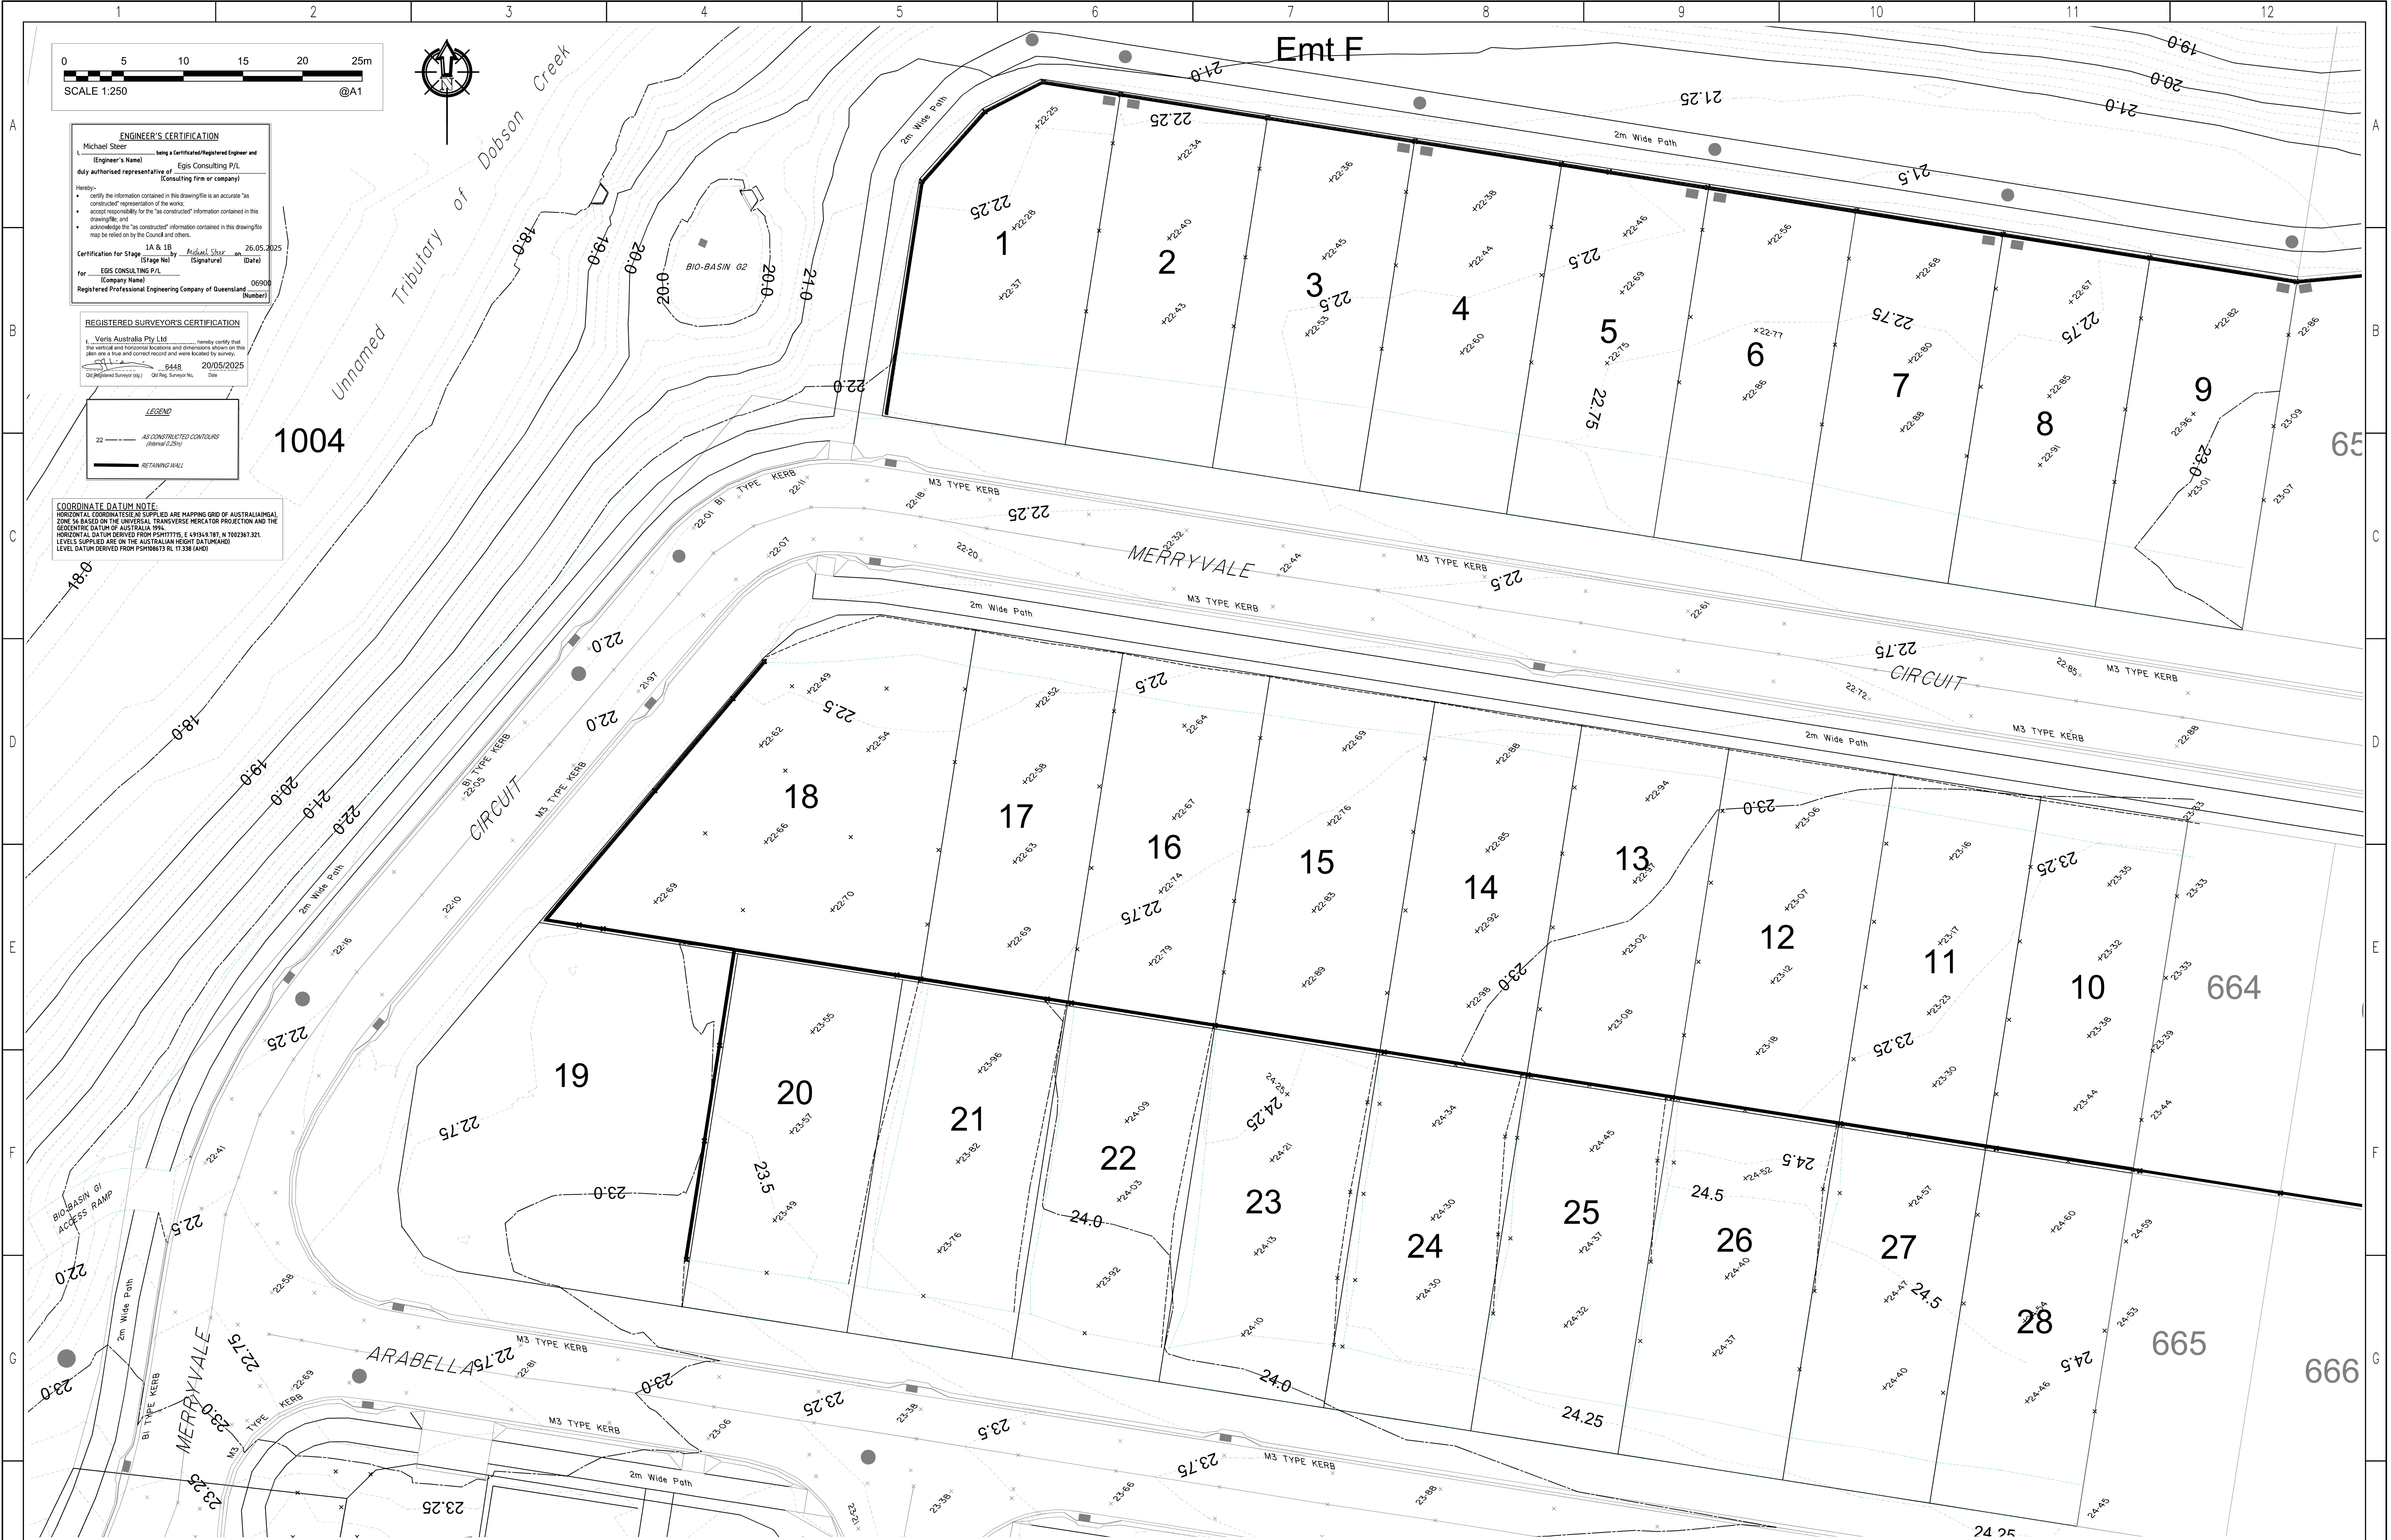

ENGINEER'S CERTIFICATION
Michael Steer being a Certified/Registered Engineer and duly authorised representative of Egis Consulting P/L (Consulting firm or company)
I hereby:
• certify the information contained in this drawing is an accurate "as constructed" representation of the works;
• accept responsibility for the "as constructed" information contained in this drawing; and
• acknowledge that the "as constructed" information contained in this drawing may be relied on by the Council and others.
Certification for Stage 1A & 1B by Michael Steer on 26.05.2025 (Stage No) (Signature) (Date)
for EGIS CONSULTING P/L (Company Name) 06909 (Registered Professional Engineering Company of Queensland Number)

REGISTERED SURVEYOR'S CERTIFICATION
Veris Australia Pty Ltd hereby certify that the vertical and horizontal locations and dimensions shown on this plan are a true and correct record and were located by survey.
C.L.L. 6448 20/05/2025
Qld Registered Surveyor (Sg) Qld Reg. Surveyor No. Date

LEGEND
22 - - - - - AS CONSTRUCTED CONTOURS (Interval 0.20m)
- - - - - RETAINING WALL

COORDINATE DATUM NOTE:
HORIZONTAL COORDINATES: SUPPLIED ARE HAPPING GRID OF AUSTRALIA (MGA), ZONE 54, BASED ON THE UNIVERSAL TRANSVERSE MERCATOR PROJECTION AND THE GEODETIC DATUM OF AUSTRALIA 1984.
HORIZONTAL DATUM DERIVED FROM PHOTOTRYPS, E 49134.781, N 700267.321.
LEVELS: SUPPLIED ARE ON THE AUSTRALIAN HEIGHT DATUM (AHD).
LEVEL DATUM DERIVED FROM PSN00615 RL 17.338 (AHD)

DRAWING REVISIONS		REFERENCE DRAWINGS		DESIGN FILE No.		DESIGNED	
REV.	REVISION DESCRIPTION	DESCRIPTION		CONSTRUCT. No.	DATE	DATE	
A	ORIGINAL	25/02/2025		SURVEY FILE No.	401871-1A-1B-AEW01	DRAWN	JMc
B	PROGRESS	25/03/2025		FIELD BOOK		DATE	25/02/2025
C	PROGRESS	07/05/2025	ADD 2 SHEETS. INCLUDE 2000, 2001 & 1005	LOG BOOK		CHECKED	
				LEVEL DATUM	AHD	DATE	
				DATUM			

CONSULTING SURVEYOR
BRISBANE (07) 3666 4700
MACKAY (07) 4507 2000
CAIRNS (07) 4202 9400
veris.com.au
ACN 615 735 727
Veris Australia Pty Ltd

© 2023 Egis Consulting Pty Ltd
www.egis-group.com

SCALE 1:250
ORIGINAL SIZE A1

MORETON BAY REGIONAL COUNCIL
CABOOLTURE DISTRICT OFFICE
2 HASKING STREET CABOOLTURE QLD 4510
PO BOX 159 CABOOLTURE QLD 4510
Telephone: (07) 54393 0100
Fax: (07) 54393 4000

OW NUMBER TBC
STAGES 1A & 1B LILYWOOD LANDINGS
AS CONSTRUCTED
EARTHWORKS

MBRC SUBDIVISION REFERENCE	
DA/2021/4669	
No. 5 OF 5 PLANS	
DRAWING NUMBER	REV.
401871-1A-1B-AEW01-C	C