



Michael Steer
I, _____, hereby certify that:
1. The information contained in this drawing / document is in compliance with approved drawings and design.
2. The new water and sewerage works defined by this drawing have been designed and constructed in accordance with the SEQ Code.
3. This represents an accurate record of as-constructed works
4. I accept responsibility for the information contained in this drawing / document


Michael Steer
RPEQ (signature) RPEQ No. 06900 Date: 20.05.2025

I, **VERIS AUSTRALIA P/L**, hereby certify that the vertical and horizontal locations and dimensions shown on this plan are a true and correct record and were located by survey.



Registered Surveyor (s/o) Reg. Surveyor No. 6448 Date 16/05/202

AS CONSTRUCTED

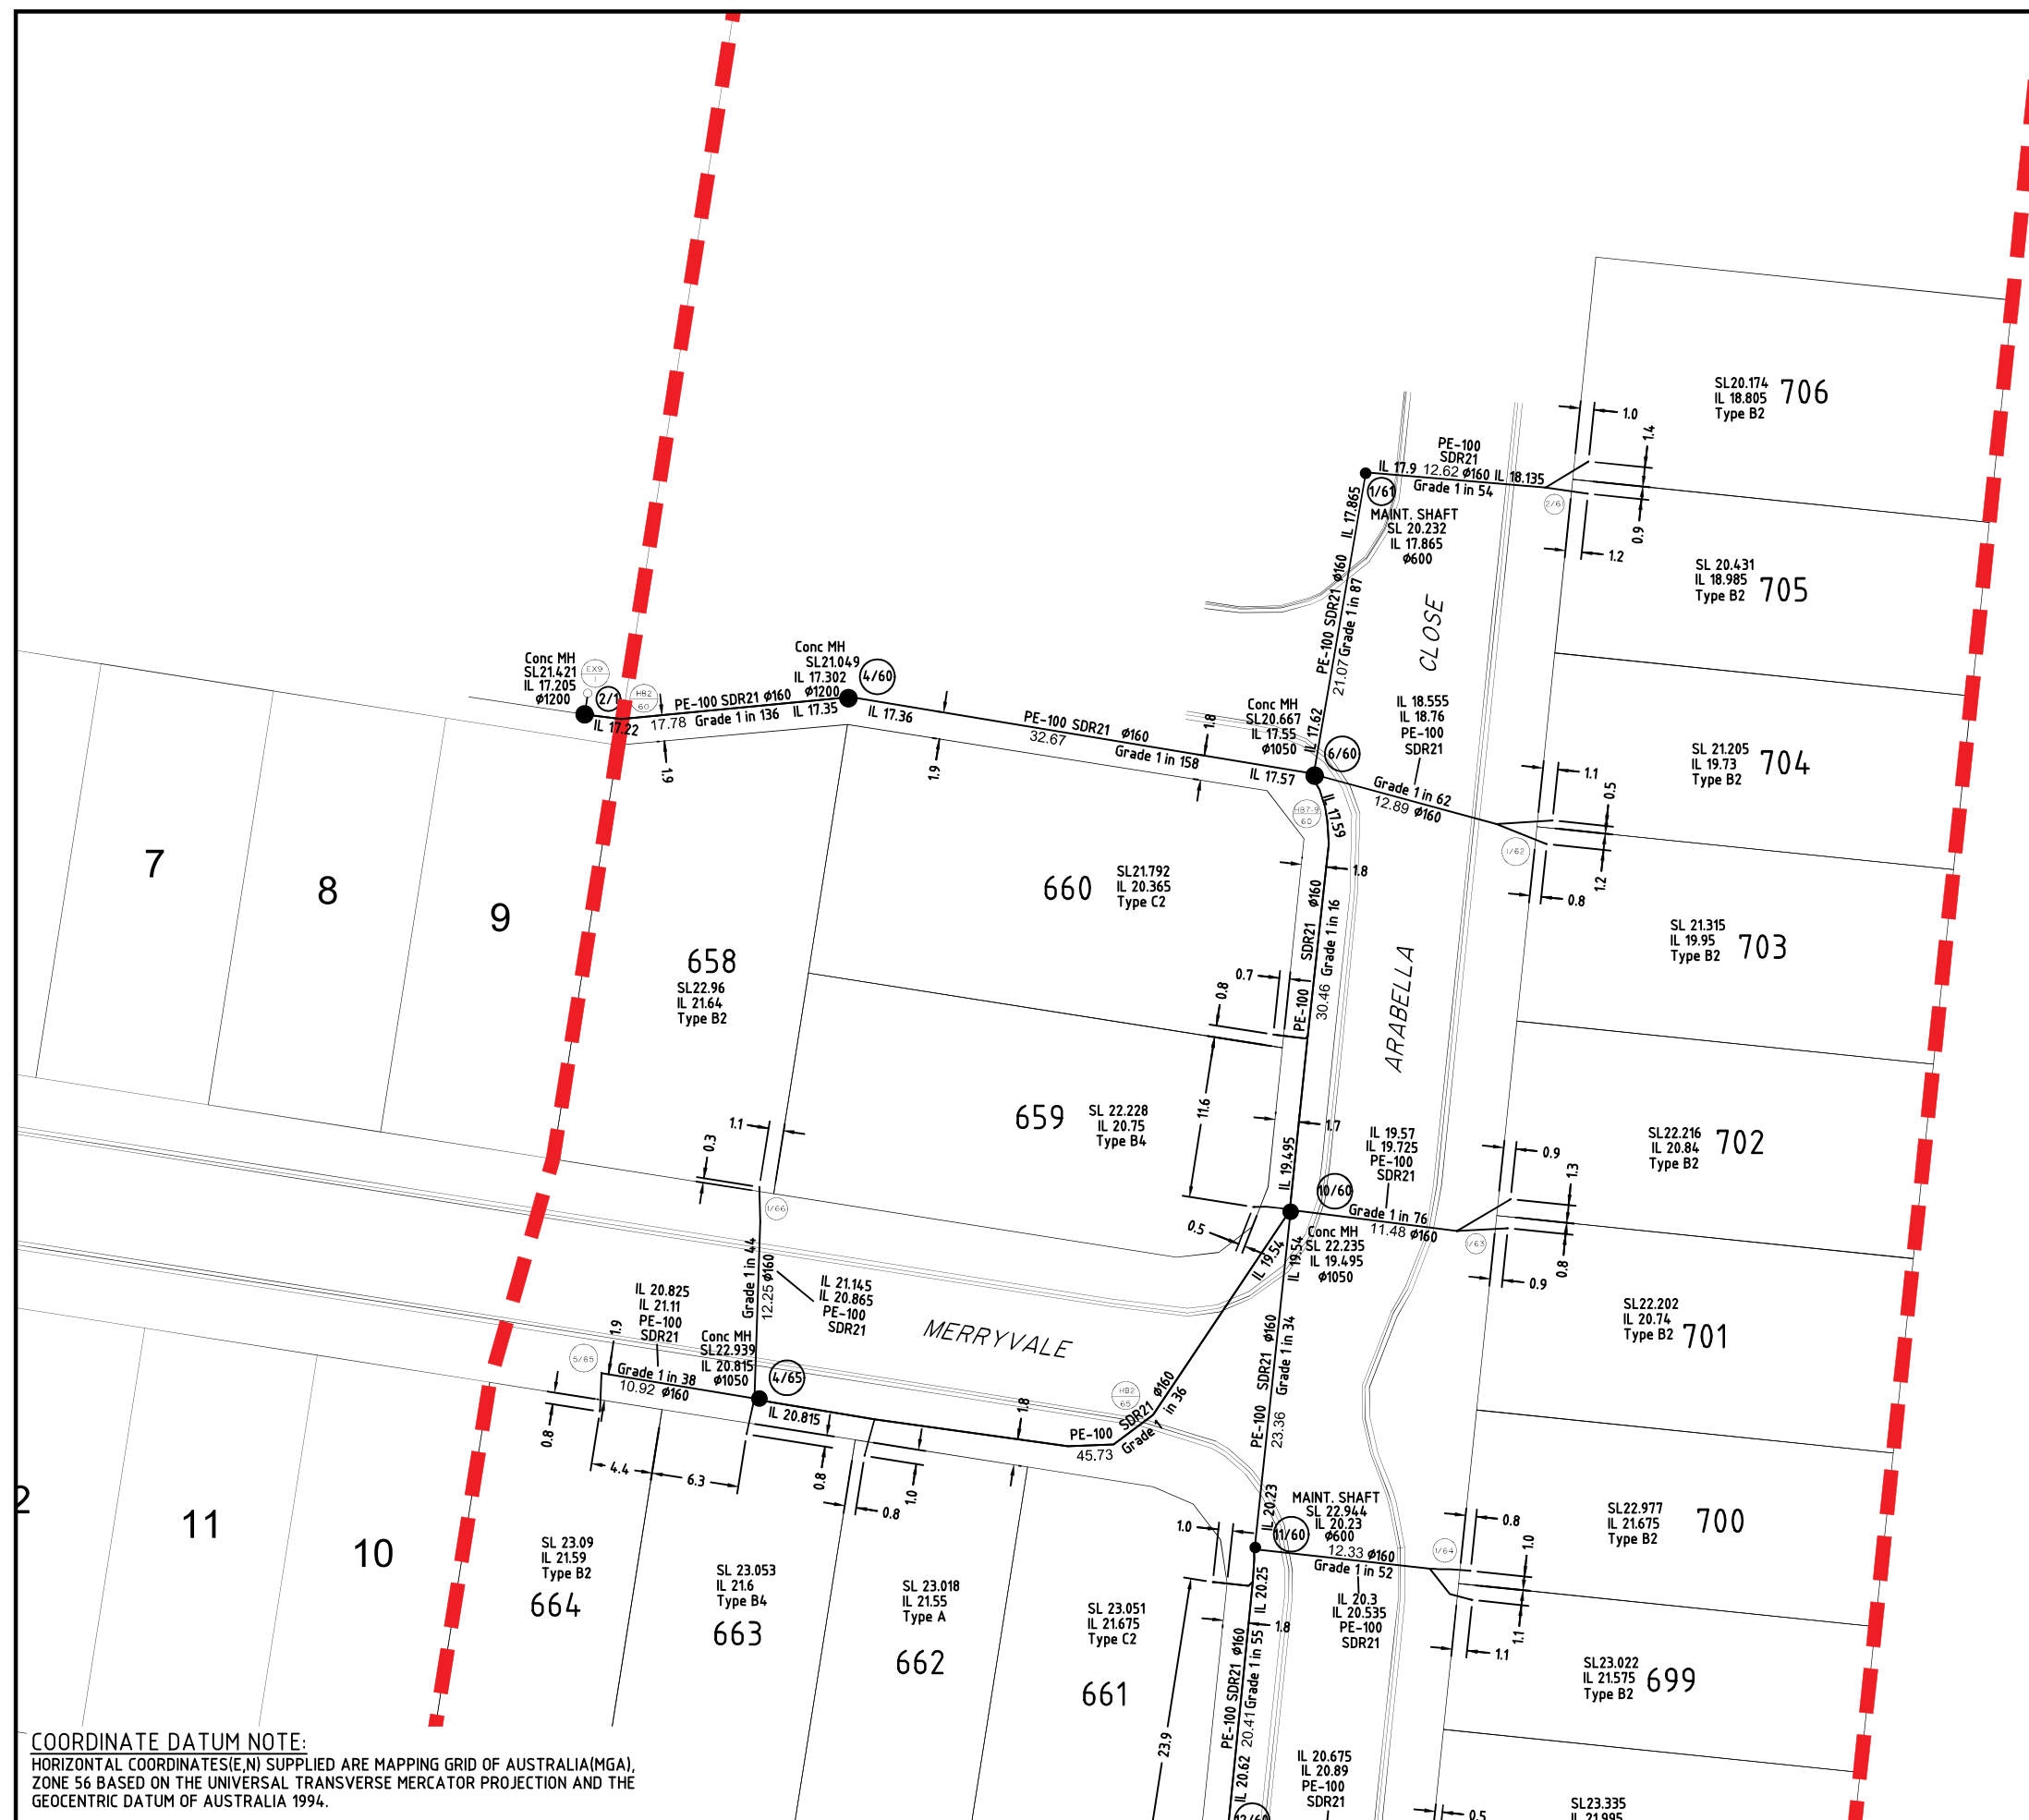

COORDINATE DATUM NOTE:
HORIZONTAL COORDINATES(E,N) SUPPLIED ARE MAPPING GRID OF AUSTRALIA(MGA),
ZONE 56 BASED ON THE UNIVERSAL TRANSVERSE MERCATOR PROJECTION AND THE
GEOCENTRIC DATUM OF AUSTRALIA 1994.

[illegible]


BRISBANE (07) 3686 4700
MACKAY (07) 4957 9700
WHITSUNDAY (07) 4945 6800
CAIRNS (07) 4252 9400
veris.com.au
ACN 615 735 727
Veris Australia Pty Ltd



APP-11968
Lillywood Landings Stage 23

SHEET 2 OF 4 SHEETS		SCALE 1:250	
REVISION DATE 14-05-2025		REVISION 1	
DISCIPLINE CODE C			
DRAWING NO. U-2025-6023			

Copyright © 2011 Unitywater. All Rights Reserved

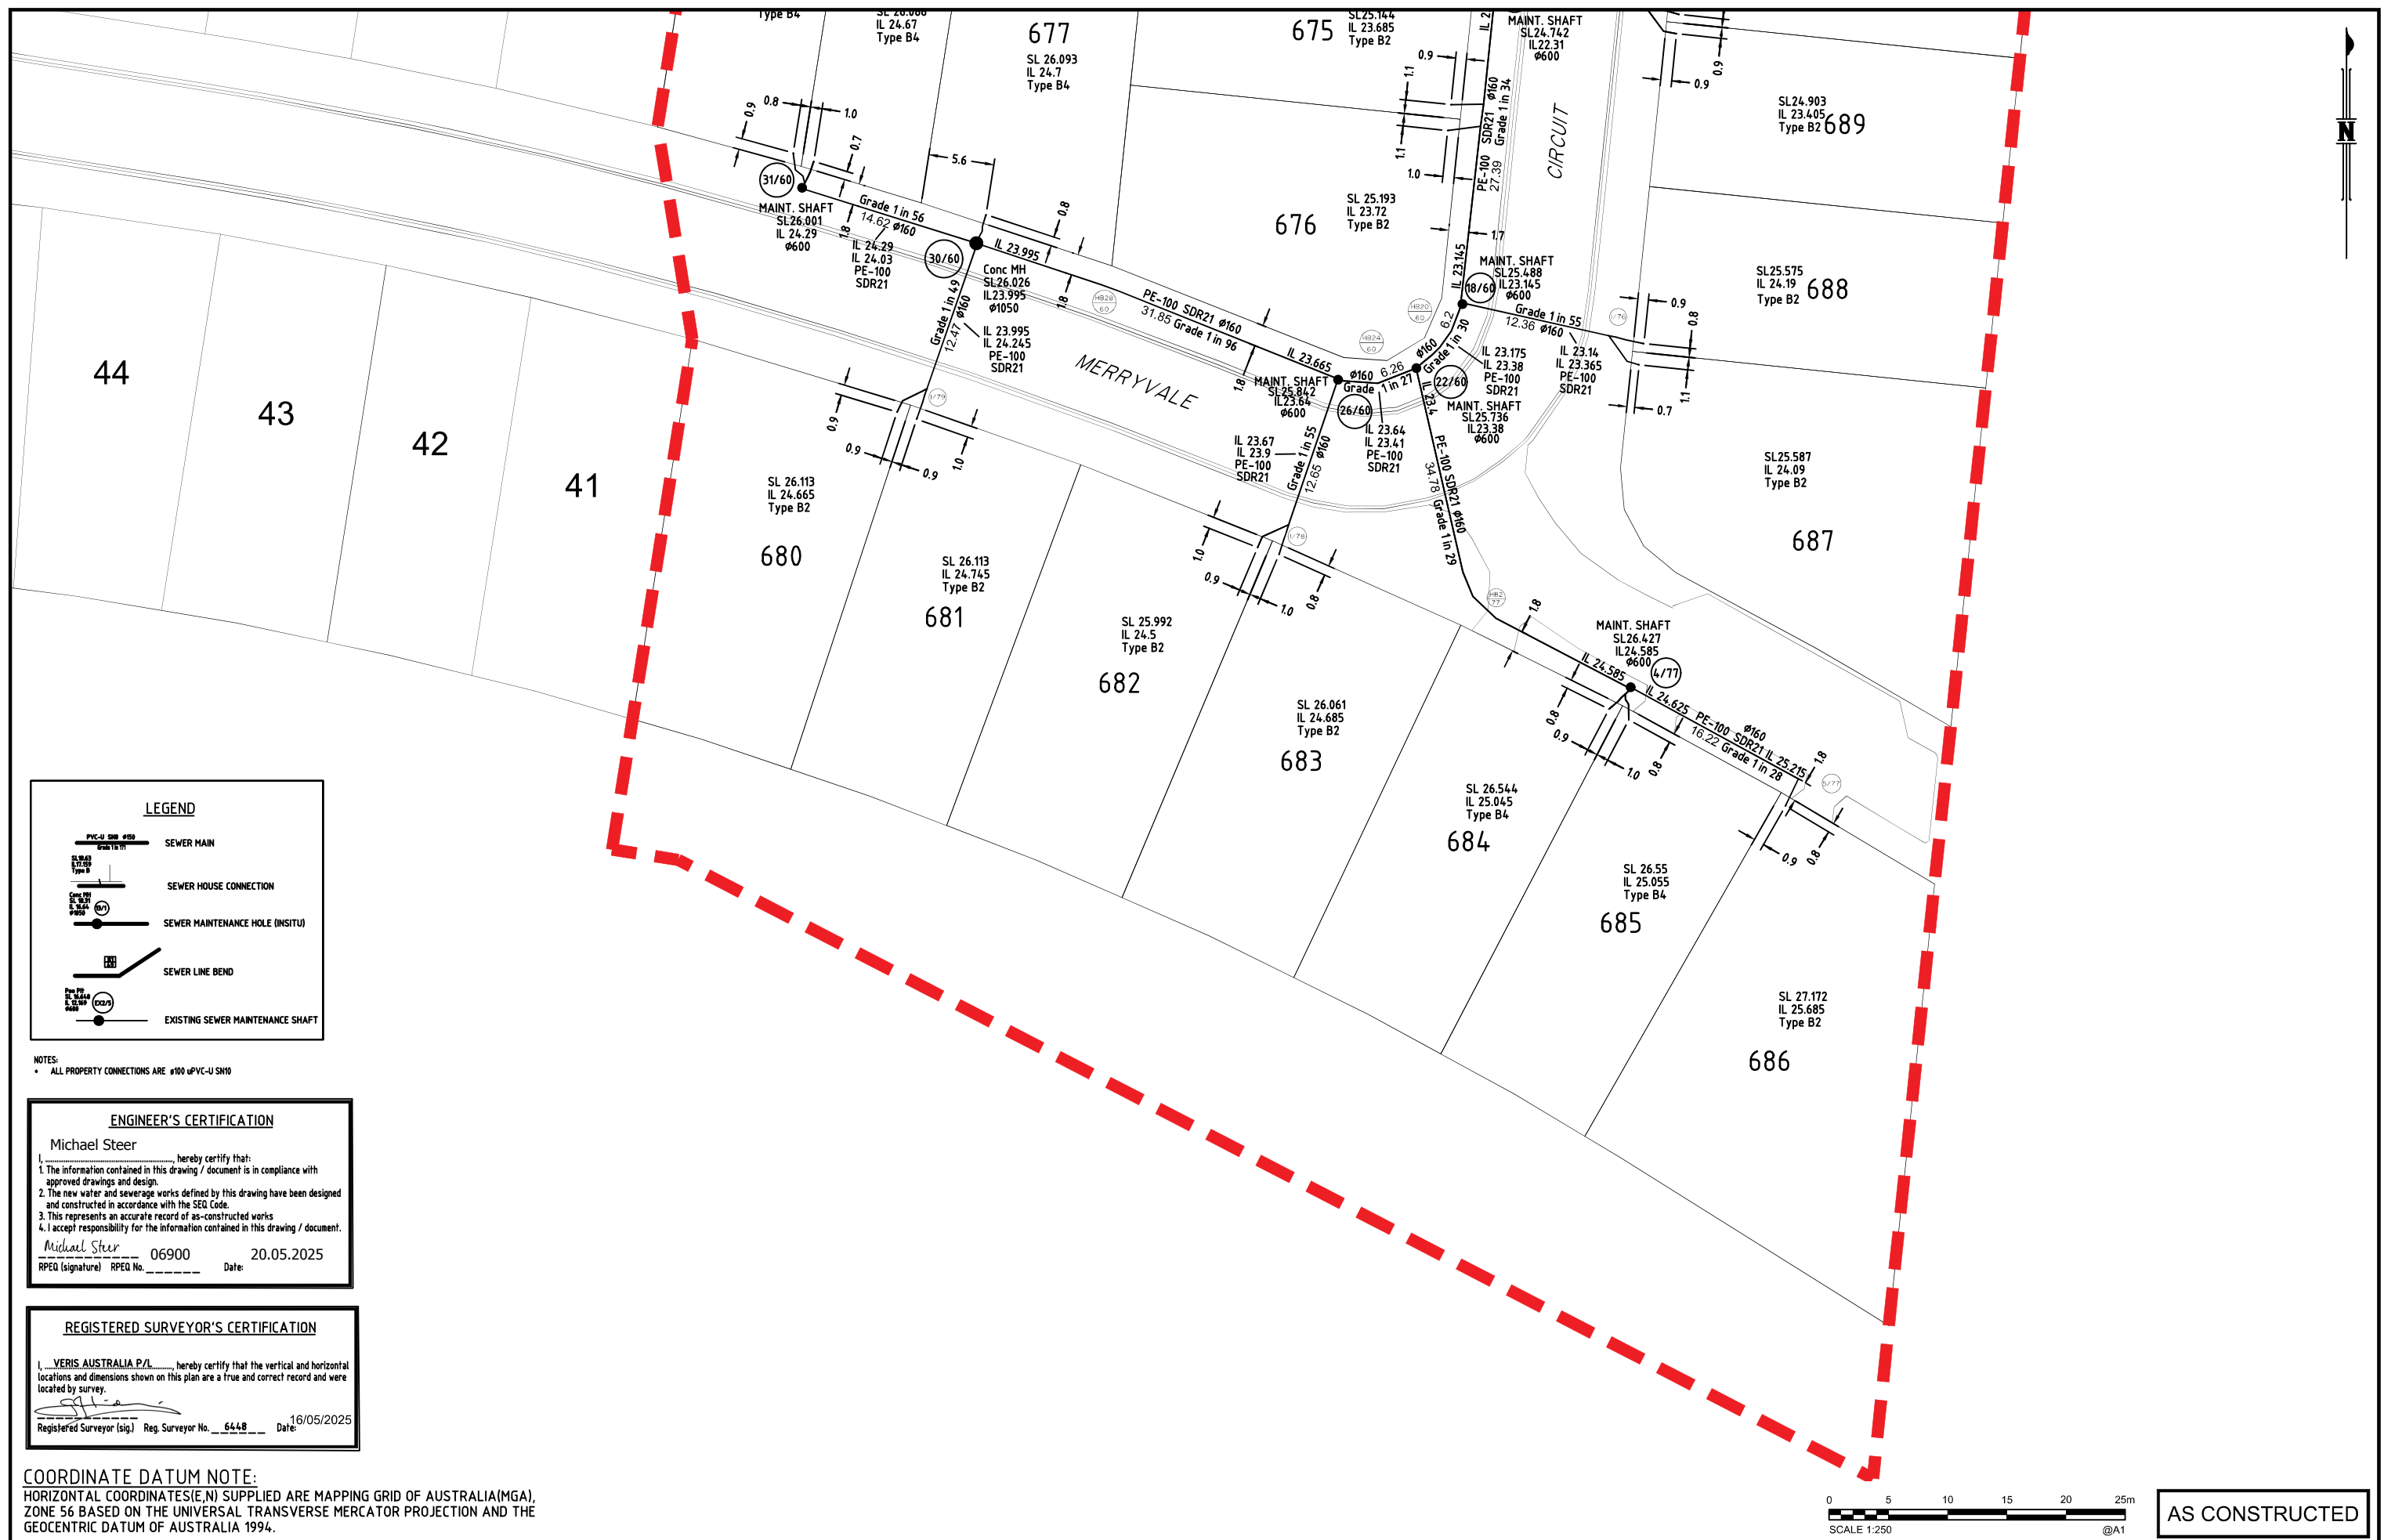[illegible]