



HORIZONTAL COORDINATES(E,N) SUPPLIED ARE MAPPING GRID OF AUSTRALIA(MGA), ZONE 56 BASED ON THE UNIVERSAL TRANSVERSE MERCATOR PROJECTION AND THE GEOCENTRIC DATUM OF AUSTRALIA 1994.

CONSULTING SURVEYOR

veris

BRISBANE WHITSUNDAY:
(0)7 3666 4700 (0)7 4946 6600

MACKAY CAIRNS
(0)7 4957 9709 (0)7 4252 9400

veris.com.au
ACN 615 735 727
Veris Australia Pty Ltd



APP-12010
Lilywood Landings
Stage 1A & 1B

Copyright © 2011 Unitywater. All Rights Reserved

LEGEND

PVC-U 500 Ø160
Sewer Main

Sewer House Connection

Sewer Maintenance Hole (In Situ)

Sewer Line Bend

Existing Sewer Maintenance Shaft

ENGINEER'S CERTIFICATION

Michael Steer

I, Michael Steer, hereby certify that:

- The information contained in this drawing / document is in compliance with approved drawings and design.
- The new water and sewerage works defined by this drawing have been designed and constructed in accordance with the SEQ Code.
- This represents an accurate record of as-constructed works.
- I accept responsibility for the information contained in this drawing / document.


Michael Steer 06900 Date: 26.05.2025

RPEQ (Signature) RPEQ No. _____

REGISTERED SURVEYOR'S CERTIFICATION

I, Veris Australia Pty Ltd, hereby certify that the vertical and horizontal locations and dimensions shown on this plan are a true and correct record and were located by survey.

Registered Surveyor (sig.) Reg. Surveyor No. 6448 Date: 20/05/2025

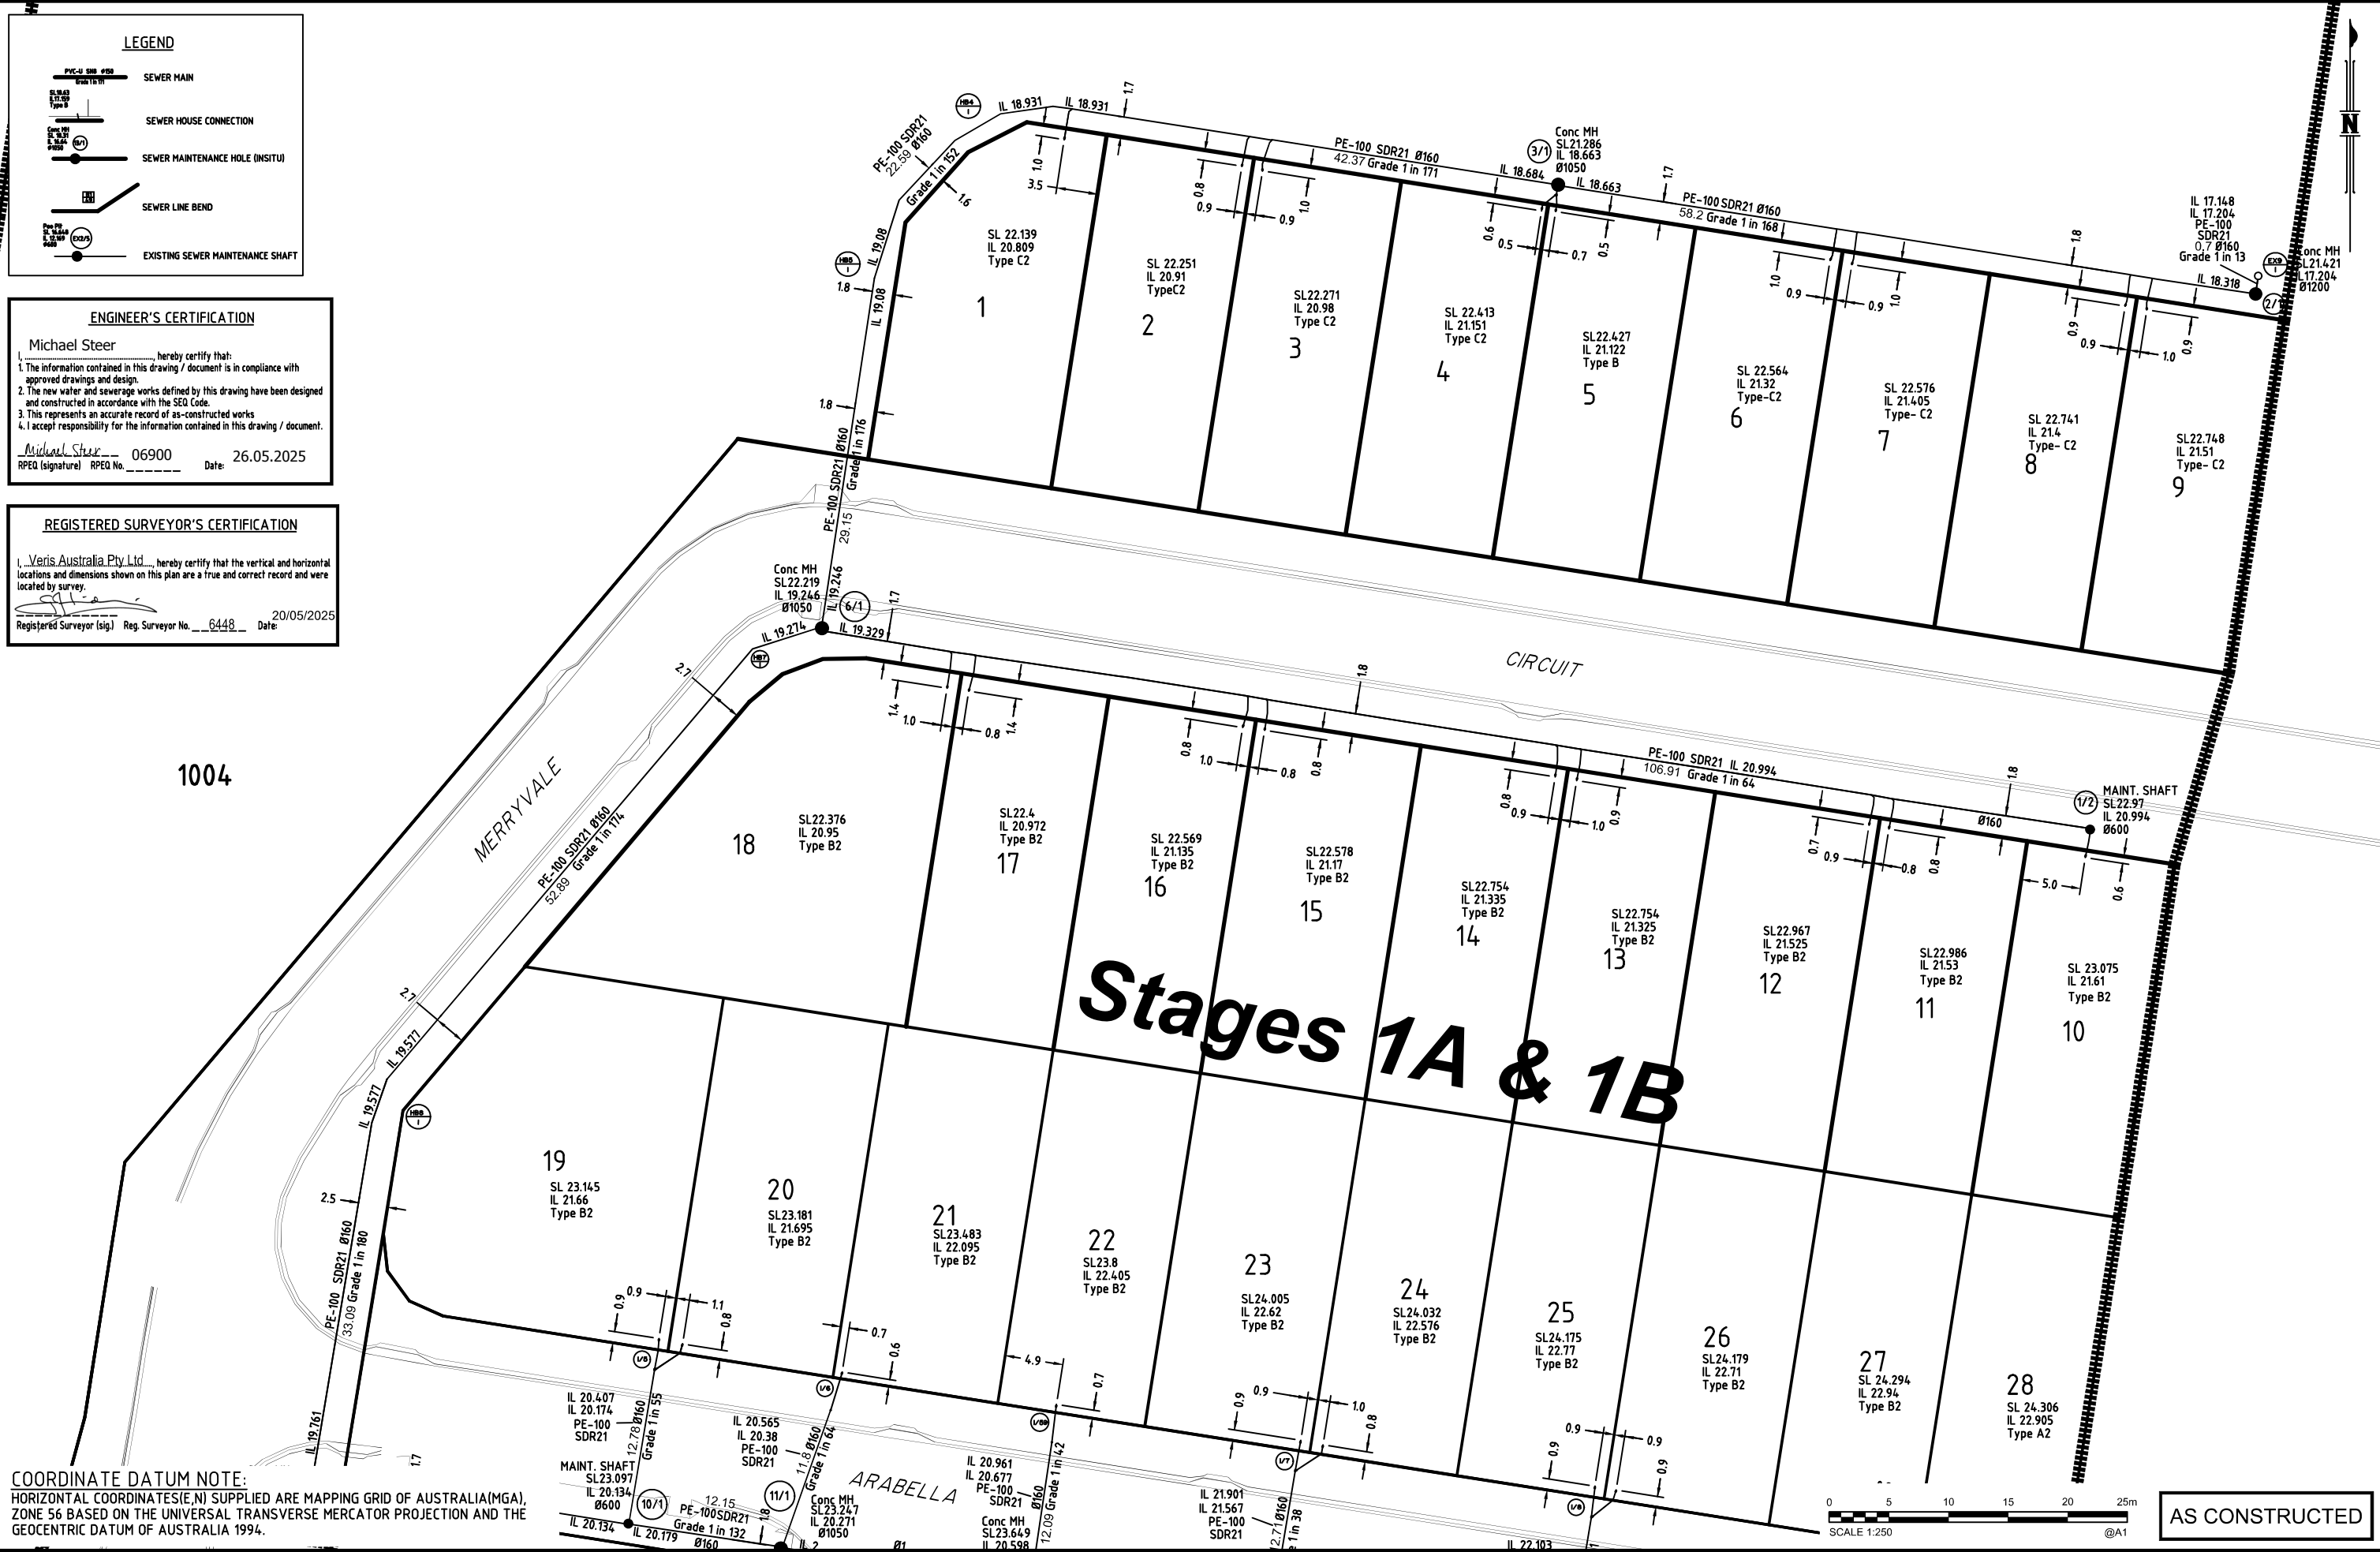

COORDINATE DATUM NOTE:
HORIZONTAL COORDINATES(E,N) SUPPLIED ARE MAPPING GRID OF AUSTRALIA(MGA),
ZONE 56 BASED ON THE UNIVERSAL TRANSVERSE MERCATOR PROJECTION AND THE
GEOCENTRIC DATUM OF AUSTRALIA 1994.

SCALE 1:250

AS CONSTRUCTED

A1	H	20/05/2025	NEW TEMPLATE, DWG NUMBER	AD					
	G	03/04/2025	PROGRESS PLOT	JMc					
	F	24/03/2025	PROGRESS PLOT	JMc					
	E	28/02/2025	PROGRESS PLOT	JMc					
	D	28/01/2025	PROGRESS PLOT	JMc					
	INDEX	DATE	REVISIONS	DRAWN	CHECKED	PASSED	INITIALS	DATE	

CONSULTING SURVEYOR

veris

BRISBANE WHITSUNDAYS
(07) 5668 4700 (07) 4945 6800

MACKAY CAIRNS
(07) 4957 9700 (07) 4352 9400


veris.com.au
ACN 615 735 727
Veris Australia Pty Ltd

Unitywater

Unitywater

APP-12010
Lillywood Landings
Stage 1A & 1B

SHEET 2 OF 3	SHEETS	SCALE 1:250
REVISION DATE	19-05-2025	REVISION H
DISCIPLINE CODE	C	
DRAWING NO.	U-2025-6029	

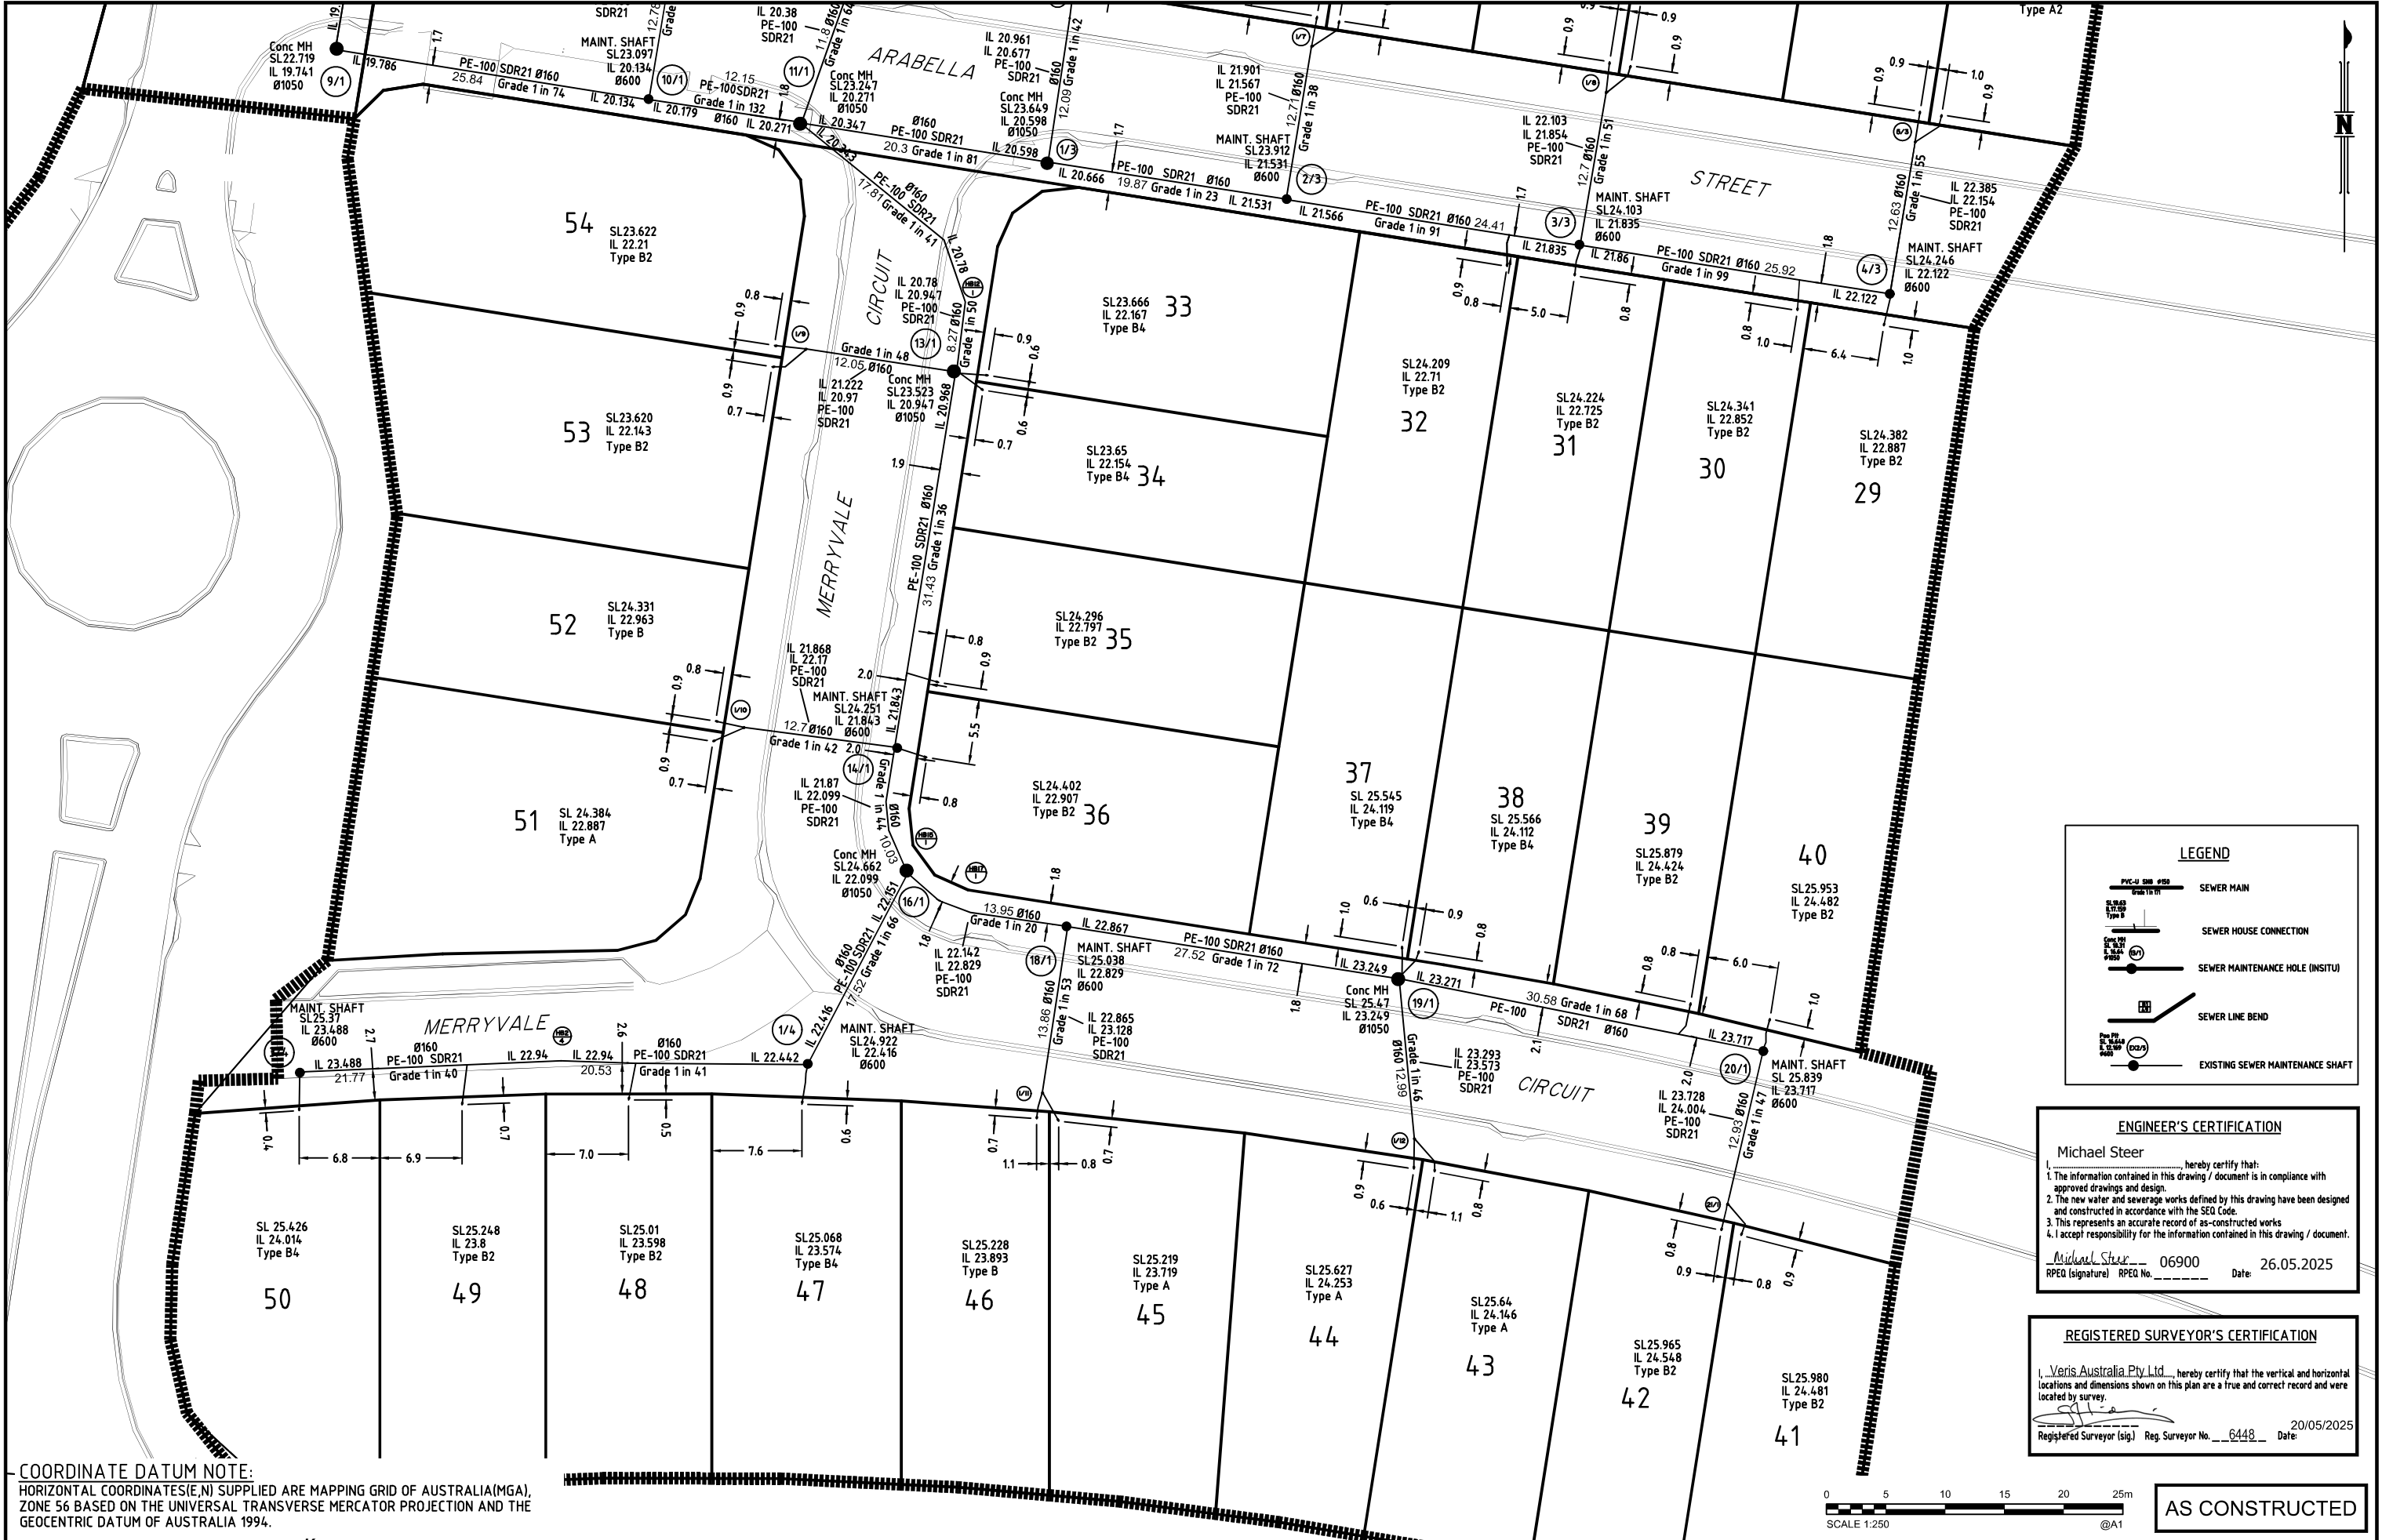

COORDINATE DATUM NOTE:
HORIZONTAL COORDINATES(E,N) SUPPLIED ARE MAPPING GRID OF AUSTRALIA(MGA),
ZONE 56 BASED ON THE UNIVERSAL TRANSVERSE MERCATOR PROJECTION AND THE
GEOCENTRIC DATUM OF AUSTRALIA 1994.

LEGEND

SEWER MAIN

SEWER HOUSE CONNECTION

SEWER MAINTENANCE HOLE (INSITU)

SEWER LINE BEND

EXISTING SEWER MAINTENANCE SHAFT

ENGINEER'S CERTIFICATION

Michael Steer

I, Michael Steer, hereby certify that:

1. The information contained in this drawing / document is in compliance with approved drawings and design.

2. The new water and sewerage works defined by this drawing have been designed and constructed in accordance with the SEQ Code.

3. This represents an accurate record of as-constructed works

4. I accept responsibility for the information contained in this drawing / document.

Michael Steer

06900

26.05.2025

RPEQ (signature)

RPEQ No.

Date

REGISTERED SURVEYOR'S CERTIFICATION

I, Veris Australia Pty Ltd, hereby certify that the vertical and horizontal locations and dimensions shown on this plan are a true and correct record and were located by survey.

20/05/2025

Registered Surveyor (sig.)

Reg. Surveyor No. 6448

Date



AS CONSTRUCTED

A1	H	20/05/2025	NEW TEMPLATE, DWG NUMBER	AD					
	G	03/04/2025	PROGRESS PLOT	JMc					
	F	24/03/2025	PROGRESS PLOT	JMc		DRAWN	AD	20/05/2025	
	E	28/02/2025	PROGRESS PLOT	JMc		CHECKED			
	D	28/01/2025	PROGRESS PLOT	JMc		PASSED			
	INDEX	DATE	REVISIONS	DRAWN	CHECKED	PASSED	INITIALS	DATE	

CONSULTING SURVEYOR

veris

BRISBANE
(07) 5668 4700

WHITSUNDAYS
(07) 4945 6800

MACKAY
(07) 4957 9700

CAIRNS
(07) 4552 9400

veris.com.au
ACN 615 735 727
Veris Australia Pty Ltd

Unitywater

APP-12010
Lillywood Landings
Stage 1A & 1B

SHEET 2 OF 3 SHEETS	SCALE 1:250
REVISION DATE 19-05-2025	REVISION H
DISCIPLINE CODE C	
DRAWING NO. U-2025-6029	