

SHEET 2

SHEET 3

SHEET 4

SHEET 5

SHEET 6

REGISTERED SURVEYOR'S CERTIFICATION

I, Veris Australia Pty Ltd, hereby certify that the vertical and horizontal locations and dimensions shown on this plan are a true and correct record and were located by survey.

6448
Old Registered Surveyor (sig.) Old Reg. Surveyor No. Date

ENGINEER'S CERTIFICATION

I, (Engineer's Name), being a Certificated/Registered Engineer and duly authorised representative of EGIS CONSULTING P/L (Consulting firm or company)


Hereby:-

- certify the information contained in this drawing/file is an accurate "as constructed" representation of the works;
- accept responsibility for the "as constructed" information contained in this drawing/file; and
- acknowledge the "as constructed" information contained in this drawing/file may be relied on by the Council and others.


Certification for Stage 23 by (Signature) on (Date)

for EGIS CONSULTING P/L (Company Name)

Registered Professional Engineering Company of Queensland (Number)

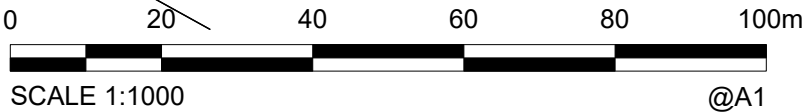

DRAWING REVISIONS		REFERENCE DRAWINGS		DESIGN FILE No.		DESIGNED	
REV.	REVISION DESCRIPTION	DESCRIPTION		CONSTRUCT. No.		DATE	
A	ORIGINAL	21/07/2025		SURVEY FILE No. A01871-2-ASW01		DRAWN	JMc
B	PROGRESS PLOT	01/08/2025		FIELD BOOK		DATE	21/07/2025
C	PROGRESS PLOT	28/08/2025		LOG BOOK		CHECKED	
				LEVEL DATUM	AHD	DATE	
				DATUM			

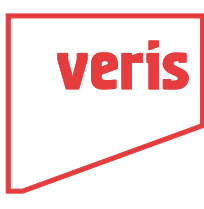

BRISBANE
(07) 3666 4700
MACKAY
(07) 4957 9100
Veris.com.au
ACN 615 735 727
Veris Australia Pty Ltd



WHITSUNDAYS
(07) 4945 6900
CAIRNS
(07) 4252 9400
© 2023 Egis Consulting Pty Ltd
www.egis-group.com


SCALE 1:1000 ORIGINAL SIZE A1



MORETON BAY REGIONAL COUNCIL
CABOOLTURE DISTRICT OFFICE
2 HASKING STREET CABOOLTURE QLD 4510
PO BOX 159 CABOOLTURE QLD 4510
Telephone: (07) 5433 0100
Fax: (07) 5433 4000

OW NUMBER TBC
STAGE 2 LILYWOOD LANDINGS
AS CONSTRUCTED STORMWATER

MBRC SUBDIVISION REFERENCE	
DA/____/____	
No. 1 OF 6 PLANS	
DRAWING NUMBER	REV.
401871-2-ASW01-C	C

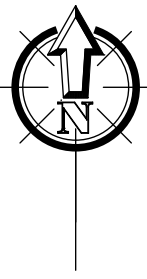

REGISTERED SURVEYOR'S CERTIFICATION

I, **Veris Australia Pty Ltd**, hereby certify that the vertical and horizontal locations and dimensions shown on this plan are a true and correct record and were located by survey.

-----**6448**-----
Old Registered Surveyor (sig.) Old Reg. Surveyor No. Date

ENGINEER'S CERTIFICATION

I, _____, being a Certificated/Registered Engineer and
(Engineer's Name)
duly authorised representative of **EGIS CONSULTING P/L**
(Consulting firm or company)


Hereby:-

- certify the information contained in this drawing/file is an accurate "as constructed" representation of the works;
- accept responsibility for the "as constructed" information contained in this drawing/file; and
- acknowledge the "as constructed" information contained in this drawing/file map be relied on by the Council and others.

Certification for Stage 2 by _____ on _____
(Stage No) (Signature) (Date)

for **EGIS CONSULTING P/L**
(Company Name)

Registered Professional Engineering Company of Queensland _____
(Number)

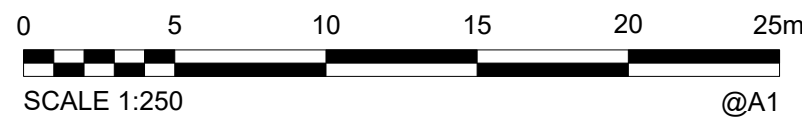

DRAWING REVISIONS		REFERENCE DRAWINGS		DESIGN FILE No.	DESIGNED		
REV.	REVISION DESCRIPTION	DESCRIPTION		CONSTRUCT. No.	DATE		
A	ORIGINAL 21/07/2025			SURVEY FILE No.	DRAWN		
B	PROGRESS PLOT 01/08/2025			FIELD BOOK	DATE		
C	PROGRESS PLOT 28/08/2025			LOG BOOK	CHECKED		
				LEVEL DATUM	DATE		
				DATUM			



BRISBANE (07) 3666 4700
MACKAY (07) 4967 5700
veris.com.au
ACN 615 735 727
Veris Australia Pty Ltd


WHITSUNDAYS (07) 4945 6600
CAIRNS (07) 4252 9400
www.egis-group.com



MORETON BAY REGIONAL COUNCIL
CABOOLTURE DISTRICT OFFICE
2 HASKING STREET CABOOLTURE QLD 4510
PO BOX 159 CABOOLTURE QLD 4510
Telephone: (07) 5433 0100
Fax: (07) 5433 4000

OW NUMBER TBC
STAGE 2 LILYWOOD LANDINGS
AS CONSTRUCTED STORMWATER

MBRC SUBDIVISION REFERENCE	
DA/____/____	
No. 2 OF 6 PLANS	
DRAWING NUMBER	REV.
401871-2-ASW01-C	C

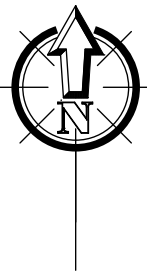

REGISTERED SURVEYOR'S CERTIFICATION

I, **Veris Australia Pty Ltd**, hereby certify that the vertical and horizontal locations and dimensions shown on this plan are a true and correct record and were located by survey.

-----**6448**-----
Old Registered Surveyor (sig.) Old Reg. Surveyor No. Date

ENGINEER'S CERTIFICATION


I, _____, being a Certificated/Registered Engineer and
(Engineer's Name)
duly authorised representative of **EGIS CONSULTING P/L**
(Consulting firm or company)

Hereby:-

- certify the information contained in this drawing/file is an accurate "as constructed" representation of the works;
- accept responsibility for the "as constructed" information contained in this drawing/file; and
- acknowledge the "as constructed" information contained in this drawing/file map be relied on by the Council and others.

Certification for Stage 2 by _____ on _____
(Stage No) (Signature) (Date)

for **EGIS CONSULTING P/L**
(Company Name)
Registered Professional Engineering Company of Queensland _____
(Number)

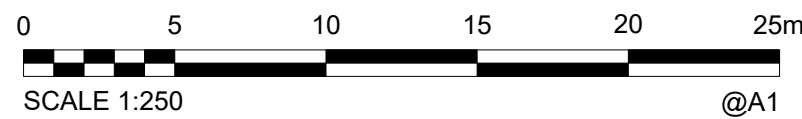

DRAWING REVISIONS		REFERENCE DRAWINGS		DESIGN FILE No.	DESIGNED	
REV.	REVISION DESCRIPTION	DESCRIPTION		CONSTRUCT. No.	DATE	
A	ORIGINAL	21/07/2025		SURVEY FILE No.	DRAWN	JMc
B	PROGRESS PLOT	01/08/2025		FIELD BOOK	DATE	21/07/2025
C	PROGRESS PLOT	28/08/2025		LOG BOOK	CHECKED	
				LEVEL DATUM	DATE	
				DATUM		



BRISBANE
(07) 3666 4700
MACKAY
(07) 4967 5700
veris.com.au
ACN 615 735 727
Veris Australia Pty Ltd

WHITSUNDAYS
(07) 4945 6600
CAIRNS
(07) 4252 4400
www.egis-group.com



© 2023 Egis Consulting Pty Ltd
www.egis-group.com



Moreton Bay
Regional Council

SCALE 1:250 ORIGINAL SIZE A1

MORETON BAY REGIONAL COUNCIL
CABOOLTURE DISTRICT OFFICE
2 HASKING STREET CABOOLTURE QLD 4510
PO BOX 159 CABOOLTURE QLD 4510
Telephone: (07) 5433 0100
Fax: (07) 5433 4000

OW NUMBER TBC
STAGE 2 LILYWOOD LANDINGS
AS CONSTRUCTED STORMWATER

MBRC SUBDIVISION REFERENCE	
DA/____/____	
No. 3 OF 6 PLANS	
DRAWING NUMBER	REV.
401871-2-ASW01-C	C

