COORDINATE DATUM NOTE:
HORIZONTAL COORDINATES(E,N) SUPPLIED ARE MAPPING GRID OF AUSTRALIA(MGA), ZONE 56 BASED ON THE UNIVERSAL TRANSVERSE MERCATOR PROJECTION AND THE GEOCENTRIC DATUM OF AUSTRALIA 2020.
HORIZONTAL DATUM DERIVED FROM PM72109, E 490,729.557 N 7,001,736.666
LEVELS SUPPLIED ARE ON THE AUSTRALIAN HEIGHT DATUM(AHD)
LEVEL DATUM DERIVED FROM PM72109 RL 30.422 (AHD)

REGISTERED SURVEYOR'S CERTIFICATION

I, Veris Australia Pty Ltd, hereby certify that the vertical and horizontal locations and dimensions shown on this plan are a true and correct record and were located by survey.

Qld Registered Surveyor (sig.) | 6448 Qld Reg. Surveyor No. | 22/05/2025 Date

ENGINEER'S CERTIFICATION

I, Michael Steer (Engineer's Name) being a Certificated/Registered Engineer and duly authorised representative of EGIS CONSULTING PTY LTD (Consulting firm or company)

Hereby:-

- certify the information contained in this drawing/file is an accurate "as constructed" representation of the works;
- accept responsibility for the "as constructed" information contained in this drawing/file; and
- acknowledge the "as constructed" information contained in this drawing/file map be relied on by the Council and others.

Certification for Stage 23 (Stage No) by Michael Steer (Signature) on 26.05.2025 (Date)

for EGIS CONSULTING PTY LTD (Company Name)

Registered Professional Engineering Company of Queensland 06900 (Number)

0 15 30 45 60 75m
SCALE 1:750 @A1

DRAWING REVISIONS		REFERENCE DRAWINGS	DESIGN FILE No.		DESIGNED	
REV.	REVISION DESCRIPTION	DESCRIPTION	CONSTRUCT. No.		DATE	
A	ORIGINAL 10/05/2024		SURVEY FILE No.	401871-1A-1B-AEW01	DRAWN	JMc
			FIELD BOOK		DATE	10/05/2024
			LOG BOOK		CHECKED	
			LEVEL DATUM	AHD	DATE	
			DATUM			

veris
BRISBANE (07) 3666 4700 WHITSUNDAYS (07) 4945 6600
MACKAY (07) 4957 9700 CAIRNS (07) 4253 9400
veris.com.au
ACN 615 735 727
Veris Australia Pty Ltd

..\..\..\250129 EGIS LOGO.png

SCALE 1:750 ORIGINAL SIZE A1

Moreton Bay Regional Council

MORETON BAY REGIONAL COUNCIL
CABOOLTURE DISTRICT OFFICE
2 HASKING STREET CABOOLTURE QLD 4510
PO BOX 159 CABOOLTURE QLD 4510
Telephone: (07) 5433 0100
Fax: (07) 5433 4000

OW NUMBER TBC
STAGES 1A & 1B LILYWOOD LANDINGS AS CONSTRUCTED EARTHWORKS

MBRC SUBDIVISION REFERENCE	
DA/2023/3491	
No. 1 OF 3 PLANS	
DRAWING NUMBER	REV.
401871-1A-1B-AEW01	A

COORDINATE DATUM NOTE:
HORIZONTAL COORDINATES(E,N) SUPPLIED ARE MAPPING GRID OF AUSTRALIA(MGA), ZONE 56 BASED ON THE UNIVERSAL TRANSVERSE MERCATOR PROJECTION AND THE GEOCENTRIC DATUM OF AUSTRALIA 2020.
HORIZONTAL DATUM DERIVED FROM PM72109, E 490,729.557 N 7,001,736.666
LEVELS SUPPLIED ARE ON THE AUSTRALIAN HEIGHT DATUM(AHD)
LEVEL DATUM DERIVED FROM PM72109 RL 30.422 (AHD)

REGISTERED SURVEYOR'S CERTIFICATION

I, Veris Australia Pty Ltd, hereby certify that the vertical and horizontal locations and dimensions shown on this plan are a true and correct record and were located by survey.

Qld Registered Surveyor (sig.) | Qld Reg. Surveyor No. 6448 | Date 22/05/2025

ENGINEER'S CERTIFICATION

I, Michael Steer (Engineer's Name) being a Certificated/Registered Engineer and duly authorised representative of EGIS CONSULTING PTY LTD (Consulting firm or company)

Hereby:-

- certify the information contained in this drawing/file is an accurate "as constructed" representation of the works;
- accept responsibility for the "as constructed" information contained in this drawing/file; and
- acknowledge the "as constructed" information contained in this drawing/file map be relied on by the Council and others.

Certification for Stage 23 (Stage No) by Michael Steer (Signature) on 26.05.2025 (Date)

for EGIS CONSULTING PTY LTD (Company Name)

Registered Professional Engineering Company of Queensland 06900 (Number)

0 5 10 15 20 25m
SCALE 1:250 @A1

DRAWING REVISIONS		REFERENCE DRAWINGS	DESIGN FILE No.		DESIGNED	
REV.	REVISION DESCRIPTION	DESCRIPTION	CONSTRUCT. No.		DATE	
A	ORIGINAL 10/02/2025		SURVEY FILE No.	401871-23-AEW01	DRAWN	JMc
			FIELD BOOK		DATE	10/02/2025
			LOG BOOK		CHECKED	
			LEVEL DATUM	AHD	DATE	
			DATUM			

veris
BRISBANE (07) 3666 4700 WHITSUNDAYS (07) 4945 6900
MACKAY (07) 4957 9700 CAIRNS (07) 4252 9400
veris.com.au
ACN 615 735 727
Veris Australia Pty Ltd

..\..\..\250129 EGIS LOGO.png

SCALE 1:250 ORIGINAL SIZE A1

Moreton Bay Regional Council

MORETON BAY REGIONAL COUNCIL
CABOOLTURE DISTRICT OFFICE
2 HASKING STREET CABOOLTURE QLD 4510
PO BOX 159 CABOOLTURE QLD 4510
Telephone: (07) 5433 0100
Fax: (07) 5433 4000

OW NUMBER TBC
STAGE 23 LILYWOOD LANDINGS
AS CONSTRUCTED EARTHWORKS

MBRC SUBDIVISION REFERENCE
DA/____/____
No. 2 OF 3 PLANS
DRAWING NUMBER 401871-23-AEW01 REV. A

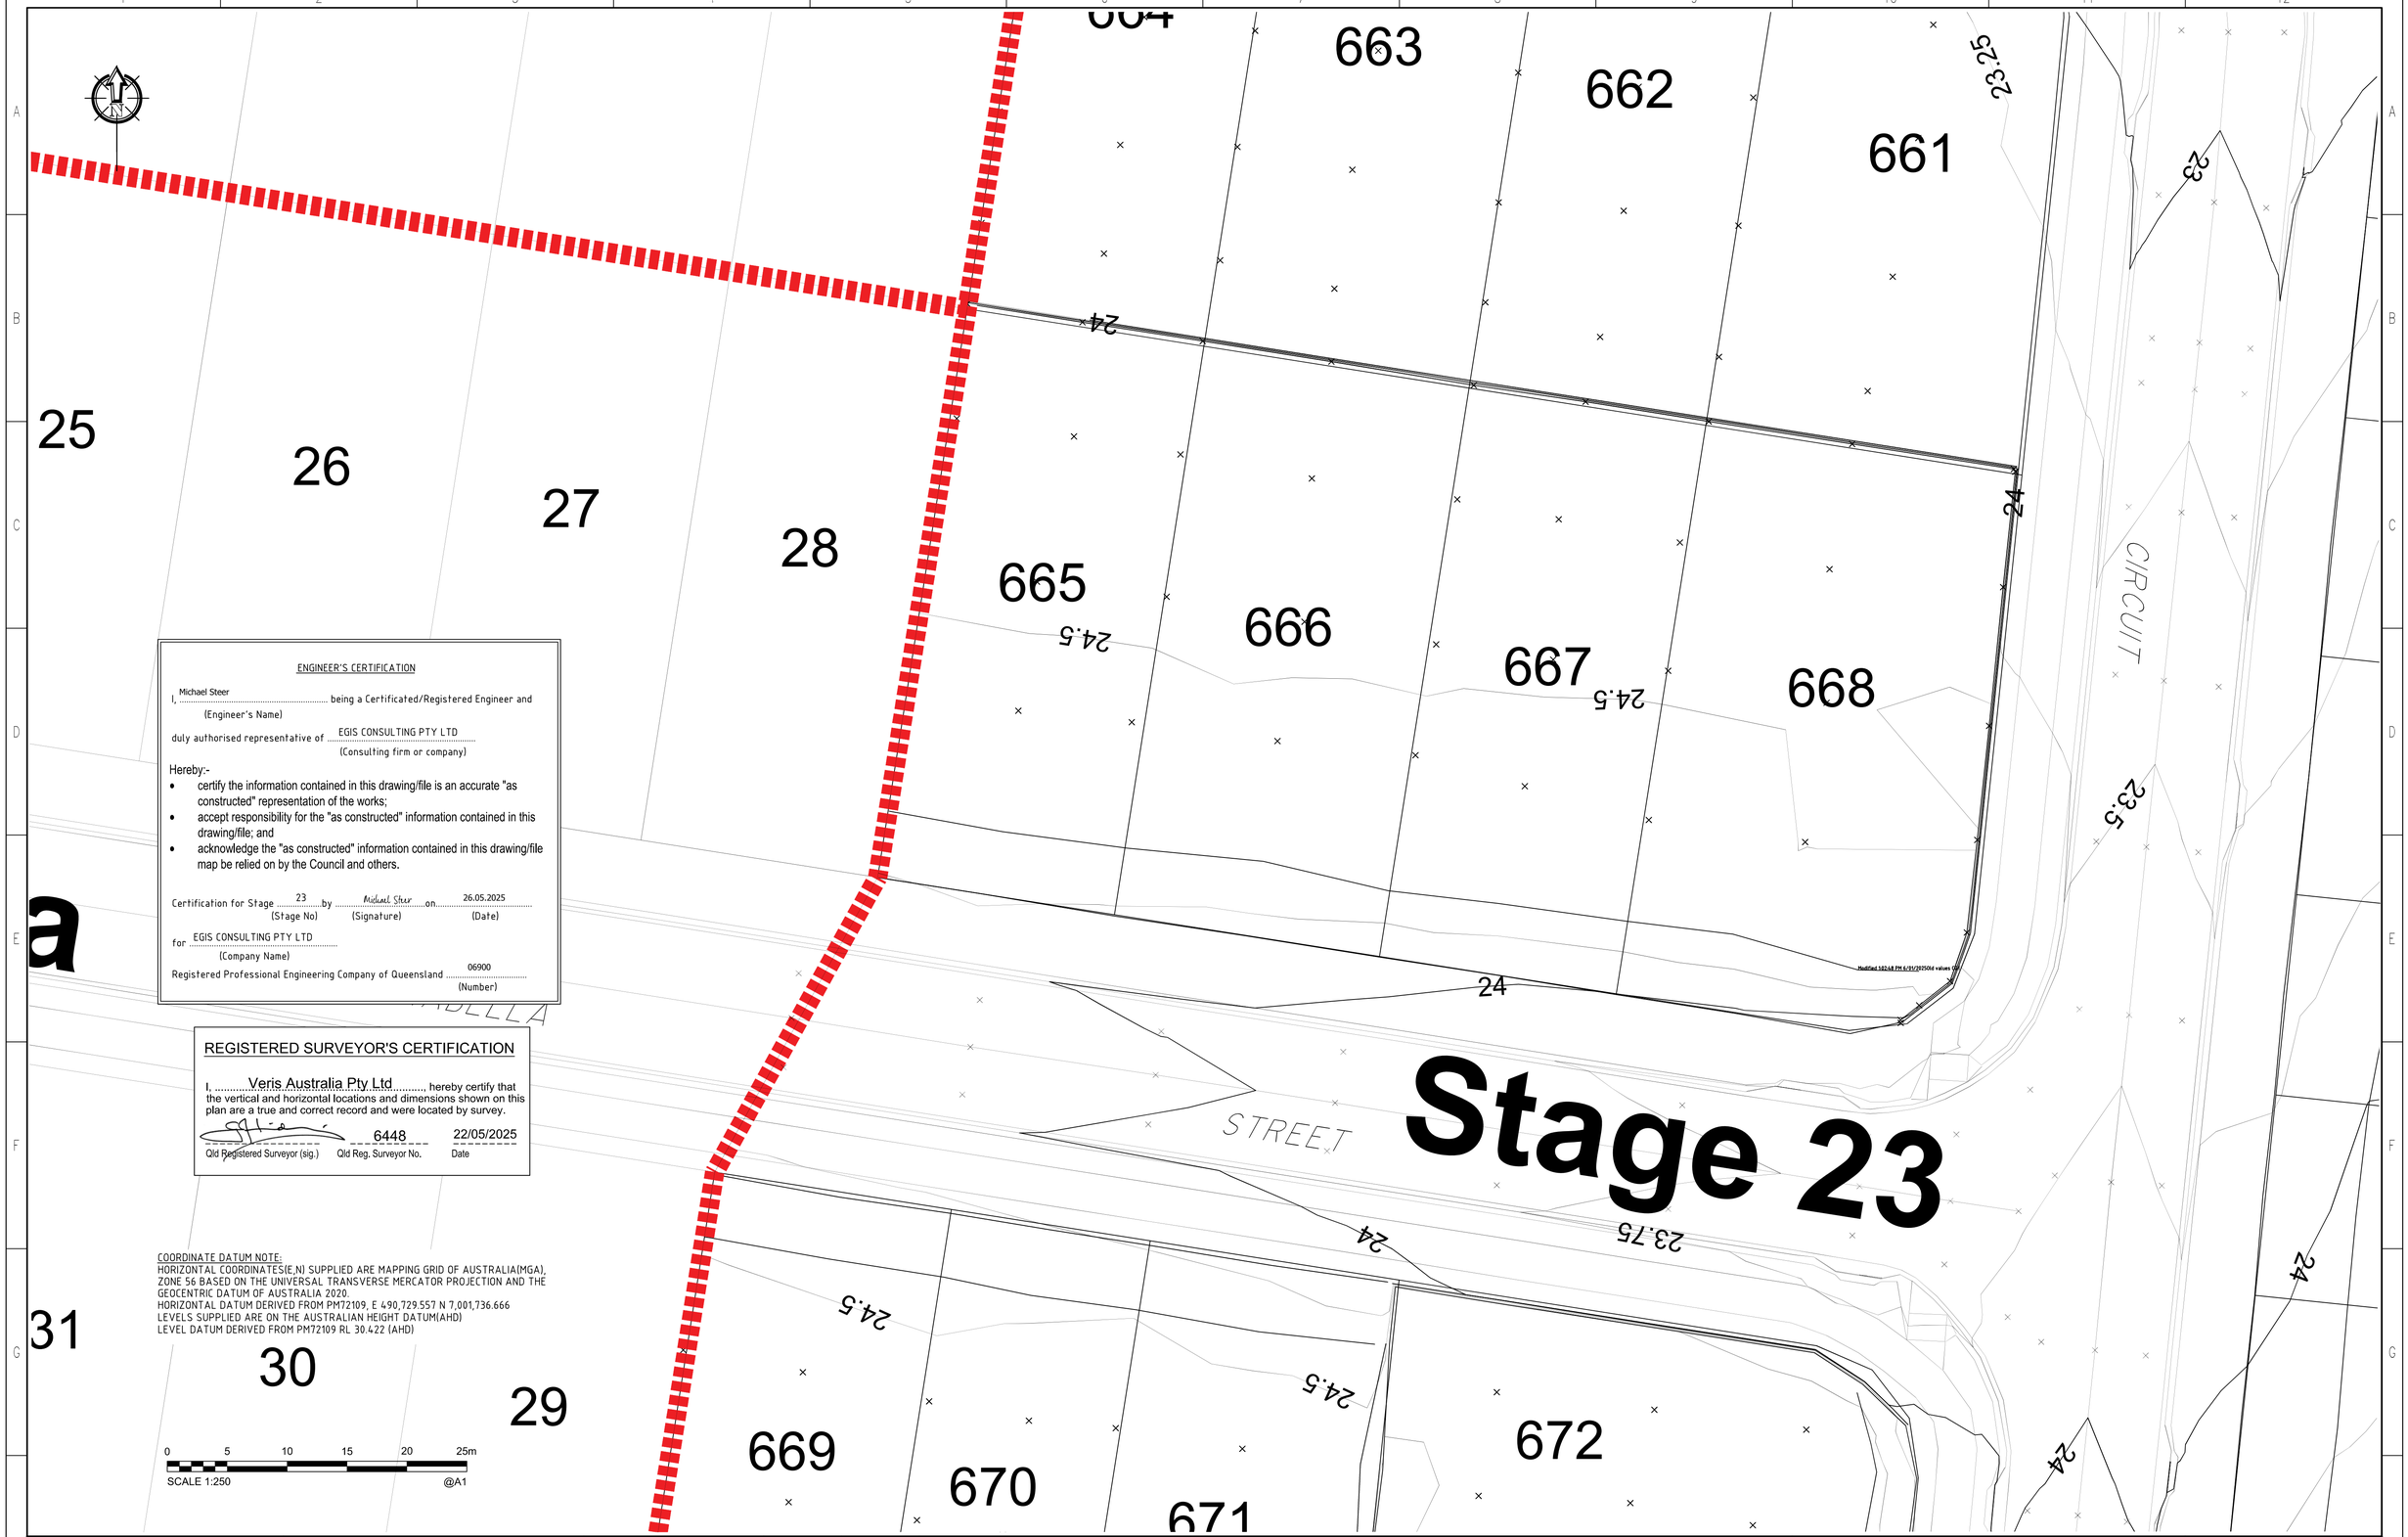

ENGINEER'S CERTIFICATION

I, Michael Steer (Engineer's Name) being a Certificated/Registered Engineer and duly authorised representative of EGIS CONSULTING PTY LTD (Consulting firm or company)

Hereby:-

- certify the information contained in this drawing/file is an accurate "as constructed" representation of the works;
- accept responsibility for the "as constructed" information contained in this drawing/file; and
- acknowledge the "as constructed" information contained in this drawing/file map be relied on by the Council and others.

Certification for Stage 23 (Stage No) by Michael Steer (Signature) on 26.05.2025 (Date)

for EGIS CONSULTING PTY LTD (Company Name)

Registered Professional Engineering Company of Queensland 06900 (Number)

REGISTERED SURVEYOR'S CERTIFICATION

I, Veris Australia Pty Ltd, hereby certify that the vertical and horizontal locations and dimensions shown on this plan are a true and correct record and were located by survey.

Qld Registered Surveyor (sig.) | Qld Reg. Surveyor No. 6448 | Date 22/05/2025

COORDINATE DATUM NOTE:
HORIZONTAL COORDINATES(E,N) SUPPLIED ARE MAPPING GRID OF AUSTRALIA(MGA), ZONE 56 BASED ON THE UNIVERSAL TRANSVERSE MERCATOR PROJECTION AND THE GEOCENTRIC DATUM OF AUSTRALIA 2020.
HORIZONTAL DATUM DERIVED FROM PM72109, E 490,729.557 N 7,001,736.666
LEVELS SUPPLIED ARE ON THE AUSTRALIAN HEIGHT DATUM(AHD)
LEVEL DATUM DERIVED FROM PM72109 RL 30.422 (AHD)

DRAWING REVISIONS			REFERENCE DRAWINGS				
REV.	REVISION DESCRIPTION		DESCRIPTION	DESIGN FILE No.		DESIGNED	
A	ORIGINAL	05/04/2023		CONSTRUCT. No.		DATE	
				SURVEY FILE No.	401871-1A-1B-AEW01	DRAWN	JMc
				FIELD BOOK		DATE	10/05/2024
				LOG BOOK		CHECKED	
				LEVEL DATUM	AHD	DATE	
				DATUM			

veris
BRISBANE (07) 3666 4700 WHITSUNDAYS (07) 4945 6600
MACKAY (07) 4957 9700 CAIRNS (07) 4252 9400
veris.com.au
ACN 615 735 727
Veris Australia Pty Ltd

SCALE 1:250 | ORIGINAL SIZE A1

Moreton Bay Regional Council

MORETON BAY REGIONAL COUNCIL
CABOOLTURE DISTRICT OFFICE
2 HASKING STREET CABOOLTURE QLD 4510
PO BOX 159 CABOOLTURE QLD 4510
Telephone: (07) 5433 0100
Fax: (07) 5433 4000

OW NUMBER TBC
STAGES 1A & 1B LILYWOOD LANDINGS
AS CONSTRUCTED
EARTHWORKS

MBRC SUBDIVISION REFERENCE
DA/2023/3491
No. 3 OF 3 PLANS

DRAWING NUMBER	REV.
401871-1A-1B-AEW01	C

COORDINATE DATUM NOTE:
HORIZONTAL COORDINATES(E,N) SUPPLIED ARE MAPPING GRID OF AUSTRALIA(MGA), ZONE 56 BASED ON THE UNIVERSAL TRANSVERSE MERCATOR PROJECTION AND THE GEOCENTRIC DATUM OF AUSTRALIA 2020.
HORIZONTAL DATUM DERIVED FROM PM72109, E 490,729.557 N 7,001,736.666
LEVELS SUPPLIED ARE ON THE AUSTRALIAN HEIGHT DATUM(AHD)
LEVEL DATUM DERIVED FROM PM72109 RL 30.422 (AHD)

REGISTERED SURVEYOR'S CERTIFICATION

I, Veris Australia Pty Ltd, hereby certify that the vertical and horizontal locations and dimensions shown on this plan are a true and correct record and were located by survey.

Qld Registered Surveyor (sig.) | 6448 Qld Reg. Surveyor No. | 22/05/2025 Date

ENGINEER'S CERTIFICATION

I, Michael Steer being a Certificated/Registered Engineer and
(Engineer's Name)
duly authorised representative of EGIS CONSULTING PTY LTD
(Consulting firm or company)

Hereby:-

- certify the information contained in this drawing/file is an accurate "as constructed" representation of the works;
- accept responsibility for the "as constructed" information contained in this drawing/file; and
- acknowledge the "as constructed" information contained in this drawing/file map be relied on by the Council and others.

Certification for Stage 23 (Stage No) by Michael Steer (Signature) on 26.05.2025 (Date)
for EGIS CONSULTING PTY LTD (Company Name)
Registered Professional Engineering Company of Queensland 06900 (Number)

0 5 10 15 20 25m
SCALE 1:250 @A1

DRAWING REVISIONS			REFERENCE DRAWINGS	DESIGN FILE No.		DESIGNED	
REV.	REVISION DESCRIPTION		DESCRIPTION	CONSTRUCT. No.		DATE	
A	ORIGINAL	05/04/2023		SURVEY FILE No.	401871-1A-1B-AEW01	DRAWN	JMc
				FIELD BOOK		DATE	10/05/2024
				LOG BOOK		CHECKED	
				LEVEL DATUM	AHD	DATE	
				DATUM			

veris
BRISBANE (07) 3666 4700 WHITSUNDAYS (07) 4945 6600
MACKAY (07) 4957 9700 CAIRNS (07) 4252 9400
veris.com.au
ACN 615 735 727
Veris Australia Pty Ltd

SCALE 1:250 ORIGINAL SIZE A1

Moreton Bay Regional Council
MORETON BAY REGIONAL COUNCIL
CABOOLTURE DISTRICT OFFICE
2 HASKING STREET CABOOLTURE QLD 4510
PO BOX 159 CABOOLTURE QLD 4510
Telephone: (07) 5433 0100
Fax: (07) 5433 4000

OW NUMBER TBC
STAGES 1A & 1B LILYWOOD LANDINGS
AS CONSTRUCTED EARTHWORKS

MBRC SUBDIVISION REFERENCE
DA/2023/3491
No. 3 OF 3 PLANS
DRAWING NUMBER 401871-1A-1B-AEW01 REV. C