PSM 72109
E: 490729.557
N: 7001736.666
RL: 30.422m

Registered Surveyor's Certification.

We, VERIS AUSTRALIA P/L hereby certify that the horizontal and vertical locations, and dimensions shown on this plan are a true and correct record of the As Constructed information.

Signed _____ Cadastral Surveyor & Delegate Reg No. 6448

Dated 04/11/2025

LEGEND

New Water Service Conduit (Ø100 uPVC PN9)

Conduit — New Water Meter

New Water House connection

RT	Ø100 Stop Valve	9	Ø100 Temp Duckfoot Hyrdant
1	Ø100 Fire Hydrant	10	Ø100 1° Deflection
2	Ø100x Ø100 Tee	11	Ø100 2° Deflection
3	Ø100 Dead End Cap	12	Ø150 Stop Valve
4	Ø100 11.25° BEND	13	Ø150 Fire Hydrant
5	Ø100 22.5° BEND	14	Ø100x Ø150 Tee
6	Ø100 45° BEND	15	Ø100x Ø150 Reducer
7	Ø100 90° BEND	16	Ø150 22.5° BEND
8			

ENGINEER'S CERTIFICATION

I, _____, hereby certify that:
1. The information contained in this drawing / document is in compliance with approved drawings and design.
2. The new water and sewerage works defined by this drawing have been designed and constructed in accordance with the SEQ Code.
3. This represents an accurate record of as-constructed works
4. I accept responsibility for the information contained in this drawing / document.

_____
RPEQ (signature) RPEQ No. _____ Date:

COORDINATE DATUM NOTE:

HORIZONTAL COORDINATES(E,N) SUPPLIED ARE MAPPING GRID OF AUSTRALIA(MGA), ZONE 56 BASED ON THE UNIVERSAL TRANSVERSE MERCATOR PROJECTION AND THE GEOCENTRIC DATUM OF AUSTRALIA 2020.

AS CONSTRUCTED

0 15 30 45 60 75m
SCALE 1:750 @A1

A1

INDEX	DATE	REVISIONS	DRAWN	CHECKED	PASSED
B	10/09/2025	AS CONSTRUCTED	AD		
A	14/08/2025	PROGRESS PLOT	JMc		

	INITIALS	DATE
DRAWN	JMc	14/08/2025
CHECKED		
PASSED		

veris
BRISBANE (07) 3666 4700 · WHITSUNDAYS (07) 4945 9909 · MACKAY (07) 4957 9700 · CAIRNS (07) 4052 9400
veris.com.au
ACN 615 735 727 Veris Australia Pty Ltd

egis

Unitywater

Unitywater

LILYWOOD LANDINGS
STAGE 3
AS CONSTRUCTED WATER

SHEET 1 OF 3 SHEETS		SCALE	1:750
REVISION DATE	10/09/2025	REVISION	B
DISCIPLINE CODE	C		
DRAWING NO.	U-2025-5876-WAT		

PSM 72109
E: 490729.557
N: 7001736.666
RL: 30.422m

ASHFORD CRESCENT

PEMBROKE DRIVE

WATERFORD CIRCUIT

WATERFORD CIRCUIT

Emt SF

Emt D

157

163

164

165

166

167

168

169

17

81

82

83

84

85

86

87

88

80

79

78

77

76

75

Live Connection#1

Live Connection#2

PVC-U PN16 Ø150

DI PN20 Ø150

PVC-U PN16 Ø100

DI PN20 Ø100

Conduit

RT

1.4

1.5

1.6

SEE SHEET 3

Registered Surveyor's Certification.

I, VERIS AUSTRALIA P/L hereby certify that the horizontal and vertical locations, and dimensions shown on this plan are a true and correct record of the As Constructed information.

Signed _____ Cadastral & Delegate Reg No. 6448

Dated 04/11/2025

LEGEND

New Water Service Conduit (Ø100 uPVC PN9)

Conduit

New Water Meter

New Water House connection

RT

1 Ø100 Stop Valve
2 Ø100 Fire Hydrant
3 Ø100x Ø100 Tee
4 Ø100 Dead End Cap
5 Ø100 11.25° BEND
6 Ø100 22.5° BEND
7 Ø100 45° BEND
8 Ø100 90° BEND
9 Ø100 Temp Duckfoot Hyrdant
10 Ø100 1° Deflection
11 Ø100 2° Deflection
12 Ø150 Stop Valve
13 Ø150 Fire Hydrant
14 Ø100x Ø150 Tee
15 Ø100x Ø150 Reducer
16 Ø150 22.5° BEND

ENGINEER'S CERTIFICATION

I, _____, hereby certify that:
1. The information contained in this drawing / document is in compliance with approved drawings and design.
2. The new water and sewerage works defined by this drawing have been designed and constructed in accordance with the SEQ Code.
3. This represents an accurate record of as-constructed works
4. I accept responsibility for the information contained in this drawing / document.

_____
RPEQ (signature) RPEQ No. _____ Date:

COORDINATE DATUM NOTE:
HORIZONTAL COORDINATES(E,N) SUPPLIED ARE MAPPING GRID OF AUSTRALIA(MGA), ZONE 56 BASED ON THE UNIVERSAL TRANSVERSE MERCATOR PROJECTION AND THE GEOCENTRIC DATUM OF AUSTRALIA 2020.

AS CONSTRUCTED

0 5 10 15 20 25m
SCALE 1:250 @A1

A1

INDEX	DATE	REVISIONS	DRAWN	CHECKED	PASSED
B	10/09/2025	AS CONSTRUCTED	AD		
A	14/08/2025	PROGRESS PLOT	JMc		

	INITIALS	DATE
DRAWN	JMc	14/08/2025
CHECKED		
PASSED		

veris
BRISBANE (07) 3906 4700 WHITSUNDAYS (07) 4945 6600
MACKAY (07) 4957 9700 CAIRNS (07) 4052 3400
veris.com.au
ACN 615 735 727
Veris Australia Pty Ltd

egis

Unitywater

Unitywater

LILYWOOD LANDINGS
STAGE 3
AS CONSTRUCTED WATER

SHEET 2 OF 3 SHEETS	SCALE 1:250
REVISION DATE 10/09/2025	REVISION A
DISCIPLINE CODE C	
DRAWING NO. U-2025-5876-WAT	

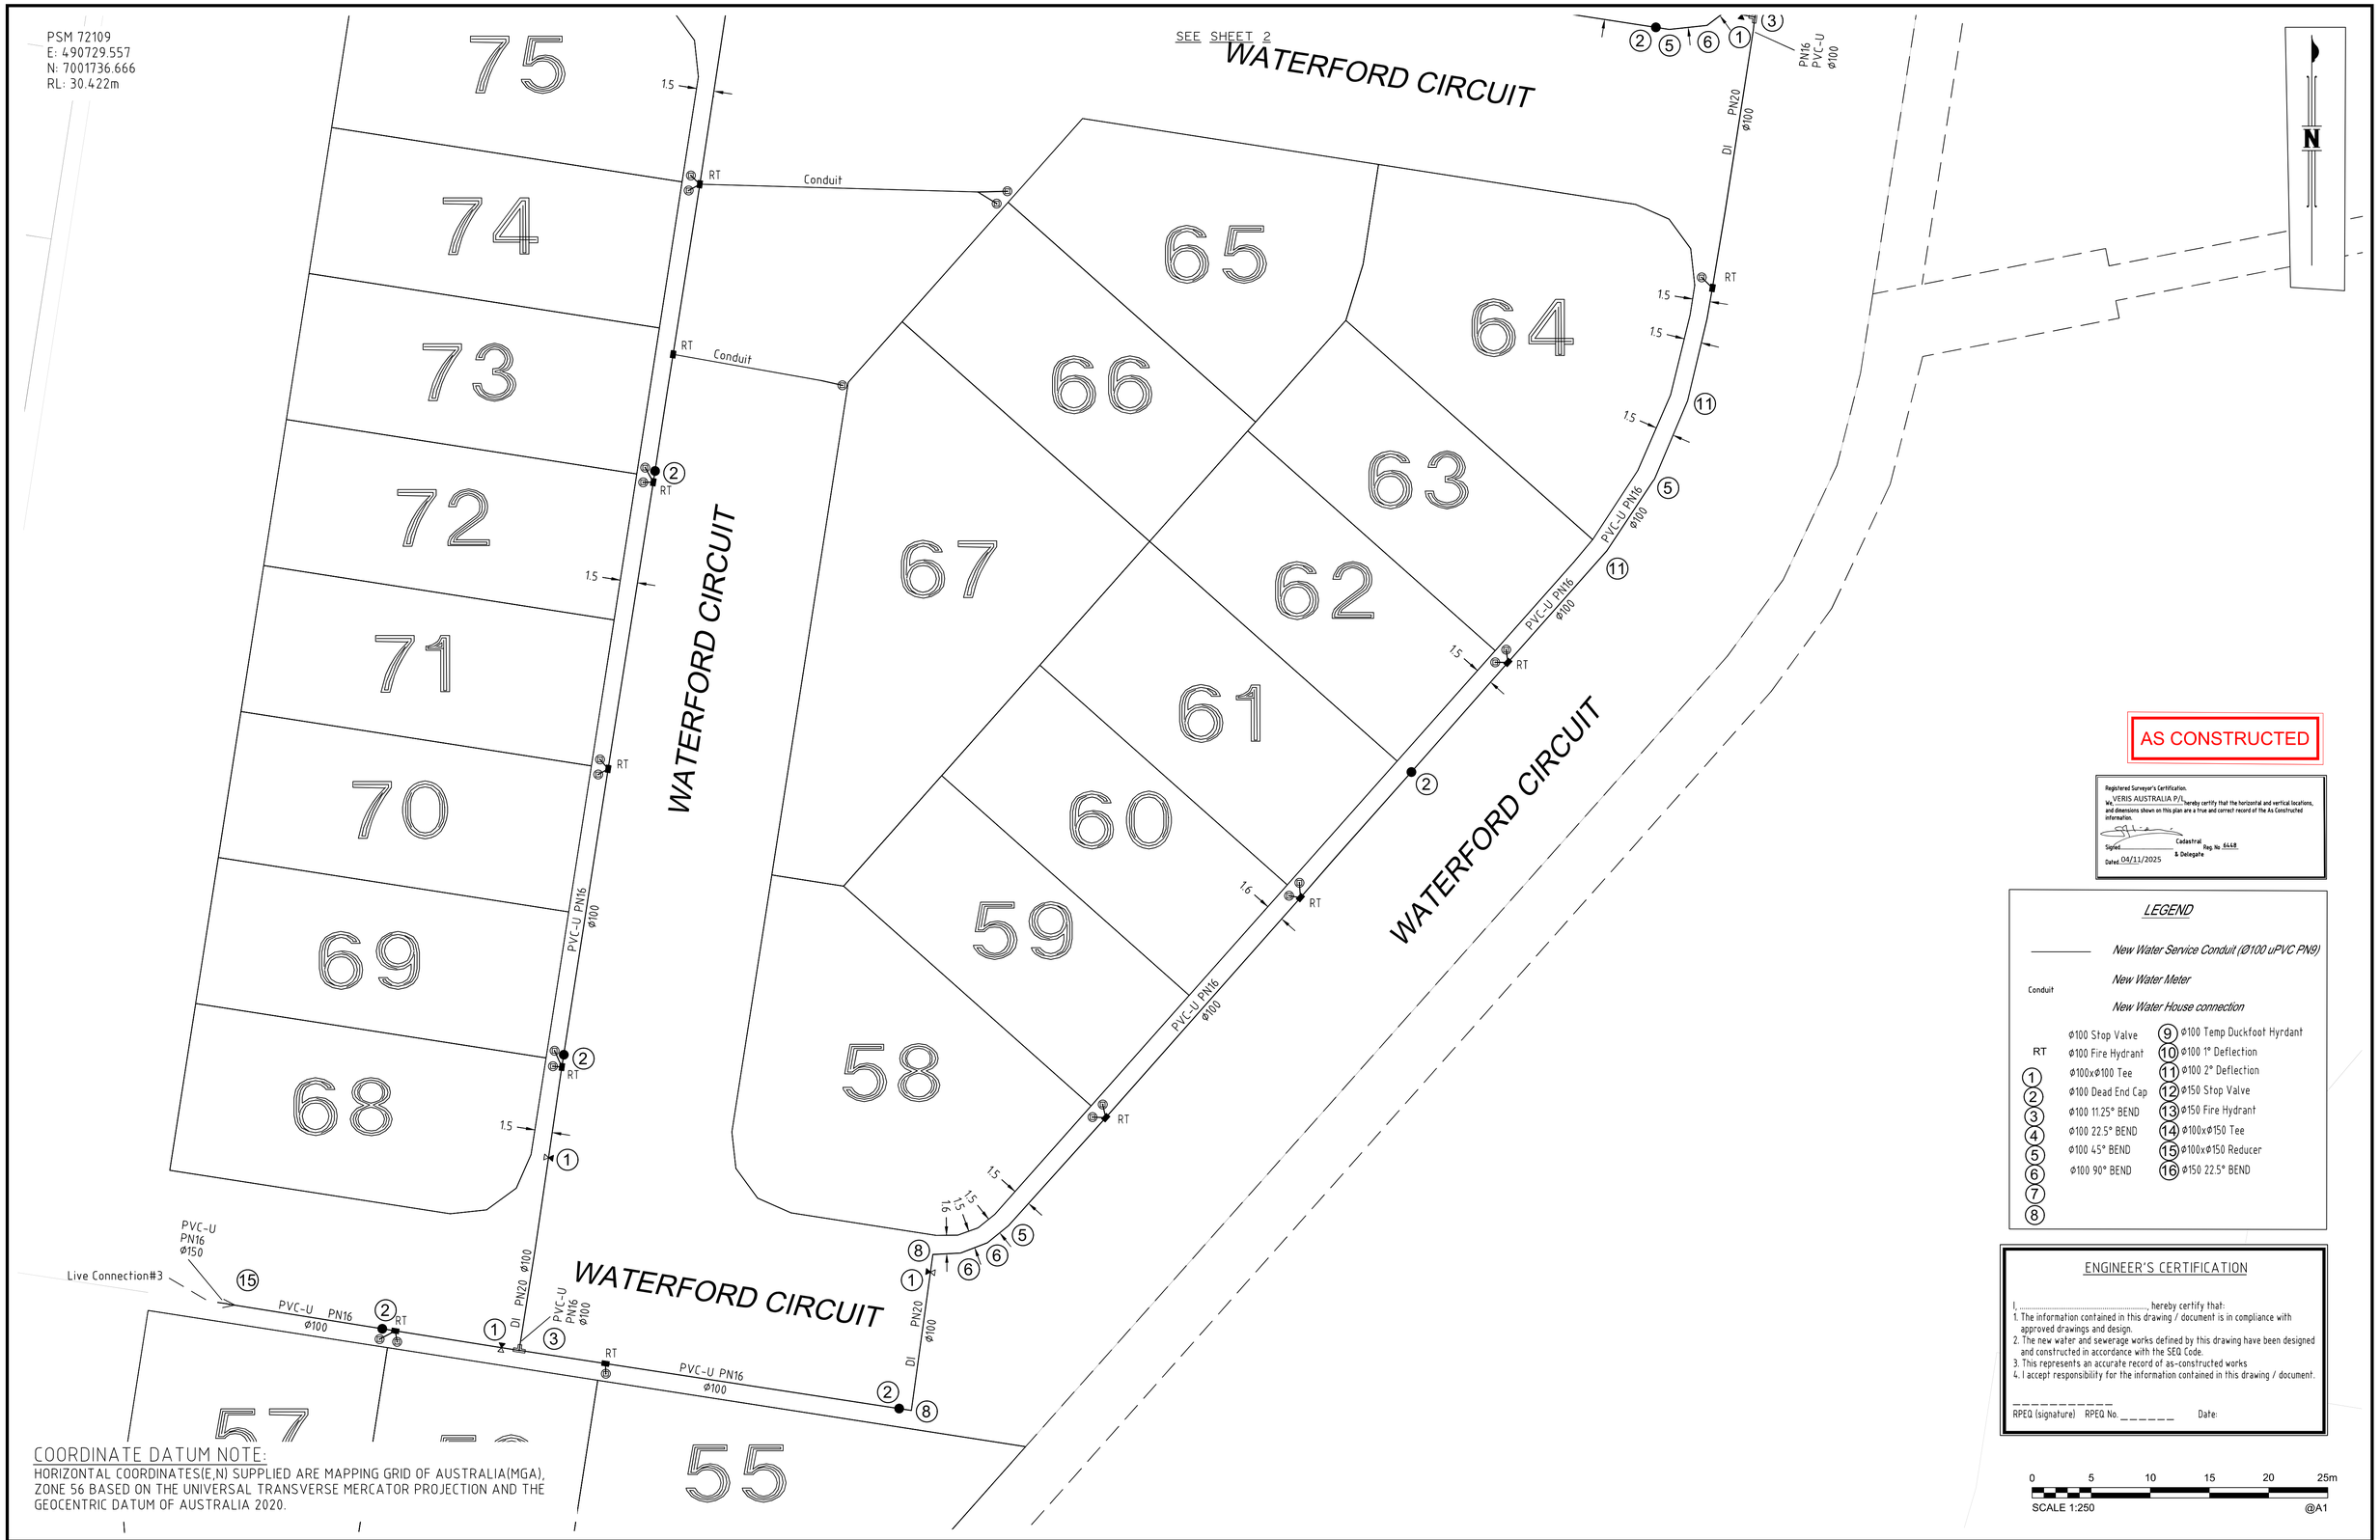

AS CONSTRUCTED

Registered Surveyor's Certification.
We, VERIS AUSTRALIA P/L hereby certify that the horizontal and vertical locations, and dimensions shown on this plan are a true and correct record of the As Constructed information.
Signed _____ Cadastral & Delegate Reg. No. 6448
Dated 04/11/2025

LEGEND

———	New Water Service Conduit (Ø100 uPVC PN9)
Conduit	New Water Meter
	New Water House connection

	Ø100 Stop Valve	9	Ø100 Temp Duckfoot Hyrdant
RT	Ø100 Fire Hydrant	10	Ø100 1° Deflection
1	Ø100xØ100 Tee	11	Ø100 2° Deflection
2	Ø100 Dead End Cap	12	Ø150 Stop Valve
3	Ø100 11.25° BEND	13	Ø150 Fire Hydrant
4	Ø100 22.5° BEND	14	Ø100xØ150 Tee
5	Ø100 45° BEND	15	Ø100xØ150 Reducer
6	Ø100 90° BEND	16	Ø150 22.5° BEND
7			
8			

ENGINEER'S CERTIFICATION

I, ..., hereby certify that:
1. The information contained in this drawing / document is in compliance with approved drawings and design.
2. The new water and sewerage works defined by this drawing have been designed and constructed in accordance with the SEQ Code.
3. This represents an accurate record of as-constructed works
4. I accept responsibility for the information contained in this drawing / document.

_____
RPEQ (signature) RPEQ No. _____ Date:

0 5 10 15 20 25m
SCALE 1:250 @A1

COORDINATE DATUM NOTE:

HORIZONTAL COORDINATES(E,N) SUPPLIED ARE MAPPING GRID OF AUSTRALIA(MGA), ZONE 56 BASED ON THE UNIVERSAL TRANSVERSE MERCATOR PROJECTION AND THE GEOCENTRIC DATUM OF AUSTRALIA 2020.

A1

INDEX	DATE	REVISIONS	DRAWN	CHECKED	PASSED
B	10/09/2025	AS CONSTRUCTED	AD		
A	14/08/2025	PROGRESS PLOT	JMc		

	INITIALS	DATE
DRAWN	JMc	14/08/2025
CHECKED		
PASSED		

veris
BRISBANE (07) 3666 4700 WHITSUNDAYS (07) 4945 6600
MACKAY (07) 4957 9700 CAIRNS (07) 4052 9400
veris.com.au
ACN 615 735 727
Veris Australia Pty Ltd

egis

Unitywater

Unitywater

LILYWOOD LANDINGS
STAGE 3
AS CONSTRUCTED WATER

SHEET 3 OF 3 SHEETS		SCALE	1:250
REVISION DATE	10/09/2025	REVISION	A
DISCIPLINE CODE	C		
DRAWING NO.	U-2025-5876-WAT		