COORDINATE DATUM NOTE:

HORIZONTAL COORDINATES(E,N) SUPPLIED ARE MAPPING GRID OF AUSTRALIA(MGA), ZONE 56 BASED ON THE UNIVERSAL TRANSVERSE MERCATOR PROJECTION AND THE GEOCENTRIC DATUM OF AUSTRALIA 2020.

PSM 72109
E: 490729.557
N: 7001736.666
RL: 30.422m

16.5m Wide Road

SHEET 2

SHEET 3

PEMBROKE DRIVE

Emt AD

Emt AF

Emt DA

Emt E

Emt SD

Bioretention Basin

Council Drainage

EMT A RP103205

EMT AY SP205829

EMT AW SP205797

1002 SP344049

1006

1007

1102 SP292555

1108

1109

1110

1128

1111

SP

292555

EM SP2(

Emi

OSE

REGISTERED SURVEYOR'S CERTIFICATION

I, Veris Australia Pty Ltd, hereby certify that the vertical and horizontal locations and dimensions shown on this plan are a true and correct record and were located by survey.

Qld Registered Surveyor (sig.) | 6448 Qld Reg. Surveyor No. | Date

ENGINEERS CERTIFICATION

I ..... hereby certify that:

1. The information contained in this drawing / document is in compliance with approved drawings and design.
2. This represents an accurate record of as-constructed works.
3. I accept responsibility for the information contained in this drawing / document. In accepting this responsibility we have relied upon information provided by others.

CERTIFICATION FOR PRECINCT 11 STAGE 23

RPEQ Signature ..... RPEQ No..... Date.....

For and on behalf of EGIS CONSULTING PTY LTD:

AS CONSTRUCTED

0 10 20 30 40 50m
SCALE 1:500 @A1

DRAWING REVISIONS		REFERENCE DRAWINGS
REV.	REVISION DESCRIPTION	DESCRIPTION
A	ORIGINAL 25/11/2025	

DESIGN FILE No.		DESIGNED	
CONSTRUCT. No.		DATE	
SURVEY FILE No.	401871-5-ASW01-A	DRAWN	AD
FIELD BOOK		DATE	25/11/2025
LOG BOOK		CHECKED	
LEVEL DATUM	AHD	DATE	
DATUM			

veris
BRISBANE (07) 3666 4700 WHITSUNDAYS (07) 4945 6600
MACKAY (07) 4957 9700 CAIRNS (07) 4052 9400
veris.com.au
ACN 615 735 727
Veris Australia Pty Ltd

egis

SCALE 1:500 ORIGINAL SIZE A1

CITY OF MORETON BAY
CABOOLTURE DISTRICT OFFICE
2 HASKING STREET CABOOLTURE QLD 4510
PO BOX 159 CABOOLTURE QLD 4510
Telephone: (07) 3205 0555
Email: council@moretonbay.qld.gov.au

OW NUMBER 22-000082_5
LILYWOOD LANDINGS STAGE 5
AS CONSTRUCTED STORMWATER

MBRC SUBDIVISION REFERENCE	
DA 2021/4669	
No. 1 OF 3 PLANS	
DRAWING NUMBER	REV.
401871-5-ASW01-A	A

COORDINATE DATUM NOTE:

HORIZONTAL COORDINATES(E,N) SUPPLIED ARE MAPPING GRID OF AUSTRALIA(MGA), ZONE 56 BASED ON THE UNIVERSAL TRANSVERSE MERCATOR PROJECTION AND THE GEOCENTRIC DATUM OF AUSTRALIA 2020.

PSM 72109
E: 490729.557
N: 7001736.666
RL: 30.422m

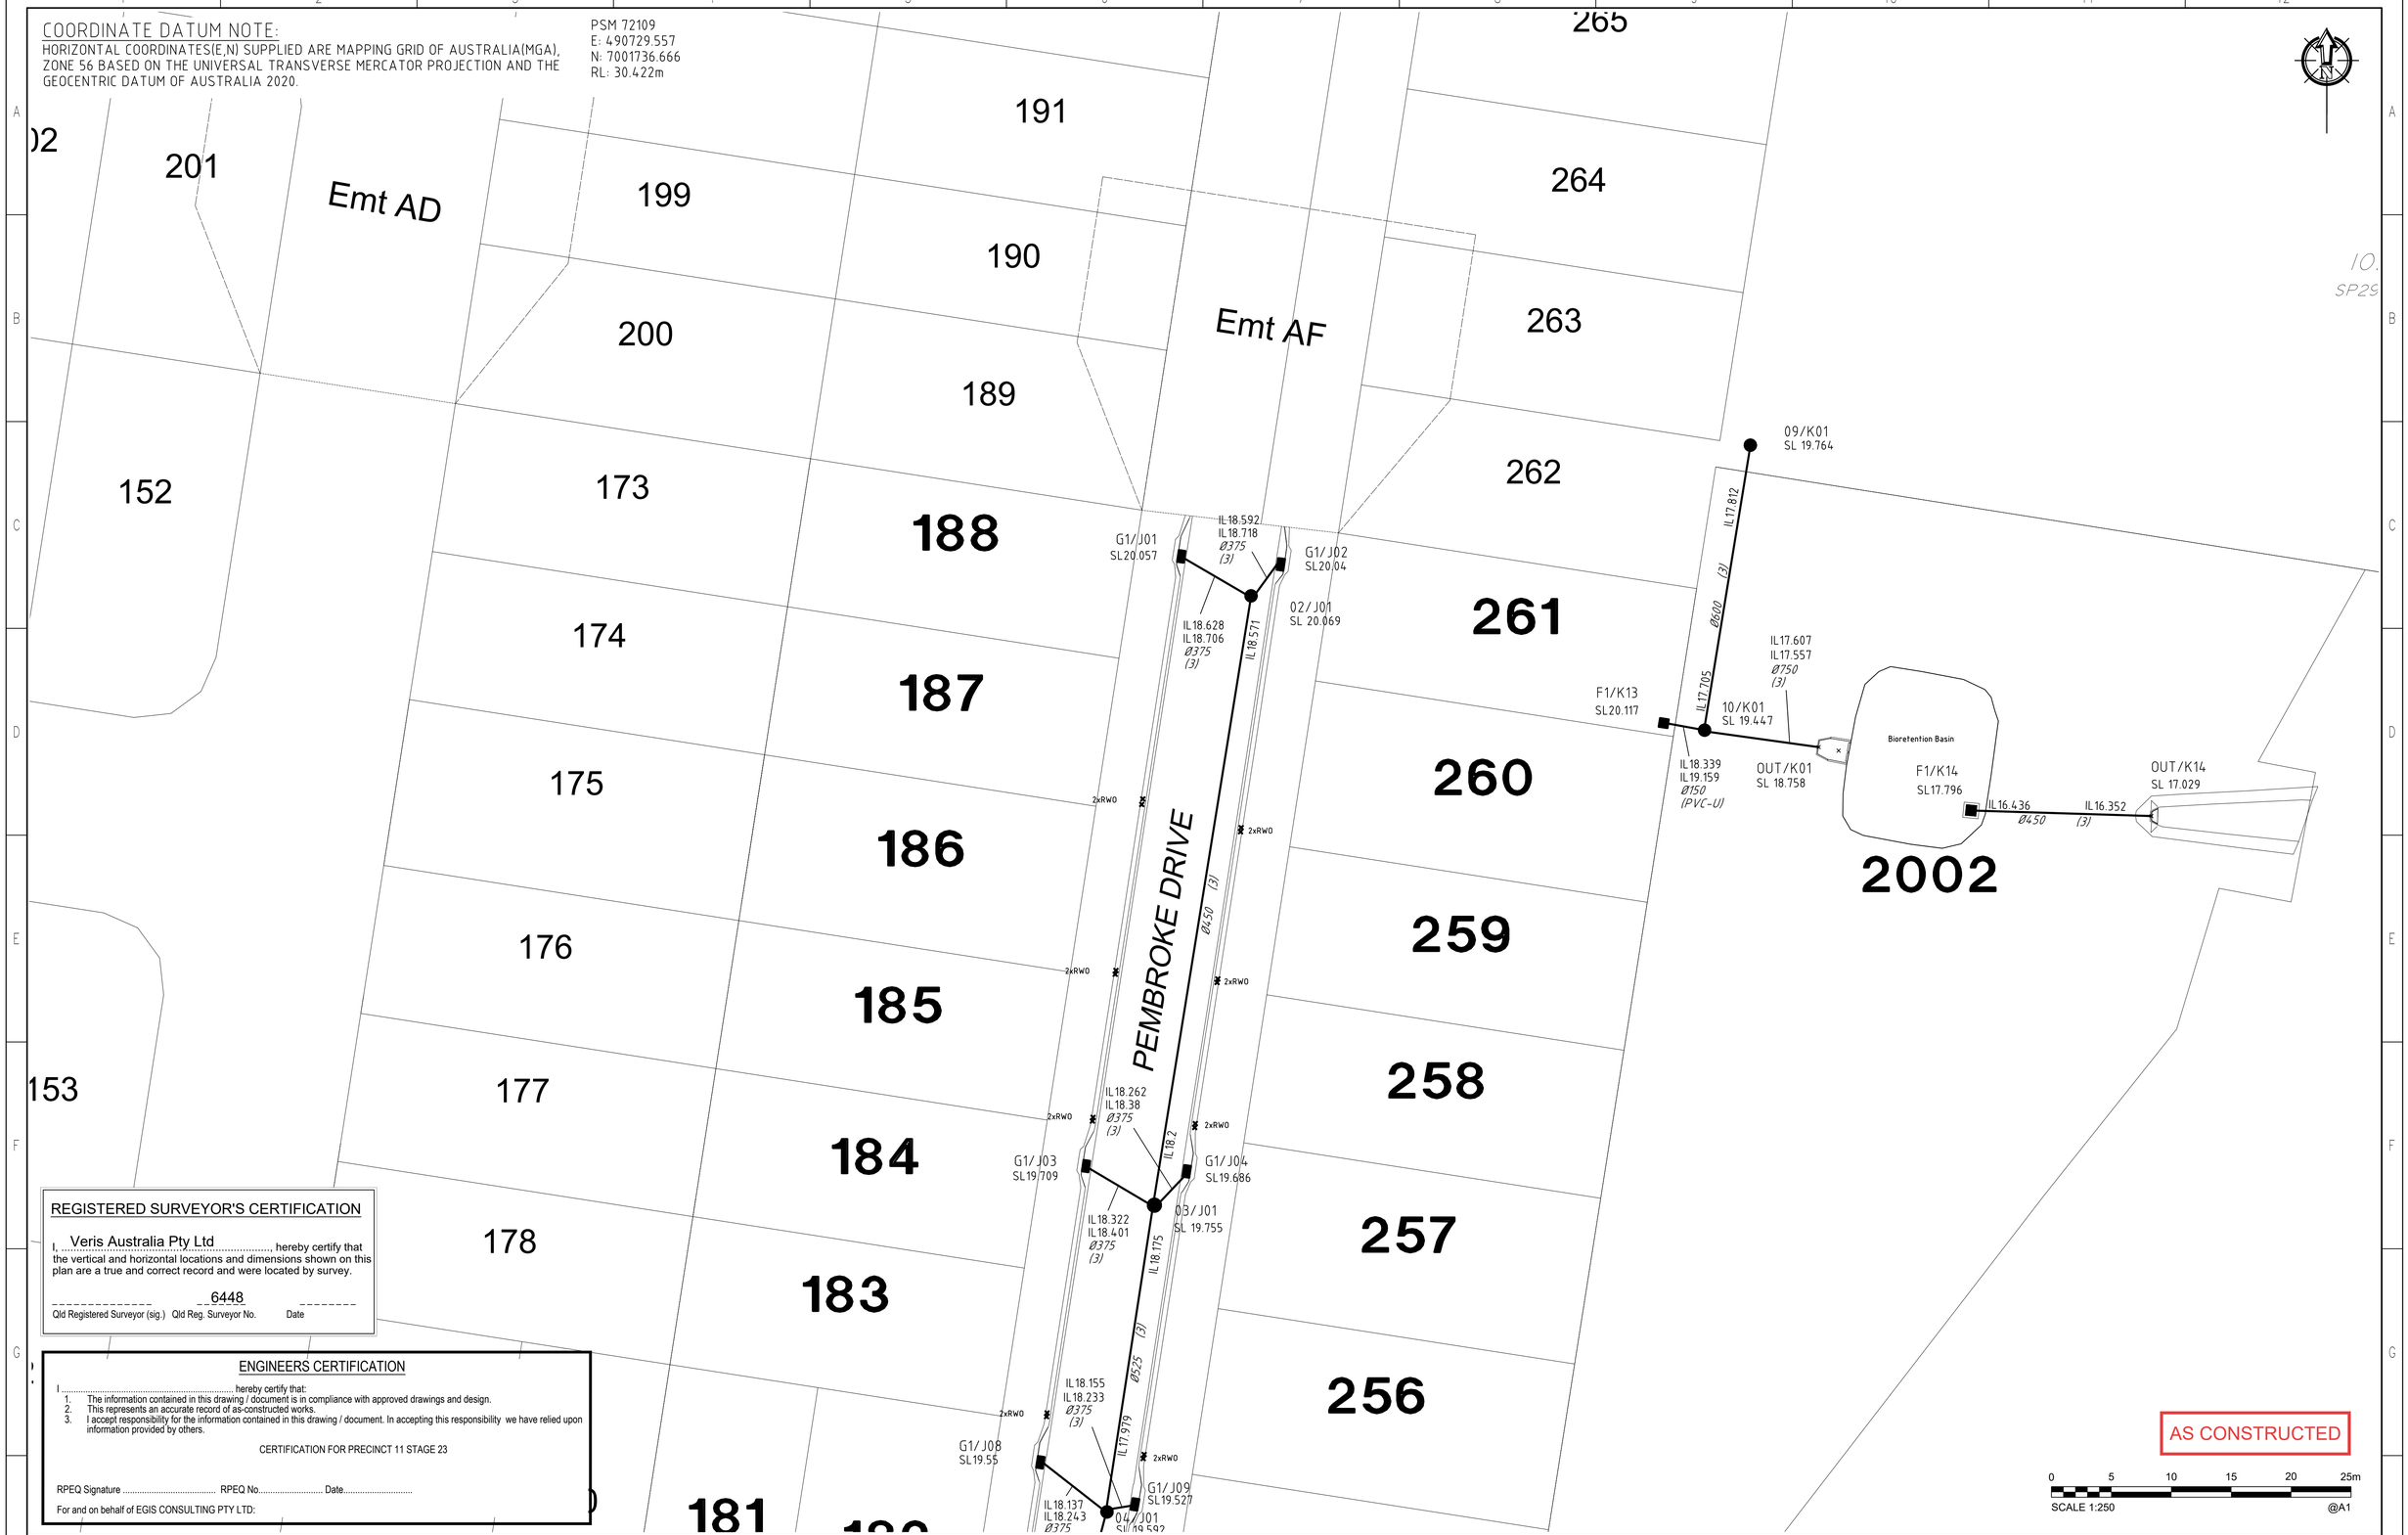

REGISTERED SURVEYOR'S CERTIFICATION

I, Veris Australia Pty Ltd, hereby certify that the vertical and horizontal locations and dimensions shown on this plan are a true and correct record and were located by survey.

_____ 6448 _____
Qld Registered Surveyor (sig.) Qld Reg. Surveyor No. Date

ENGINEERS CERTIFICATION

I ..... hereby certify that:

1. The information contained in this drawing / document is in compliance with approved drawings and design.
2. This represents an accurate record of as-constructed works.
3. I accept responsibility for the information contained in this drawing / document. In accepting this responsibility we have relied upon information provided by others.

CERTIFICATION FOR PRECINCT 11 STAGE 23

RPEQ Signature ..... RPEQ No..... Date.....

For and on behalf of EGIS CONSULTING PTY LTD:

AS CONSTRUCTED

0 5 10 15 20 25m
SCALE 1:250 @A1

DRAWING REVISIONS		REFERENCE DRAWINGS
REV.	REVISION DESCRIPTION	DESCRIPTION
A	ORIGINAL 25/11/2025	

DESIGN FILE No.		DESIGNED	
CONSTRUCT. No.		DATE	
SURVEY FILE No.	401871-5-ASW01-A	DRAWN	AD
FIELD BOOK		DATE	25/11/2025
LOG BOOK		CHECKED	
LEVEL DATUM	AHD	DATE	
DATUM			

veris
BRISBANE (07) 3696 4700 WHITSUNDAYS (07) 4945 6600
MACKAY (07) 4957 9700 CAIRNS (07) 4052 9400
veris.com.au
ACN 615 735 727
Veris Australia Pty Ltd
egis

SCALE 1:250 ORIGINAL SIZE A1

CITY OF MORETON BAY
CABOOLTURE DISTRICT OFFICE
2 HASKING STREET CABOOLTURE QLD 4510
PO BOX 159 CABOOLTURE QLD 4510
Telephone: (07) 3205 0555
Email: council@moretonbay.qld.gov.au

OW NUMBER 22-000082_5
LILYWOOD LANDINGS STAGE 5
AS CONSTRUCTED STORMWATER

MBRC SUBDIVISION REFERENCE	
DA 2021/4669	
No. 2 OF 3 PLANS	
DRAWING NUMBER	REV.
401871-5-ASW01-A	A

COORDINATE DATUM NOTE:

HORIZONTAL COORDINATES(E,N) SUPPLIED ARE MAPPING GRID OF AUSTRALIA(MGA), ZONE 56 BASED ON THE UNIVERSAL TRANSVERSE MERCATOR PROJECTION AND THE GEOCENTRIC DATUM OF AUSTRALIA 2020.

PSM 72109
E: 490729.557
N: 7001736.666
RL: 30.422m

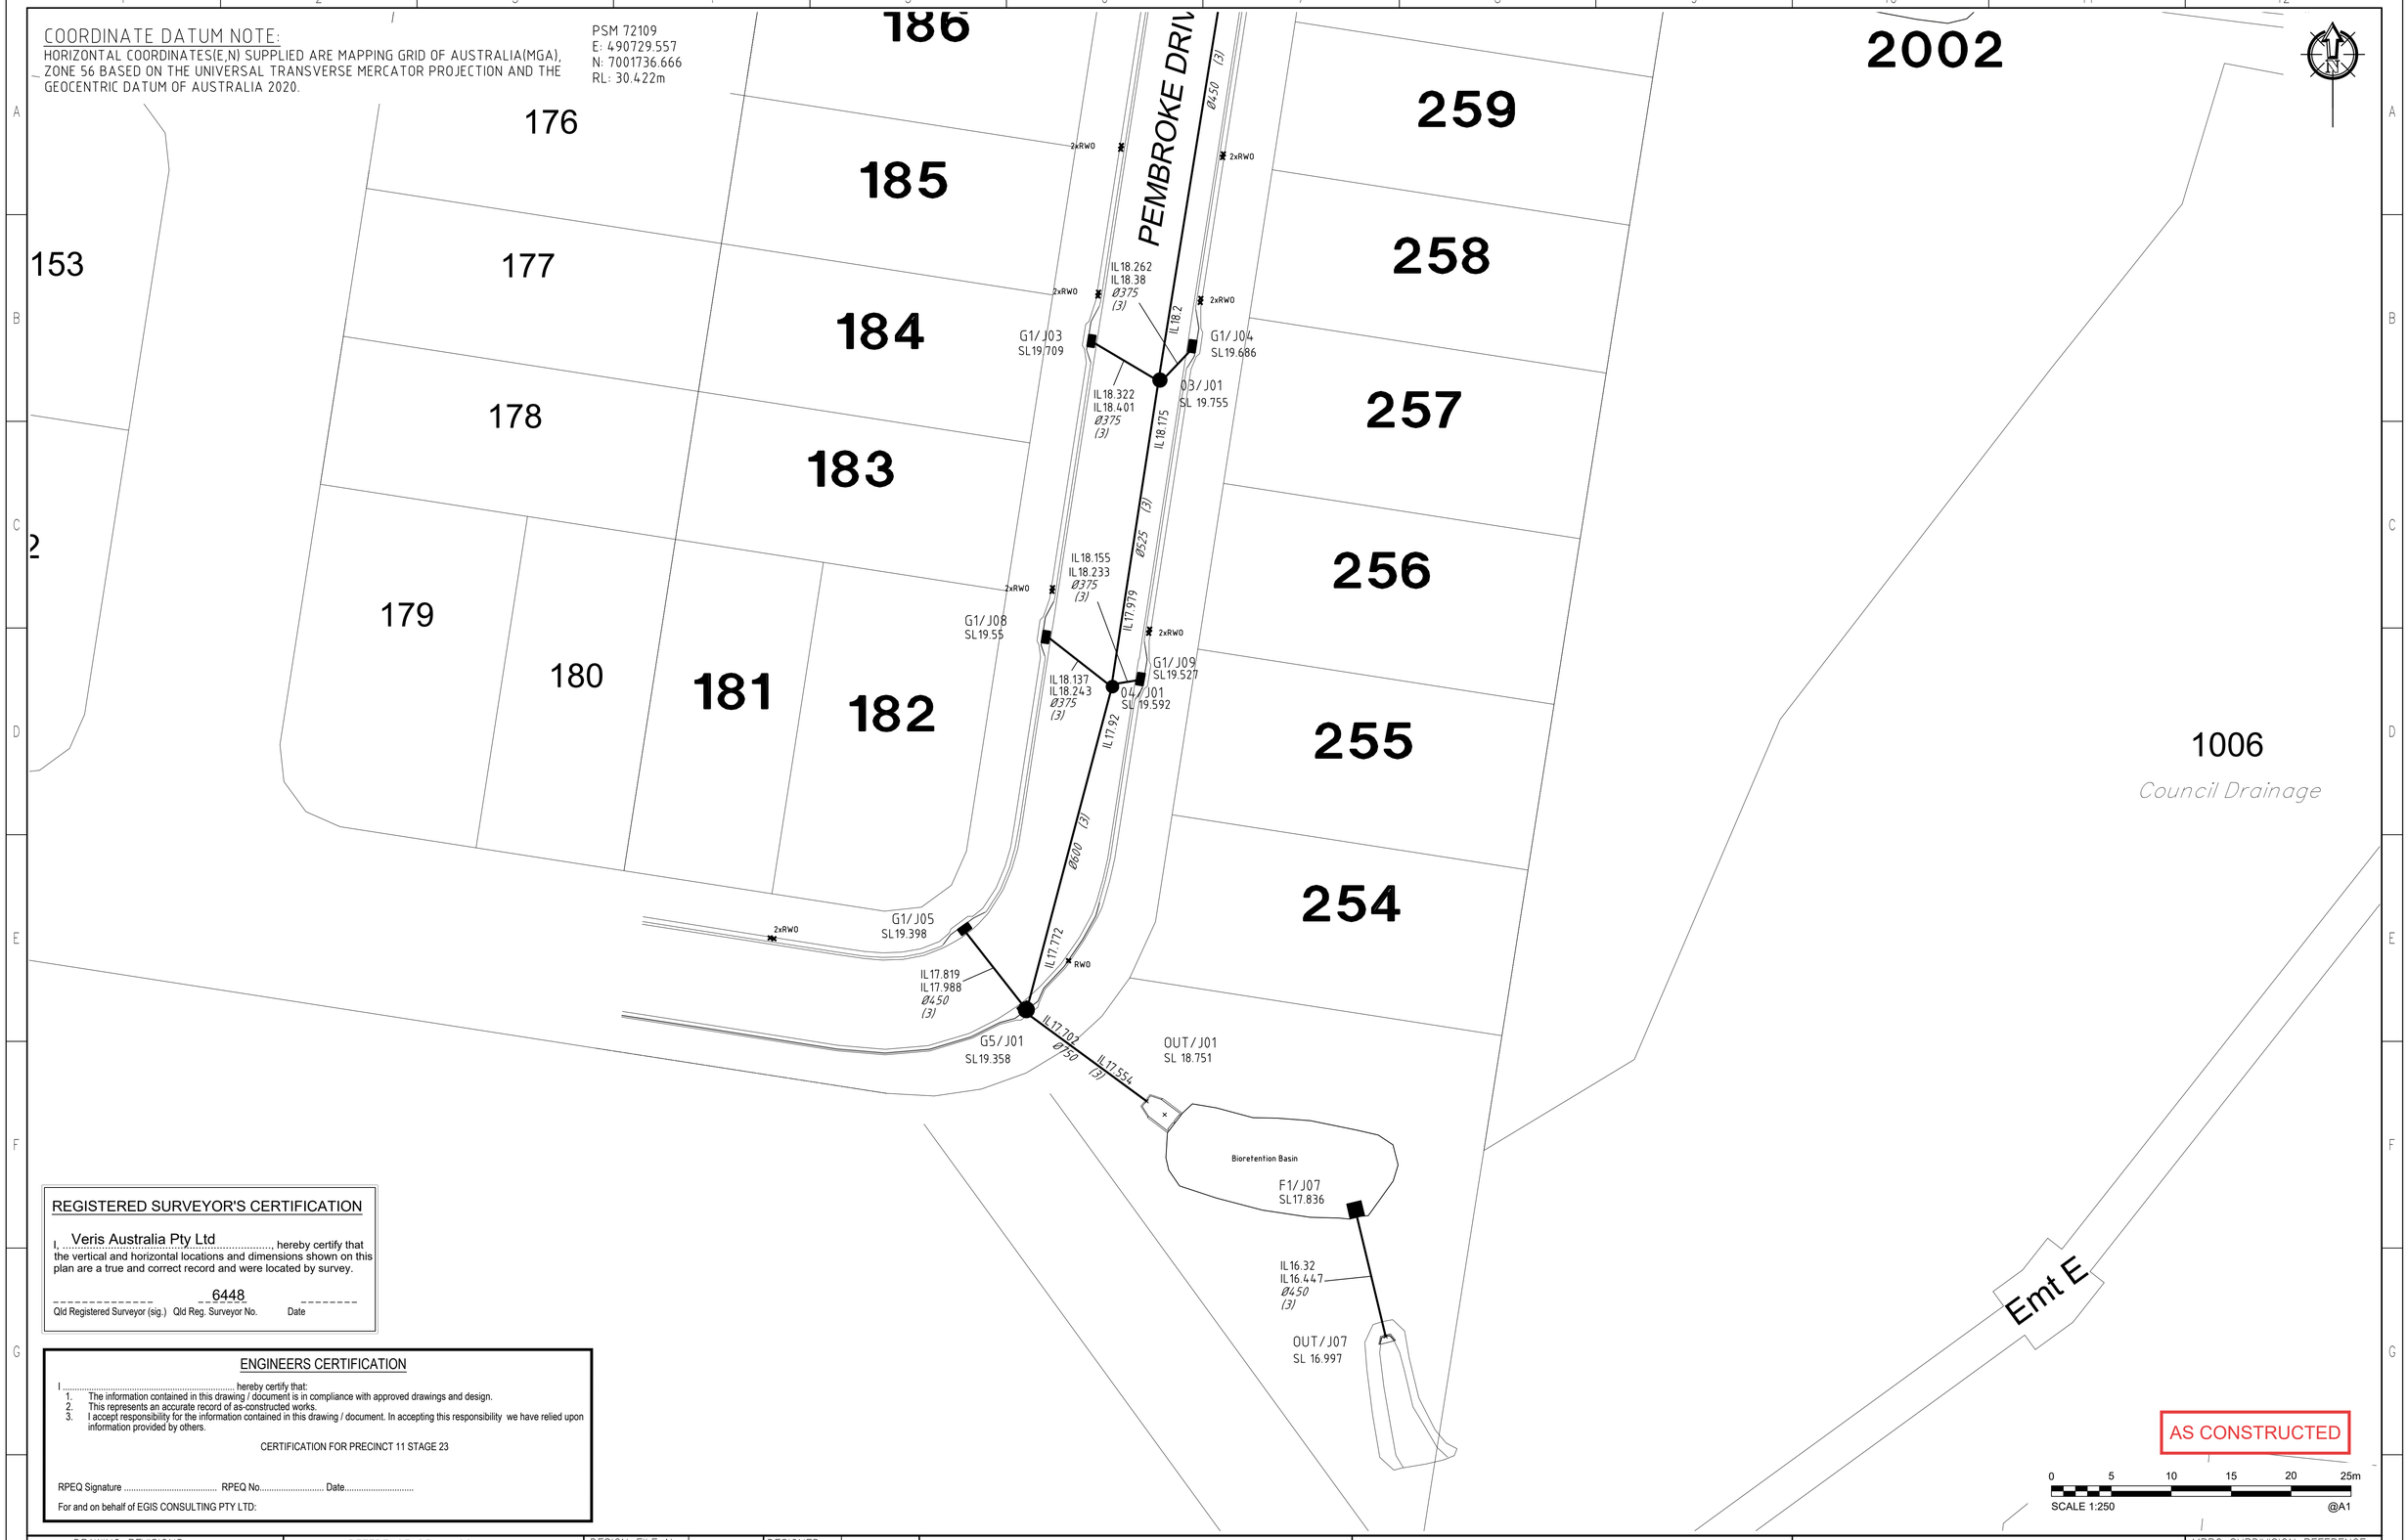

AS CONSTRUCTED

0 5 10 15 20 25m
SCALE 1:250 @A1

REGISTERED SURVEYOR'S CERTIFICATION

I, Veris Australia Pty Ltd, hereby certify that the vertical and horizontal locations and dimensions shown on this plan are a true and correct record and were located by survey.

Qld Registered Surveyor (sig.) | Qld Reg. Surveyor No. 6448 | Date

ENGINEERS CERTIFICATION

I ..... hereby certify that:

1. The information contained in this drawing / document is in compliance with approved drawings and design.
2. This represents an accurate record of as-constructed works.
3. I accept responsibility for the information contained in this drawing / document. In accepting this responsibility we have relied upon information provided by others.

CERTIFICATION FOR PRECINCT 11 STAGE 23

RPEQ Signature ..... RPEQ No..... Date.....

For and on behalf of EGIS CONSULTING PTY LTD:

DRAWING REVISIONS		REFERENCE DRAWINGS
REV.	REVISION DESCRIPTION	DESCRIPTION
A	ORIGINAL 25/11/2025	

DESIGN FILE No.		DESIGNED			
CONSTRUCT. No.		DATE			
SURVEY FILE No.	401871-5-ASW01-A	DRAWN	AD		
FIELD BOOK		DATE	25/11/2025		
LOG BOOK		CHECKED			
LEVEL DATUM	AHD	DATE			
DATUM					

veris — BRISBANE (07) 3666 4700 · WHITSUNDAYS (07) 4945 6600 · MACKAY (07) 4957 9700 · CAIRNS (07) 4052 9400 · veris.com.au · ACN 615 735 727 · Veris Australia Pty Ltd

egis

SCALE 1:250 | ORIGINAL SIZE A1

CITY OF MORETON BAY

CITY OF MORETON BAY
CABOOLTURE DISTRICT OFFICE
2 HASKING STREET CABOOLTURE QLD 4510
PO BOX 159 CABOOLTURE QLD 4510
Telephone: (07) 3205 0555
Email: council@moretonbay.qld.gov.au

OW NUMBER 22-000082_5
LILYWOOD LANDINGS STAGE 5
AS CONSTRUCTED STORMWATER

MBRC SUBDIVISION REFERENCE	
DA 2021/4669	
No. 3 OF 3 PLANS	
DRAWING NUMBER	REV.
401871-5-ASW01-A	A