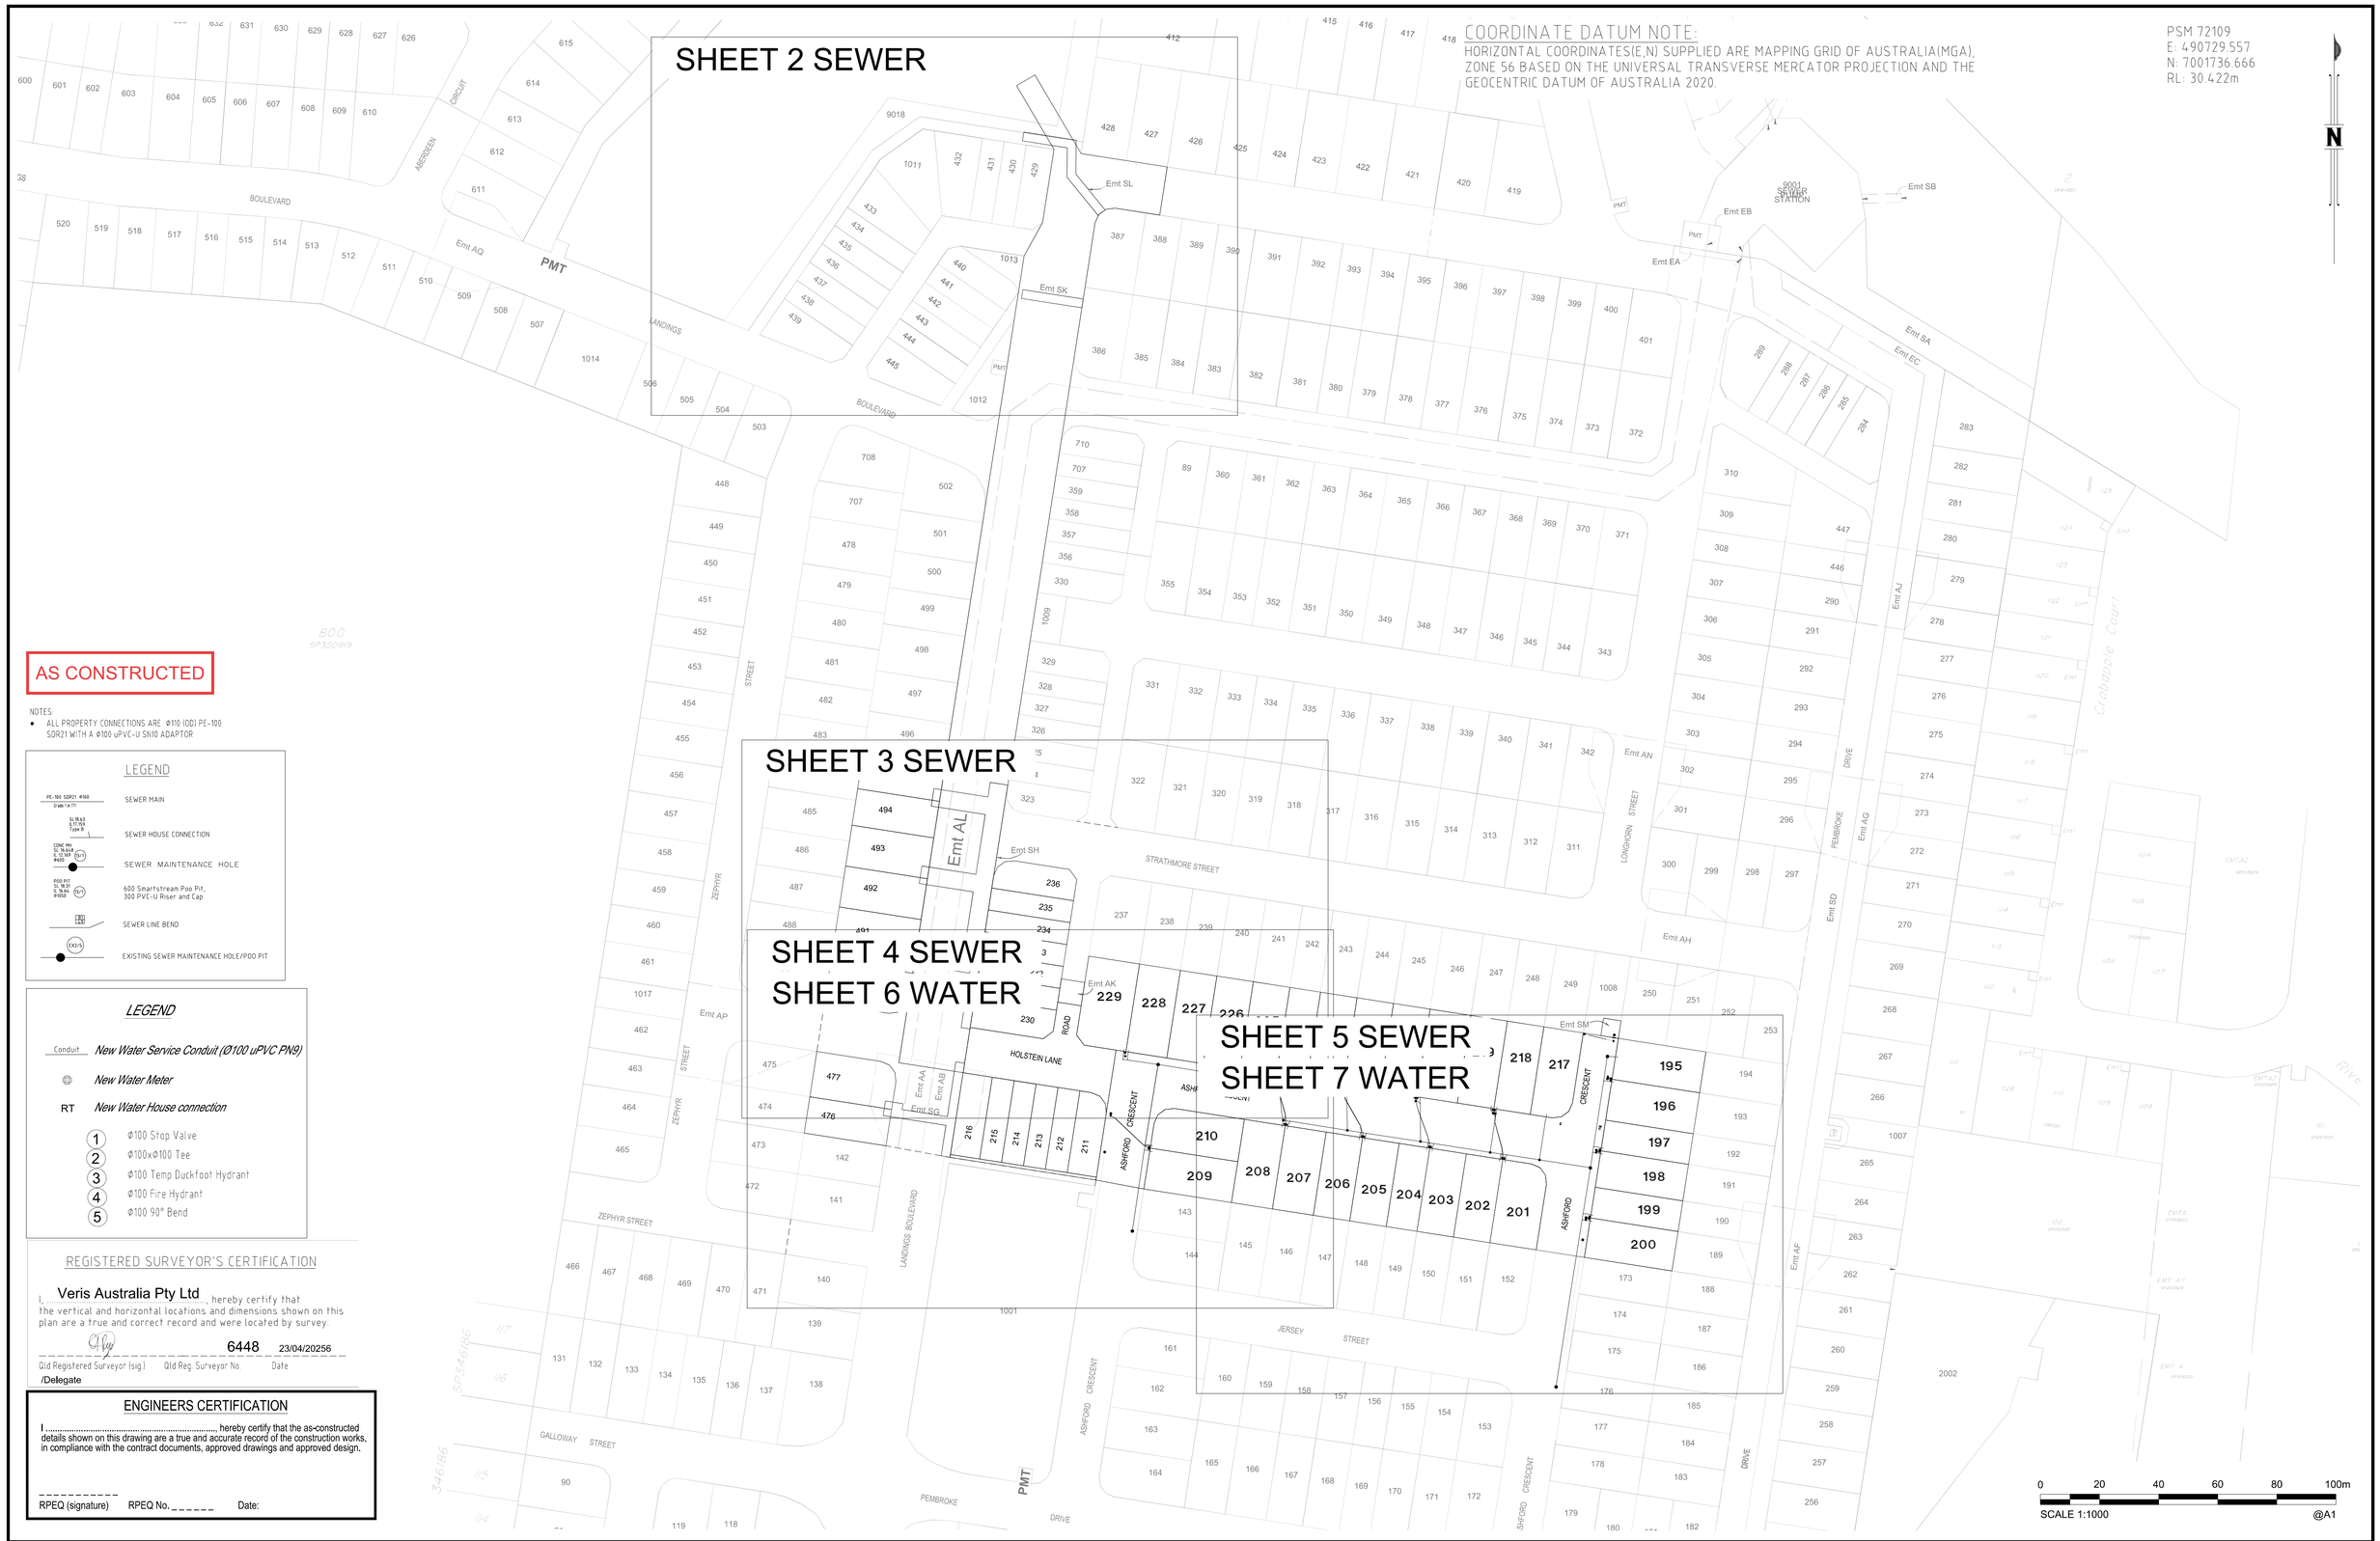

A1	INDEX	DATE	REVISIONS	DRAWN	CHECKED	PASSED
	D	22/04/2026	AS CONSTRUCTED	JMc		
	C	10/04/2026	AS CONSTRUCTED	JMc		
	B	12/03/2026	AS CONSTRUCTED	AD		
	A	04/03/2026	PROGRESS PLOT	AD		

	INITIALS	DATE
DRAWN	AD	04/03/2026
CHECKED		
PASSED		

CONSULTING SURVEYOR
veris
BRISBANE (07) 3666 4700 WHITSUNDAYS (07) 4945 6600
MACKAY (07) 4957 9700 CAIRNS (07) 4252 9400
veris.com.au
ACN 615 735 727
Veris Australia Pty Ltd

egis

Unitywater

Unitywater

Lilywood Landings
Stage 8
As Constructed Sewer and Water

SHEET 1 OF 7 SHEETS		SCALE	1:1000
REVISION DATE	22/04/2026	REVISION	D
DISCIPLINE CODE	C		
DRAWING NO.	UW-2025-6231-8		

COORDINATE DATUM NOTE:
HORIZONTAL COORDINATES(E,N) SUPPLIED ARE MAPPING GRID OF AUSTRALIA(MGA), ZONE 56 BASED ON THE UNIVERSAL TRANSVERSE MERCATOR PROJECTION AND THE GEOCENTRIC DATUM OF AUSTRALIA 2020.

PSM 72109
E: 490729.557
N: 7001736.666
RL: 30.422m

N

9018
1011
432
431
430
429
428
427
426
433
434
435
436
437
438
439
440
441
442
443
444
445
1013
1012
Emt SL
Emt SK
PMT
387
388
389
386
385
384
383
BOULEVARD

0 5 10 15 20 25m
SCALE 1:250 @A1

AS CONSTRUCTED

NOTES:
- ALL PROPERTY CONNECTIONS ARE Φ110 (OD) PE-100 SDR21 WITH A Φ100 uPVC-U SN10 ADAPTOR

LEGEND

- SEWER MAIN
- SEWER HOUSE CONNECTION
- SEWER MAINTENANCE HOLE
- 600 Smartstream Poo Pit, 300 PVC-U Riser and Cap
- SEWER LINE BEND
- EXISTING SEWER MAINTENANCE HOLE/POO PIT

REGISTERED SURVEYOR'S CERTIFICATION

I, Veris Australia Pty Ltd, hereby certify that the vertical and horizontal locations and dimensions shown on this plan are a true and correct record and were located by survey.

Qld Registered Surveyor (sig.) /Delegate | Qld Reg. Surveyor No. 6448 | Date 23/04/2026

ENGINEERS CERTIFICATION

I ..... hereby certify that the as-constructed details shown on this drawing are a true and accurate record of the construction works, in compliance with the contract documents, approved drawings and approved design.

RPEQ (signature) RPEQ No. _____ Date:

A1

INDEX	DATE	REVISIONS	DRAWN	CHECKED	PASSED
D	22/04/2026	AS CONSTRUCTED			
C	10/04/2026	AS CONSTRUCTED	JMc		
B	12/03/2026	AS CONSTRUCTED	AD		
A	04/03/2026	PROGRESS PLOT	AD		

	INITIALS	DATE
DRAWN	AD	12/03/2026
CHECKED		
PASSED		

CONSULTING SURVEYOR
veris
BRISBANE (07) 3666 4700 WHITSUNDAYS (07) 4945 6600
MACKAY (07) 4957 9700 CAIRNS (07) 4252 9400
veris.com.au
ACN 615 735 727
Veris Australia Pty Ltd

egis

Unitywater

Unitywater

LILYWOOD LANDINGS
STAGE 8
AS CONSTRUCTED SEWER AND WATER

SHEET 2 OF 7 SHEETS		SCALE	1:250
REVISION DATE	22/04/2026	REVISION	D
DISCIPLINE CODE	C		
DRAWING NO.	UW-2025-6231-8		

A1

INDEX	DATE	REVISIONS	DRAWN	CHECKED	PASSED
D	22/04/2026	AS CONSTRUCTED			
C	10/04/2026	AS CONSTRUCTED	JMc		
B	12/03/2026	AS CONSTRUCTED	AD		
A	04/03/2026	PROGRESS PLOT	AD		

	INITIALS	DATE
DRAWN	AD	12/03/2026
CHECKED		
PASSED		

CONSULTING SURVEYOR
veris
BRISBANE (07) 3666 4700 WHITSUNDAYS (07) 4945 6600
MACKAY (07) 4957 9700 CAIRNS (07) 4252 9400
veris.com.au
ACN 615 735 727
Veris Australia Pty Ltd

egis

Unitywater

Unitywater

LILYWOOD LANDINGS
STAGE 8
AS CONSTRUCTED SEWER AND WATER

SHEET 3 OF 7 SHEETS		SCALE	1:250
REVISION DATE	22/04/2026	REVISION	D
DISCIPLINE CODE	C		
DRAWING NO.	UW-2025-6231-8		

COORDINATE DATUM NOTE:
HORIZONTAL COORDINATES(E,N) SUPPLIED ARE MAPPING GRID OF AUSTRALIA(MGA), ZONE 56 BASED ON THE UNIVERSAL TRANSVERSE MERCATOR PROJECTION AND THE GEOCENTRIC DATUM OF AUSTRALIA 2020.

PSM 72109
E: 490729.557
N: 7001736.666
RL: 30.422m

N

AS CONSTRUCTED

NOTES:
- ALL PROPERTY CONNECTIONS ARE Ø110 (OD) PE-100 SDR21 WITH A Ø100 uPVC-U SN10 ADAPTOR

LEGEND

- SEWER MAIN
- SEWER HOUSE CONNECTION
- SEWER MAINTENANCE HOLE
- 600 Smartstream Poo Pit, 300 PVC-U Riser and Cap
- SEWER LINE BEND
- EXISTING SEWER MAINTENANCE HOLE/POO PIT

REGISTERED SURVEYOR'S CERTIFICATION

I, Veris Australia Pty Ltd, hereby certify that the vertical and horizontal locations and dimensions shown on this plan are a true and correct record and were located by survey.

6448 23/04/2026
Qld Registered Surveyor (sig.) Qld Reg. Surveyor No. Date
/Delegate

ENGINEERS CERTIFICATION

I ....., hereby certify that the as-constructed details shown on this drawing are a true and accurate record of the construction works, in compliance with the contract documents, approved drawings and approved design.

RPEQ (signature) RPEQ No._____ Date:

0 5 10 15 20 25m
SCALE 1:250 @A1

A1

INDEX	DATE	REVISIONS	DRAWN	CHECKED	PASSED
D	22/04/2026	AS CONSTRUCTED			
C	10/04/2026	AS CONSTRUCTED	JMc		
B	12/03/2026	AS CONSTRUCTED	AD		
A	04/03/2026	PROGRESS PLOT	AD		

	INITIALS	DATE
DRAWN	AD	12/03/2026
CHECKED		
PASSED		

CONSULTING SURVEYOR
veris
BRISBANE (07) 3666 4700 WHITSUNDAYS (07) 4945 6600
MACKAY (07) 4957 9700 CAIRNS (07) 4252 9400
veris.com.au
ACN 615 735 727
Veris Australia Pty Ltd

egis

Unitywater

Unitywater

LILYWOOD LANDINGS
STAGE 8
AS CONSTRUCTED SEWER AND WATER

SHEET 4 OF 7 SHEETS		SCALE	1:250
REVISION DATE	22/04/2026	REVISION	D
DISCIPLINE CODE	C		
DRAWING NO.	UW-2025-6231-8		

Emt SM

COORDINATE DATUM NOTE:
HORIZONTAL COORDINATES(E,N) SUPPLIED ARE MAPPING GRID OF AUSTRALIA(MGA), ZONE 56 BASED ON THE UNIVERSAL TRANSVERSE MERCATOR PROJECTION AND THE GEOCENTRIC DATUM OF AUSTRALIA 2020.

PSM 72109
E: 490729.557
N: 7001736.666
RL: 30.422m

N

AS CONSTRUCTED

NOTES:
- ALL PROPERTY CONNECTIONS ARE Ø110 (OD) PE-100 SDR21 WITH A Ø100 uPVC-U SN10 ADAPTOR

LEGEND
- SEWER MAIN
- SEWER HOUSE CONNECTION
- SEWER MAINTENANCE HOLE
- 600 Smartstream Poo Pit, 300 PVC-U Riser and Cap
- SEWER LINE BEND
- EXISTING SEWER MAINTENANCE HOLE/POO PIT

REGISTERED SURVEYOR'S CERTIFICATION

I, ... Veris Australia Pty Ltd ....., hereby certify that the vertical and horizontal locations and dimensions shown on this plan are a true and correct record and were located by survey.

Qld Registered Surveyor (sig.) — Qld Reg. Surveyor No. 6448 — Date 23/04/2026

/Delegate

ENGINEERS CERTIFICATION

I ....., hereby certify that the as-constructed details shown on this drawing are a true and accurate record of the construction works, in compliance with the contract documents, approved drawings and approved design.

RPEQ (signature) RPEQ No. ------ Date:

0 5 10 15 20 25m
SCALE 1:250 @A1

A1

INDEX	DATE	REVISIONS	DRAWN	CHECKED	PASSED
D	22/04/2026	AS CONSTRUCTED			
C	10/04/2026	AS CONSTRUCTED	JMc		
B	12/03/2026	AS CONSTRUCTED	AD		
A	04/03/2026	PROGRESS PLOT	AD		

DRAWN	AD	12/03/2026
CHECKED		
PASSED		
	INITIALS	DATE

CONSULTING SURVEYOR
veris
BRISBANE (07) 3666 4700
WHITSUNDAYS (07) 4945 6600
MACKAY (07) 4957 9700
CAIRNS (07) 4252 9400
veris.com.au
ACN 615 735 727
Veris Australia Pty Ltd

egis

Unitywater

Unitywater

LILYWOOD LANDINGS
STAGE 8
AS CONSTRUCTED SEWER AND WATER

SHEET 5 OF 7 SHEETS	SCALE 1:250
REVISION DATE 22/04/2026	REVISION D
DISCIPLINE CODE C	
DRAWING NO. UW-2025-6231-8	

COORDINATE DATUM NOTE:
HORIZONTAL COORDINATES(E,N) SUPPLIED ARE MAPPING GRID OF AUSTRALIA(MGA), ZONE 56 BASED ON THE UNIVERSAL TRANSVERSE MERCATOR PROJECTION AND THE GEOCENTRIC DATUM OF AUSTRALIA 2020.

PSM 72109
E: 490729.557
N: 7001736.666
RL: 30.422m

N

AS CONSTRUCTED

LEGEND

- Conduit — *New Water Service Conduit (Ø100 uPVC PN9)*
- *New Water Meter*
- RT — *New Water House connection*
- (1) Ø100 Stop Valve
- (2) Ø100xØ100 Tee
- (3) Ø100 Temp Duckfoot Hydrant
- (4) Ø100 Fire Hydrant
- (5) Ø100 90° Bend

REGISTERED SURVEYOR'S CERTIFICATION

I, Veris Australia Pty Ltd, hereby certify that the vertical and horizontal locations and dimensions shown on this plan are a true and correct record and were located by survey.

6448 — 23/04/2026
Qld Registered Surveyor (sig.) /Delegate — Qld Reg. Surveyor No. — Date

ENGINEERS CERTIFICATION

I ..... hereby certify that the as-constructed details shown on this drawing are a true and accurate record of the construction works, in compliance with the contract documents, approved drawings and approved design.

RPEQ (signature) RPEQ No. _____ Date:

HOLSTEIN LANE
ROAD
ASHFORD CRESCENT
ASHFORD CRESCENT
LANDINGS BOULEVARD
Emt AA
Emt AB
Emt SG
Emt AK
Conduit
Live Connection 1
FH
RT

0 5 10 15 20 25m
SCALE 1:250 @A1

INDEX	DATE	REVISIONS	DRAWN	CHECKED	PASSED
D	22/04/2026	AS CONSTRUCTED			
C	10/04/2026	AS CONSTRUCTED	JMc		
B	12/03/2026	AS CONSTRUCTED	AD		
A	04/03/2026	PROGRESS PLOT	AD		

	INITIALS	DATE
DRAWN	AD	12/03/2026
CHECKED		
PASSED		

A1

CONSULTING SURVEYOR
veris
BRISBANE (07) 3666 4700 WHITSUNDAYS (07) 4945 6600
MACKAY (07) 4957 9700 CAIRNS (07) 4252 9400
veris.com.au
ACN 615 735 727
Veris Australia Pty Ltd

egis

Unitywater

Unitywater

LILYWOOD LANDINGS
STAGE 8
AS CONSTRUCTED SEWER AND WATER

SHEET 6 OF 7 SHEETS		SCALE	1:250
REVISION DATE	22/04/2026	REVISION	D
DISCIPLINE CODE	C		
DRAWING NO.	UW-2025-6231-8		

PSM 72109
E: 490729.557
N: 7001736.666
RL: 30.422m

COORDINATE DATUM NOTE:
HORIZONTAL COORDINATES(E,N) SUPPLIED ARE MAPPING GRID OF AUSTRALIA(MGA), ZONE 56 BASED ON THE UNIVERSAL TRANSVERSE MERCATOR PROJECTION AND THE GEOCENTRIC DATUM OF AUSTRALIA 2020.

LEGEND

Conduit	New Water Service Conduit (Ø100 uPVC PN9)
◎	New Water Meter
RT	New Water House connection
1	Ø100 Stop Valve
2	Ø100xØ100 Tee
3	Ø100 Temp Duckfoot Hydrant
4	Ø100 Fire Hydrant
5	Ø100 90° Bend

REGISTERED SURVEYOR'S CERTIFICATION

I, Veris Australia Pty Ltd, hereby certify that the vertical and horizontal locations and dimensions shown on this plan are a true and correct record and were located by survey.

Qld Registered Surveyor (sig.) /Delegate — Qld Reg. Surveyor No. 6448 — Date 23/04/2026

ENGINEERS CERTIFICATION

I ....., hereby certify that the as-constructed details shown on this drawing are a true and accurate record of the construction works, in compliance with the contract documents, approved drawings and approved design.

RPEQ (signature) RPEQ No. _____ Date:

0 5 10 15 20 25m
SCALE 1:250 @A1

A1

INDEX	DATE	REVISIONS	DRAWN	CHECKED	PASSED
D	22/04/2026	AS CONSTRUCTED			
C	10/04/2026	AS CONSTRUCTED	JMc		
B	12/03/2026	AS CONSTRUCTED	AD		
A	04/03/2026	PROGRESS PLOT	AD		

	INITIALS	DATE
DRAWN	AD	12/03/2026
CHECKED		
PASSED		

CONSULTING SURVEYOR
veris
BRISBANE (07) 3666 4700 WHITSUNDAYS (07) 4945 6600
MACKAY (07) 4957 9700 CAIRNS (07) 4252 9400
veris.com.au
ACN 615 735 727
Veris Australia Pty Ltd

egis

Unitywater

Unitywater

LILYWOOD LANDINGS
STAGE 8
AS CONSTRUCTED SEWER AND WATER

SHEET 7 OF 7 SHEETS		SCALE	1:250
REVISION DATE	22/04/2026	REVISION	D
DISCIPLINE CODE	C		
DRAWING NO.	UW-2025-6231-8		