COORDINATE DATUM NOTE:

HORIZONTAL COORDINATES(E,N) SUPPLIED ARE MAPPING GRID OF AUSTRALIA(MGA), ZONE 56 BASED ON THE UNIVERSAL TRANSVERSE MERCATOR PROJECTION AND THE GEOCENTRIC DATUM OF AUSTRALIA 2020.

PSM 72109
E: 490729.557
N: 7001736.666
RL: 30.422m

SHEET 2

SHEET 3

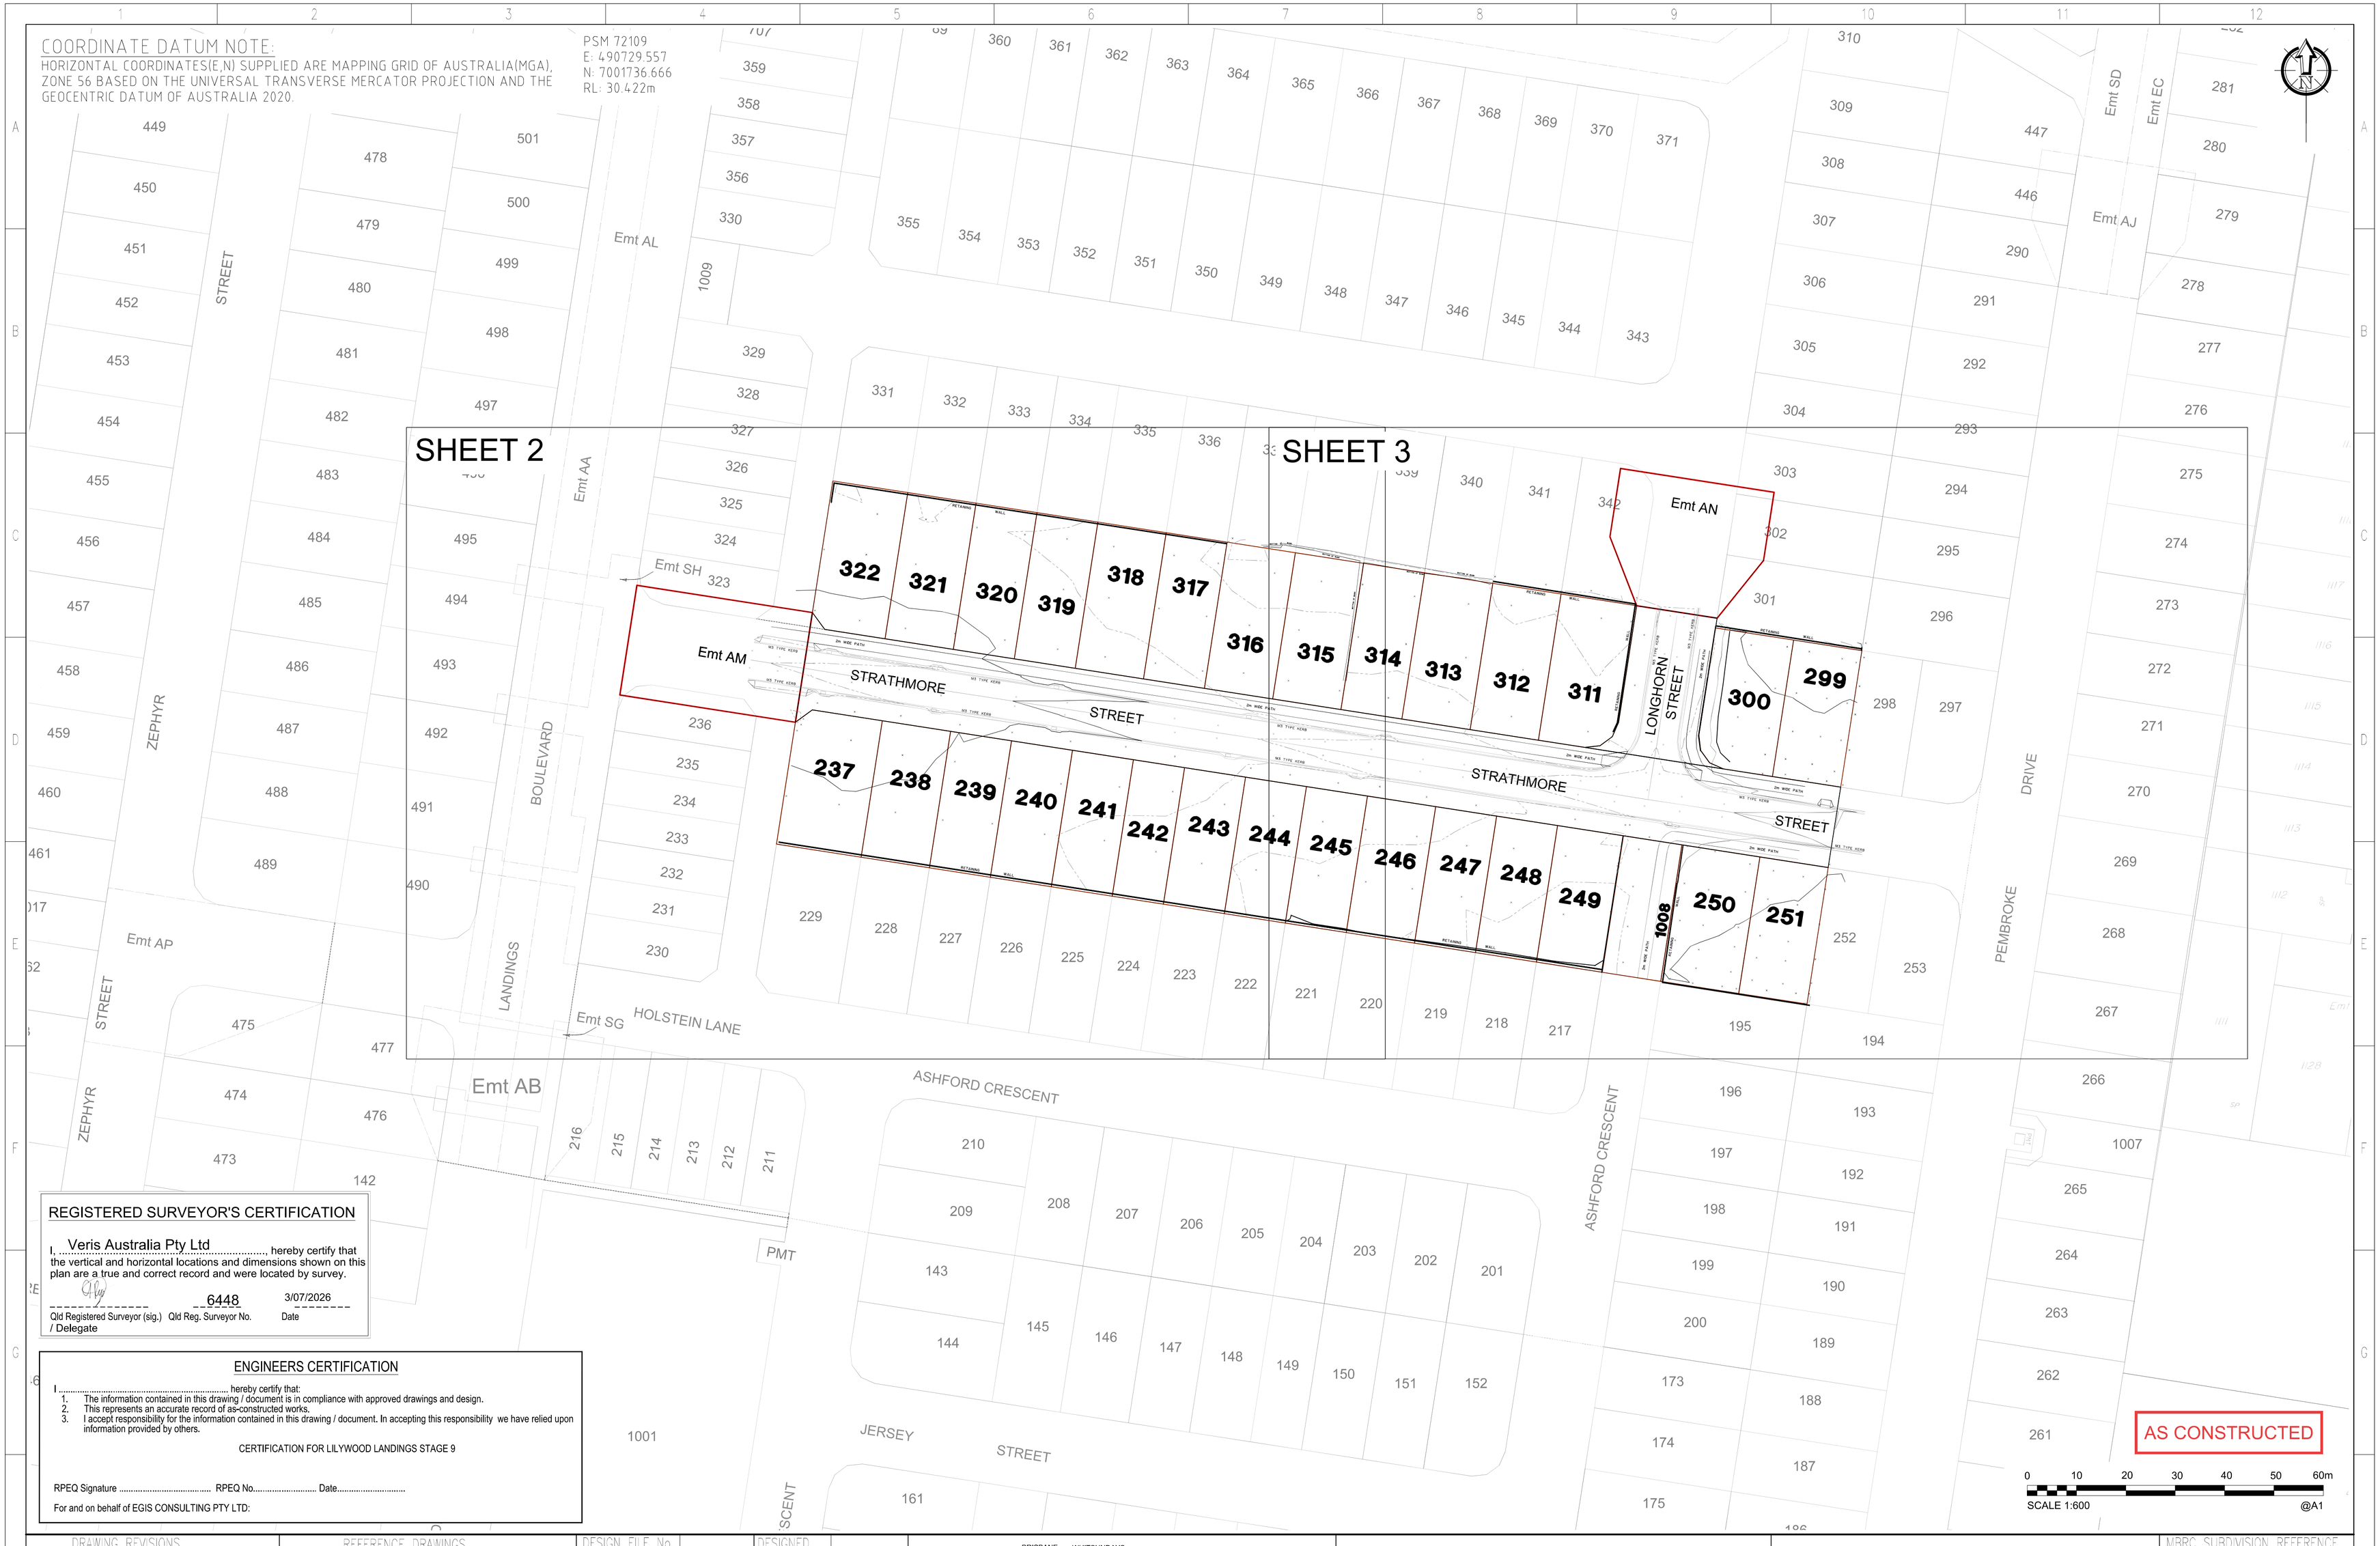

REGISTERED SURVEYOR'S CERTIFICATION

I, Veris Australia Pty Ltd, hereby certify that the vertical and horizontal locations and dimensions shown on this plan are a true and correct record and were located by survey.

Qld Registered Surveyor (sig.) / Delegate	Qld Reg. Surveyor No.	Date
	6448	3/07/2026

ENGINEERS CERTIFICATION

I ..... hereby certify that:

1. The information contained in this drawing / document is in compliance with approved drawings and design.
2. This represents an accurate record of as-constructed works.
3. I accept responsibility for the information contained in this drawing / document. In accepting this responsibility we have relied upon information provided by others.

CERTIFICATION FOR LILYWOOD LANDINGS STAGE 9

RPEQ Signature ..... RPEQ No..... Date.....

For and on behalf of EGIS CONSULTING PTY LTD:

AS CONSTRUCTED

0 10 20 30 40 50 60m
SCALE 1:600 @A1

DRAWING REVISIONS		REFERENCE DRAWINGS
REV.	REVISION DESCRIPTION	DESCRIPTION
A	ORIGINAL 12/05/2026	

DESIGN FILE No.		DESIGNED	
CONSTRUCT. No.		DATE	
SURVEY FILE No.	401871-9-AEW01-A	DRAWN	AD
FIELD BOOK		DATE	12/05/2026
LOG BOOK		CHECKED	DC
LEVEL DATUM	AHD	DATE	
DATUM			

veris
BRISBANE (07) 3466 4700 · WHITSUNDAYS (07) 4941 9300 · MACKAY (07) 4957 9700 · CAIRNS (07) 4052 9400
veris.com.au
ACN 615 735 727
Veris Australia Pty Ltd

egis

SCALE 1:600 | ORIGINAL SIZE A1

CITY OF MORETON BAY
CABOOLTURE DISTRICT OFFICE
2 HASKING STREET CABOOLTURE QLD 4510
PO BOX 159 CABOOLTURE QLD 4510
Telephone: (07) 3205 0555
Email: council@moretonbay.qld.gov.au

OW NUMBER 22-000082_9
LILYWOOD LANDINGS STAGE 9
AS CONSTRUCTED EARTHWORKS

MBRC SUBDIVISION REFERENCE	
DA 2022/2253	
No. 1 OF 3 PLANS	
DRAWING NUMBER	REV.
401871-9-AEW01-A	A

COORDINATE DATUM NOTE:

HORIZONTAL COORDINATES(E,N) SUPPLIED ARE MAPPING GRID OF AUSTRALIA(MGA), ZONE 56 BASED ON THE UNIVERSAL TRANSVERSE MERCATOR PROJECTION AND THE GEOCENTRIC DATUM OF AUSTRALIA 2020.

PSM 72109
E: 490729.557
N: 7001736.666
RL: 30.422m

LEGEND

22 — AS CONSTRUCTED CONTOURS (Interval 0.25m)
22.25 —
RETAINING WALL

REGISTERED SURVEYOR'S CERTIFICATION

I, Veris Australia Pty Ltd, hereby certify that the vertical and horizontal locations and dimensions shown on this plan are a true and correct record and were located by survey.

Qld Registered Surveyor (sig.) / Delegate	Qld Reg. Surveyor No.	Date
	6448	3/07/2026

ENGINEERS CERTIFICATION

I ..... hereby certify that:

1. The information contained in this drawing / document is in compliance with approved drawings and design.
2. This represents an accurate record of as-constructed works.
3. I accept responsibility for the information contained in this drawing / document. In accepting this responsibility we have relied upon information provided by others.

CERTIFICATION FOR LILYWOOD LANDINGS STAGE 9

RPEQ Signature ..... RPEQ No..... Date.....

For and on behalf of EGIS CONSULTING PTY LTD:

AS CONSTRUCTED

0 5 10 15 20 25m
SCALE 1:250 @A1

DRAWING REVISIONS		REFERENCE DRAWINGS
REV.	REVISION DESCRIPTION	DESCRIPTION
A	ORIGINAL 12/05/2026	

DESIGN FILE No.		DESIGNED	
CONSTRUCT. No.		DATE	
SURVEY FILE No.	401871-9-AEW01-A	DRAWN	AD
FIELD BOOK		DATE	12/05/2026
LOG BOOK		CHECKED	DC
LEVEL DATUM	AHD	DATE	
DATUM			

veris
BRISBANE (07) 3666 4700 · WHITSUNDAYS (07) 4945 4600
MACKAY (07) 4957 9700 · CAIRNS (07) 4052 9400
veris.com.au
ACN 615 735 727 Veris Australia Pty Ltd
egis

SCALE 1:250 ORIGINAL SIZE A1

CITY OF MORETON BAY
CABOOLTURE DISTRICT OFFICE
2 HASKING STREET CABOOLTURE QLD 4510
PO BOX 159 CABOOLTURE QLD 4510
Telephone: (07) 3205 0555
Email: council@moretonbay.qld.gov.au

OW NUMBER 22-000082_9
LILYWOOD LANDINGS STAGE 9
AS CONSTRUCTED EARTHWORKS

MBRC SUBDIVISION REFERENCE	
DA 2022/2253	
No. 2 OF 3 PLANS	
DRAWING NUMBER	REV.
401871-9-AEW01-A	A

COORDINATE DATUM NOTE:

HORIZONTAL COORDINATES(E,N) SUPPLIED ARE MAPPING GRID OF AUSTRALIA(MGA), ZONE 56 BASED ON THE UNIVERSAL TRANSVERSE MERCATOR PROJECTION AND THE GEOCENTRIC DATUM OF AUSTRALIA 2020.

PSM 72109
E: 490729.557
N: 7001736.666
RL: 30.422m

339 340 341 342 303 294 275

Emt AN

302 295 274

301 296 273

315 314 313 312 311 300 299 298 297 272

LONGHORN STREET

271

STRATHMORE STREET

DRIVE

4 245 246 247 248 249 250 251 252 253 267

1008

221 220 219 218 217 195 194

RETAINING WALL
M3 TYPE KERB
2m WIDE PATH
BOTTOM OF BANK

LEGEND

22 — AS CONSTRUCTED CONTOURS (Interval 0.25m)

22.25

RETAINING WALL

REGISTERED SURVEYOR'S CERTIFICATION

I, Veris Australia Pty Ltd, hereby certify that the vertical and horizontal locations and dimensions shown on this plan are a true and correct record and were located by survey.

Qld Registered Surveyor (sig.) / Delegate	Qld Reg. Surveyor No.	Date
	6448	3/07/2026

ENGINEERS CERTIFICATION

I ..... hereby certify that:

1. The information contained in this drawing / document is in compliance with approved drawings and design.
2. This represents an accurate record of as-constructed works.
3. I accept responsibility for the information contained in this drawing / document. In accepting this responsibility we have relied upon information provided by others.

CERTIFICATION FOR LILYWOOD LANDINGS STAGE 9

RPEQ Signature ..... RPEQ No..... Date.....

For and on behalf of EGIS CONSULTING PTY LTD:

AS CONSTRUCTED

0 5 10 15 20 25m

SCALE 1:250 @A1

DRAWING REVISIONS		REFERENCE DRAWINGS
REV.	REVISION DESCRIPTION	DESCRIPTION
A	ORIGINAL 12/05/2026	

DESIGN FILE No.		DESIGNED	
CONSTRUCT. No.		DATE	
SURVEY FILE No.	401871-9-AEW01-A	DRAWN	AD
FIELD BOOK		DATE	12/05/2026
LOG BOOK		CHECKED	DC
LEVEL DATUM	AHD	DATE	
DATUM			

veris — BRISBANE (07) 3666 4700 · WHITSUNDAYS (07) 4945 9500 · MACKAY (07) 4957 9700 · CAIRNS (07) 4052 9400 · veris.com.au · ACN 615 735 727 · Veris Australia Pty Ltd

egis

CITY OF MORETON BAY
CABOOLTURE DISTRICT OFFICE
2 HASKING STREET CABOOLTURE QLD 4510
PO BOX 159 CABOOLTURE QLD 4510
Telephone: (07) 3205 0555
Email: council@moretonbay.qld.gov.au

SCALE 1:250 ORIGINAL SIZE A1

OW NUMBER 22-000082_9
LILYWOOD LANDINGS STAGE 9
AS CONSTRUCTED EARTHWORKS

MBRC SUBDIVISION REFERENCE	
DA 2022/2253	
No. 3 OF 3 PLANS	
DRAWING NUMBER	REV.
401871-9-AEW01-A	A