COORDINATE DATUM NOTE:

HORIZONTAL COORDINATES(E,N) SUPPLIED ARE MAPPING GRID OF AUSTRALIA(MGA), ZONE 56 BASED ON THE UNIVERSAL TRANSVERSE MERCATOR PROJECTION AND THE GEOCENTRIC DATUM OF AUSTRALIA 2020.

PSM 72109
E: 490729.557
N: 7001736.666
RL: 30.422m

SHEET 2

SHEET 3

STRATHMORE STREET

LONGHORN STREET

Emt AM

Emt AN

Emt SH

Emt AL

Emt AA

Emt AP

Emt SG

Emt AB

Emt AJ

Emt SD

Emt EC

ZEPHYR STREET

BOULEVARD

LANDINGS

HOLSTEIN LANE

ASHFORD CRESCENT

JERSEY STREET

PEMBROKE DRIVE

PMT

1008

1009

1001

1007

AS CONSTRUCTED

0 10 20 30 40 50 60m
SCALE 1:600 @A1

REGISTERED SURVEYOR'S CERTIFICATION

I, Veris Australia Pty Ltd, hereby certify that the vertical and horizontal locations and dimensions shown on this plan are a true and correct record and were located by survey.

Qld Registered Surveyor (sig.) / Delegate	Qld Reg. Surveyor No.	Date
	6448	3/07/2026

ENGINEERS CERTIFICATION

I ..... hereby certify that:

1. The information contained in this drawing / document is in compliance with approved drawings and design.
2. This represents an accurate record of as-constructed works.
3. I accept responsibility for the information contained in this drawing / document. In accepting this responsibility we have relied upon information provided by others.

CERTIFICATION FOR LILYWOOD LANDINGS STAGE 9

RPEQ Signature ..... RPEQ No..... Date.....

For and on behalf of EGIS CONSULTING PTY LTD:

DRAWING REVISIONS			REFERENCE DRAWINGS
REV.	REVISION DESCRIPTION		DESCRIPTION
A	ORIGINAL	11/05/2026	
B	PROGRESS	08/06/2026	

DESIGN FILE No.		DESIGNED	
CONSTRUCT. No.		DATE	
SURVEY FILE No.	401871-9-ASW01-B	DRAWN	AD
FIELD BOOK		DATE	11/05/2026
LOG BOOK		CHECKED	
LEVEL DATUM	AHD	DATE	
DATUM			

veris
BRISBANE (07) 3666 4700
WHITSUNDAYS (07) 4945 6600
MACKAY (07) 4957 9700
CAIRNS (07) 4052 9400
veris.com.au
ACN 615 735 727
Veris Australia Pty Ltd

egis

SCALE 1:600 ORIGINAL SIZE A1

CITY OF MORETON BAY
CABOOLTURE DISTRICT OFFICE
2 HASKING STREET CABOOLTURE QLD 4510
PO BOX 159 CABOOLTURE QLD 4510
Telephone: (07) 3205 0555
Email: council@moretonbay.qld.gov.au

OW NUMBER 22-000082_9
LILYWOOD LANDINGS STAGE 9
AS CONSTRUCTED STORMWATER

MBRC SUBDIVISION REFERENCE	
DA 2022/2253	
No. 1 OF 3 PLANS	
DRAWING NUMBER	REV.
401871-9-ASW01-B	B

COORDINATE DATUM NOTE:
HORIZONTAL COORDINATES(E,N) SUPPLIED ARE MAPPING GRID OF AUSTRALIA(MGA), ZONE 56 BASED ON THE UNIVERSAL TRANSVERSE MERCATOR PROJECTION AND THE GEOCENTRIC DATUM OF AUSTRALIA 2020.

PSM 72109
E: 490729.557
N: 7001736.666
RL: 30.422m

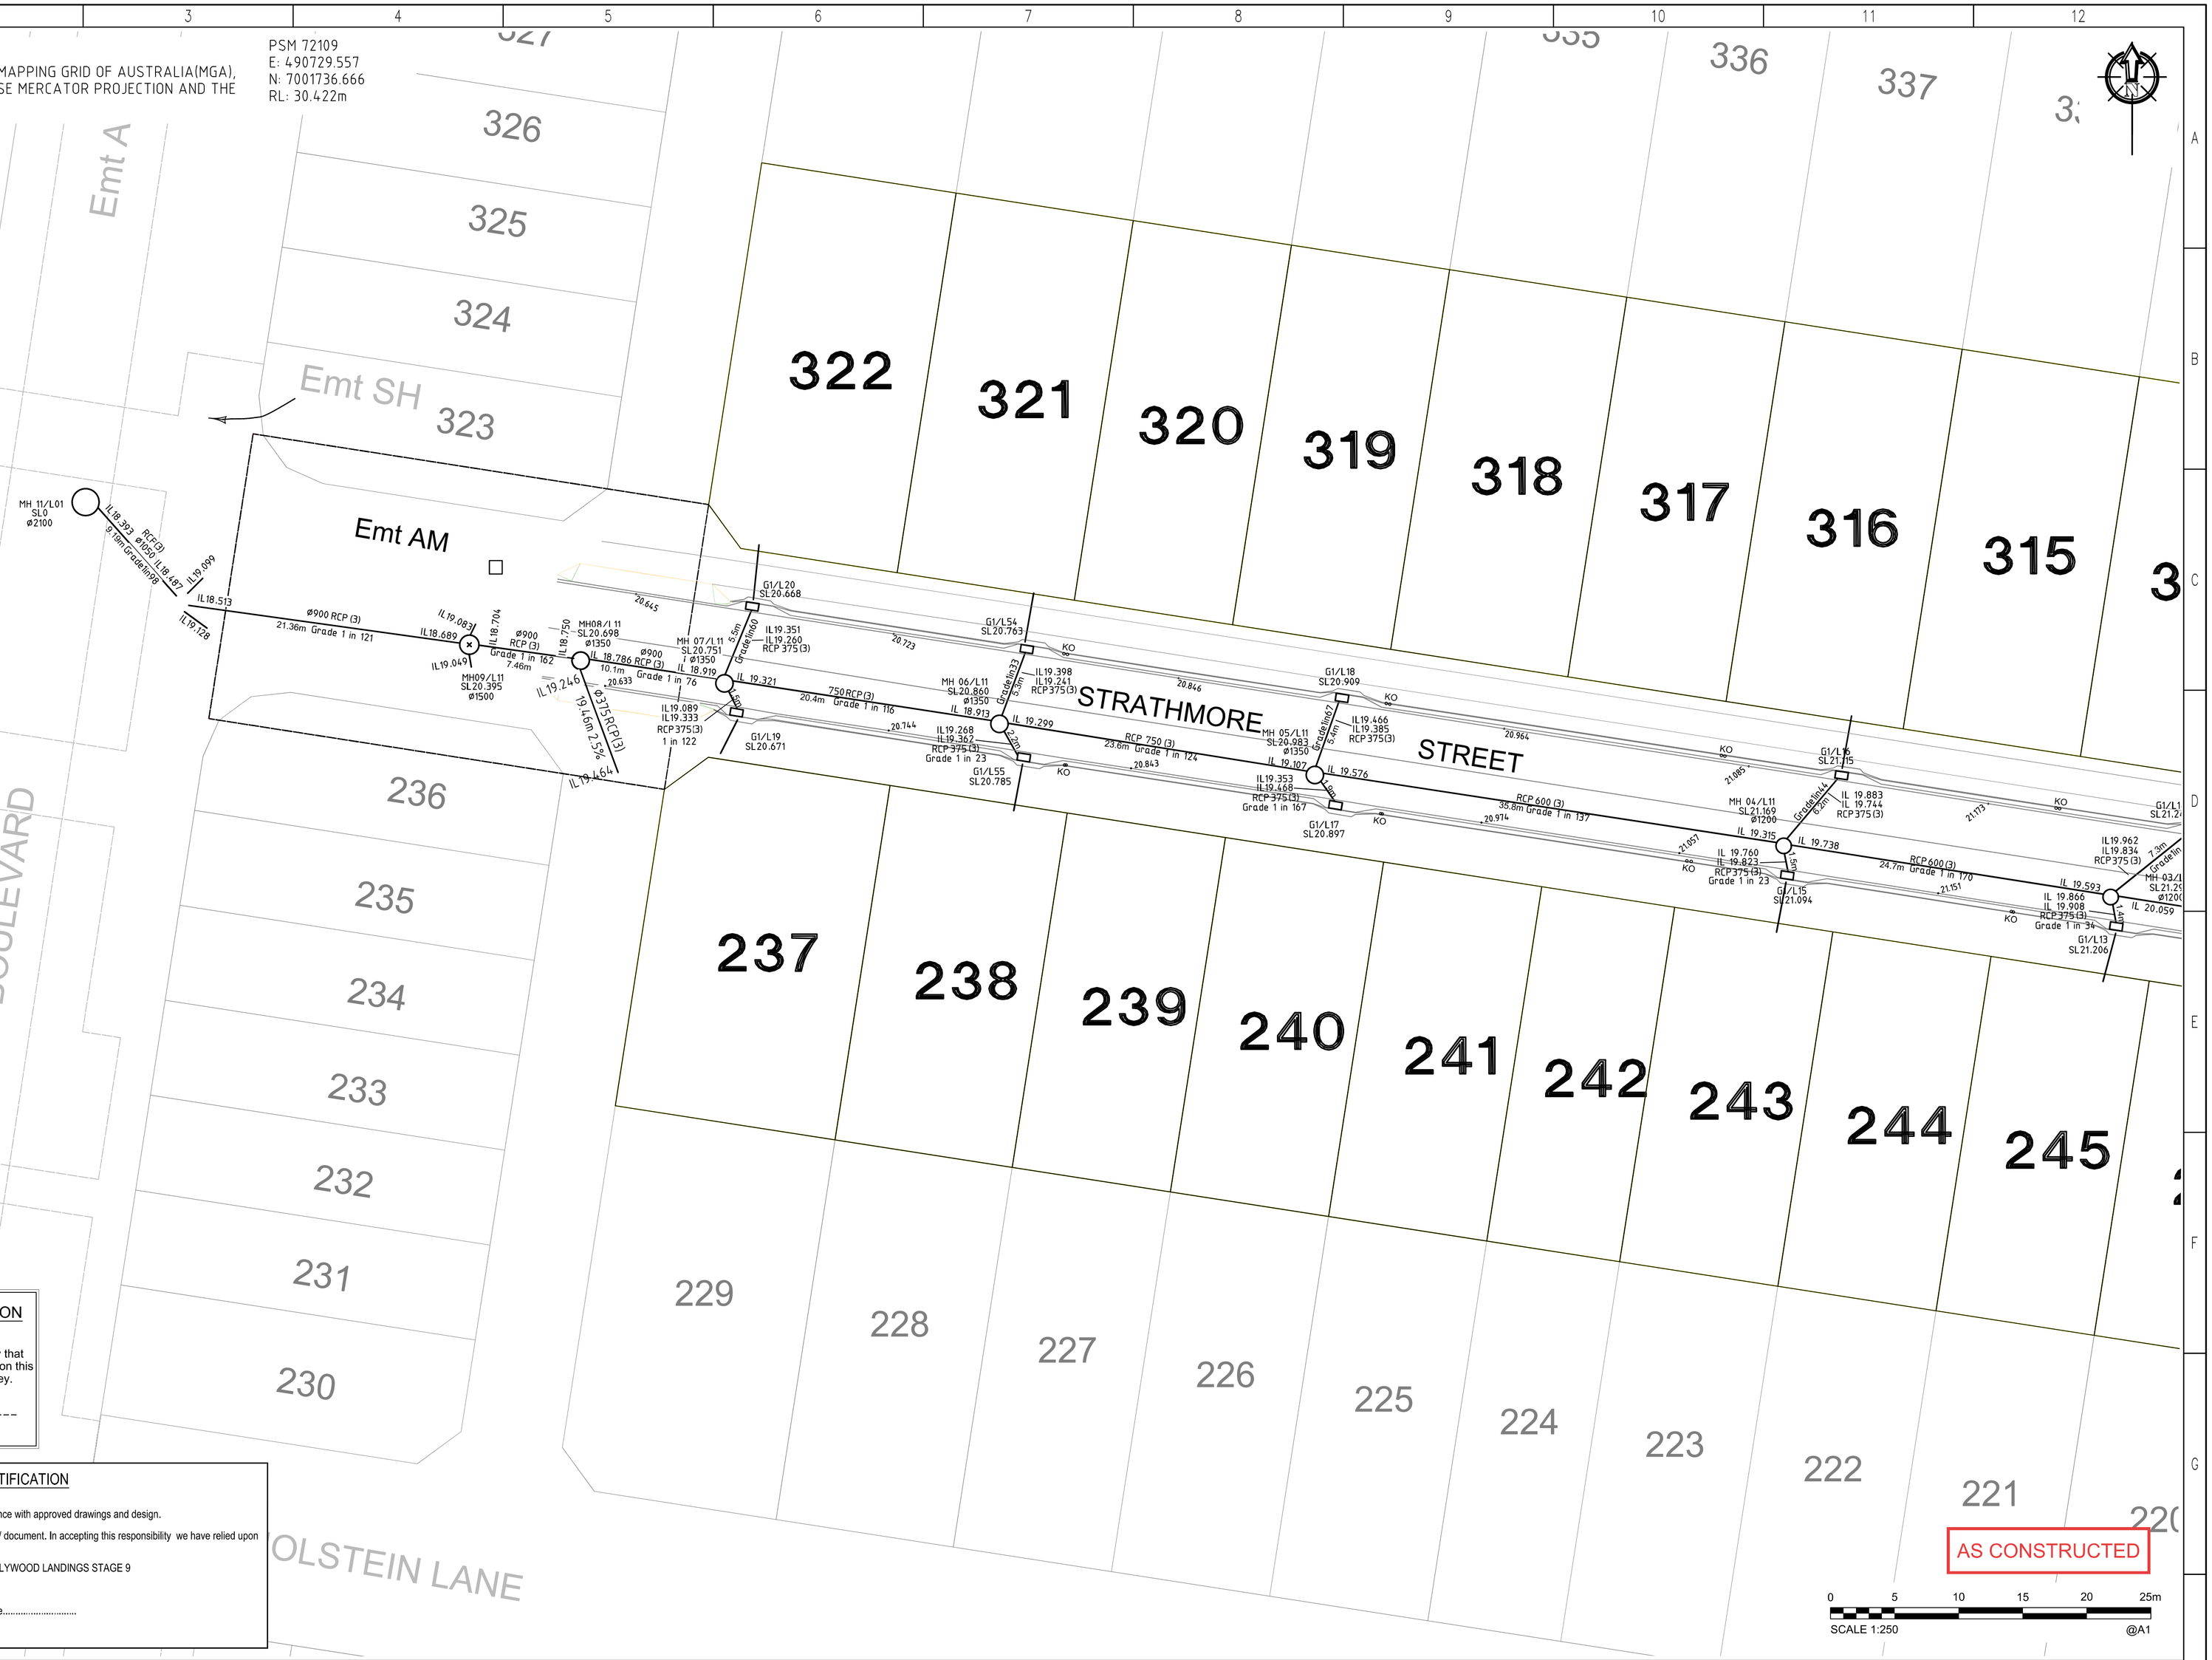

REGISTERED SURVEYOR'S CERTIFICATION

I, Veris Australia Pty Ltd, hereby certify that the vertical and horizontal locations and dimensions shown on this plan are a true and correct record and were located by survey.

Qld Registered Surveyor (sig.) / Delegate	Qld Reg. Surveyor No.	Date
	6448	3/07/2026

ENGINEERS CERTIFICATION

I ..... hereby certify that:

1. The information contained in this drawing / document is in compliance with approved drawings and design.
2. This represents an accurate record of as-constructed works.
3. I accept responsibility for the information contained in this drawing / document. In accepting this responsibility we have relied upon information provided by others.

CERTIFICATION FOR LILYWOOD LANDINGS STAGE 9

RPEQ Signature ..... RPEQ No..... Date.....

For and on behalf of EGIS CONSULTING PTY LTD:

DRAWING REVISIONS			REFERENCE DRAWINGS
REV.	REVISION DESCRIPTION		DESCRIPTION
A	ORIGINAL	11/05/2026	
B	PROGRESS	08/06/2026	

DESIGN FILE No.		DESIGNED	
CONSTRUCT. No.		DATE	
SURVEY FILE No.	401871-9-ASW01-B	DRAWN	AD
FIELD BOOK		DATE	11/05/2026
LOG BOOK		CHECKED	
LEVEL DATUM	AHD	DATE	
DATUM			

veris — BRISBANE (07) 3666 4700 · WHITSUNDAYS (07) 4945 6600 · MACKAY (07) 4957 9700 · CAIRNS (07) 4032 9400 · veris.com.au · ACN 615 735 727 · Veris Australia Pty Ltd

egis

SCALE 1:250 | ORIGINAL SIZE A1

CITY OF MORETON BAY
CABOOLTURE DISTRICT OFFICE
2 HASKING STREET CABOOLTURE QLD 4510
PO BOX 159 CABOOLTURE QLD 4510
Telephone: (07) 3205 0555
Email: council@moretonbay.qld.gov.au

OW NUMBER 22-000082_9
LILYWOOD LANDINGS STAGE 9
AS CONSTRUCTED STORMWATER

MBRC SUBDIVISION REFERENCE	
DA 2022/2253	
No. 2 OF 3 PLANS	
DRAWING NUMBER	REV.
401871-9-ASW01-B	B

COORDINATE DATUM NOTE:
HORIZONTAL COORDINATES(E,N) SUPPLIED ARE MAPPING GRID OF AUSTRALIA(MGA), ZONE 56 BASED ON THE UNIVERSAL TRANSVERSE MERCATOR PROJECTION AND THE GEOCENTRIC DATUM OF AUSTRALIA 2020.

PSM 72109
E: 490729.557
N: 7001736.666
RL: 30.422m

339 340 341 342 Emt AN 303 294 302 295 301 296 275 274 273 272 271 270 269 268 267

315 314 313 312 311 LONGHORN STREET 300 299 298 297

STRATHMORE STREET

PEMBROKE DRIVE

4 245 246 247 248 249 1008 250 251 252 253 217 195 194

21.173 KO G1/L14 SL21.243 IL19.962 IL19.834 RCP375(3) 7.3m Grade1in57 MH-03/L11 SL21.294 Ø1200 IL 20.059 RCP600(3) Grade 1 in 170 21.151 IL 19.593 IL 19.866 IL 19.908 RCP375(3) 1.5m Grade 1 in 34 G1/L13 SL21.206 21.339 21.392 600 RCP (3) 63.5m Grade 1 in 196 21.458 IL 19.736 MH 02/L11 SL21:620 Ø1050 IL 20.072 RCP375(3) 1.5m Grade 1 in 64 G1/L12 SL21.539 IL 20.158 IL 20.236 RCP375(3) Grade 1 in 20 G1/L11 SL21:594 21.650 21.779 21.633 21.816

AS CONSTRUCTED

0 5 10 15 20 25m
SCALE 1:250 @A1

REGISTERED SURVEYOR'S CERTIFICATION

I, Veris Australia Pty Ltd, hereby certify that the vertical and horizontal locations and dimensions shown on this plan are a true and correct record and were located by survey.

Qld Registered Surveyor (sig.) / Delegate	Qld Reg. Surveyor No.	Date
	6448	3/07/2026

ENGINEERS CERTIFICATION

I ..... hereby certify that:
1. The information contained in this drawing / document is in compliance with approved drawings and design.
2. This represents an accurate record of as-constructed works.
3. I accept responsibility for the information contained in this drawing / document. In accepting this responsibility we have relied upon information provided by others.

CERTIFICATION FOR LILYWOOD LANDINGS STAGE 9

RPEQ Signature ..... RPEQ No..... Date.....

For and on behalf of EGIS CONSULTING PTY LTD:

DRAWING REVISIONS			REFERENCE DRAWINGS
REV.	REVISION DESCRIPTION		DESCRIPTION
A	ORIGINAL	11/05/2026	
B	PROGRESS	08/06/2026	

DESIGN FILE No.		DESIGNED	
CONSTRUCT. No.		DATE	
SURVEY FILE No.	401871-9-ASW01-B	DRAWN	AD
FIELD BOOK		DATE	11/05/2026
LOG BOOK		CHECKED	
LEVEL DATUM	AHD	DATE	
DATUM			

veris — BRISBANE (07) 3666 4700 · WHITSUNDAYS (07) 4945 6600 · MACKAY (07) 4957 9700 · CAIRNS (07) 4032 9400 · veris.com.au · ACN 615 735 727 · Veris Australia Pty Ltd

egis

SCALE 1:250 ORIGINAL SIZE A1

CITY OF MORETON BAY
CABOOLTURE DISTRICT OFFICE
2 HASKING STREET CABOOLTURE QLD 4510
PO BOX 159 CABOOLTURE QLD 4510
Telephone: (07) 3205 0555
Email: council@moretonbay.qld.gov.au

OW NUMBER 22-000082_9
LILYWOOD LANDINGS STAGE 9
AS CONSTRUCTED STORMWATER

MBRC SUBDIVISION REFERENCE	
DA 2022/2253	
No. 3 OF 3 PLANS	
DRAWING NUMBER	REV.
401871-9-ASW01-B	B