COORDINATE DATUM NOTE:

HORIZONTAL COORDINATES(E,N) SUPPLIED ARE MAPPING GRID OF AUSTRALIA(MGA), ZONE 56 BASED ON THE UNIVERSAL TRANSVERSE MERCATOR PROJECTION AND THE GEOCENTRIC DATUM OF AUSTRALIA 2020.

PSM 72109
E: 490729.557
N: 7001736.666
RL: 30.422m

SHEET 2 SEWER
SHEET 4 WATER

SHEET 3 SEWER
SHEET 5 WATER

AS CONSTRUCTED

NOTES:
- ALL PROPERTY CONNECTIONS ARE ø110 (OD) PE-100 SDR21 WITH A ø100 uPVC-U SN10 ADAPTOR

LEGEND

- SEWER MAIN
- SEWER HOUSE CONNECTION
- SEWER MAINTENANCE HOLE
- 600 Smartstream Poo Pit, 300 PVC-U Riser and Cap
- SEWER LINE BEND
- EXISTING SEWER MAINTENANCE HOLE/POO PIT

LEGEND

- *New Water Service Conduit (Ø100 uPVC PN9)*
- *New Water Meter*
- RT *New Water House connection*
- 1 Ø100 Stop Valve
- 2 Ø100xØ100 Tee
- 3 Ø100 Temp Duckfoot Hydrant
- 4 Ø100 Fire Hydrant
- 5 Ø100 11.25° Bend
- 6 Ø100 22.5° Bend
- 7 Ø100 45° Bend

REGISTERED SURVEYOR'S CERTIFICATION

I, Veris Australia Pty Ltd, hereby certify that the vertical and horizontal locations and dimensions shown on this plan are a true and correct record and were located by survey.

6448 3/07/2026

Qld Registered Surveyor (sig.) / Delegate | Qld Reg. Surveyor No. | Date

ENGINEERS CERTIFICATION

I, ..., hereby certify that the as-constructed details shown on this drawing are a true and accurate record of the construction works, in compliance with the contract documents, approved drawings and approved design.

RPEQ (signature) RPEQ No. _____ Date:

0 10 20 30 40 50 60m
SCALE 1:600 @A1

A1									
C	03/06/2026	AS CONSTRUCTED				DRAWN	JMc	22/10/2025
B	08/05/2026	AS CONSTRUCTED				CHECKED		
A	10/04/2026	AS CONSTRUCTED	JMc			PASSED		
INDEX	DATE	REVISIONS	DRAWN	CHECKED	PASSED		INITIALS	DATE

CONSULTING SURVEYOR
veris
BRISBANE (07) 3666 4700 WHITSUNDAYS (07) 4945 6600
MACKAY (07) 4957 9700 CAIRNS (07) 4252 9400
veris.com.au
ACN 615 735 727
Veris Australia Pty Ltd

egis

Unitywater

Unitywater

Lillywood Landings
Stage 9
As Constructed Sewer and Water

SHEET 1 OF 5 SHEETS		SCALE	1:600
REVISION DATE	03/06/2026	REVISION	C
DISCIPLINE CODE	C		
DRAWING NO.	U-2025-6231-C		

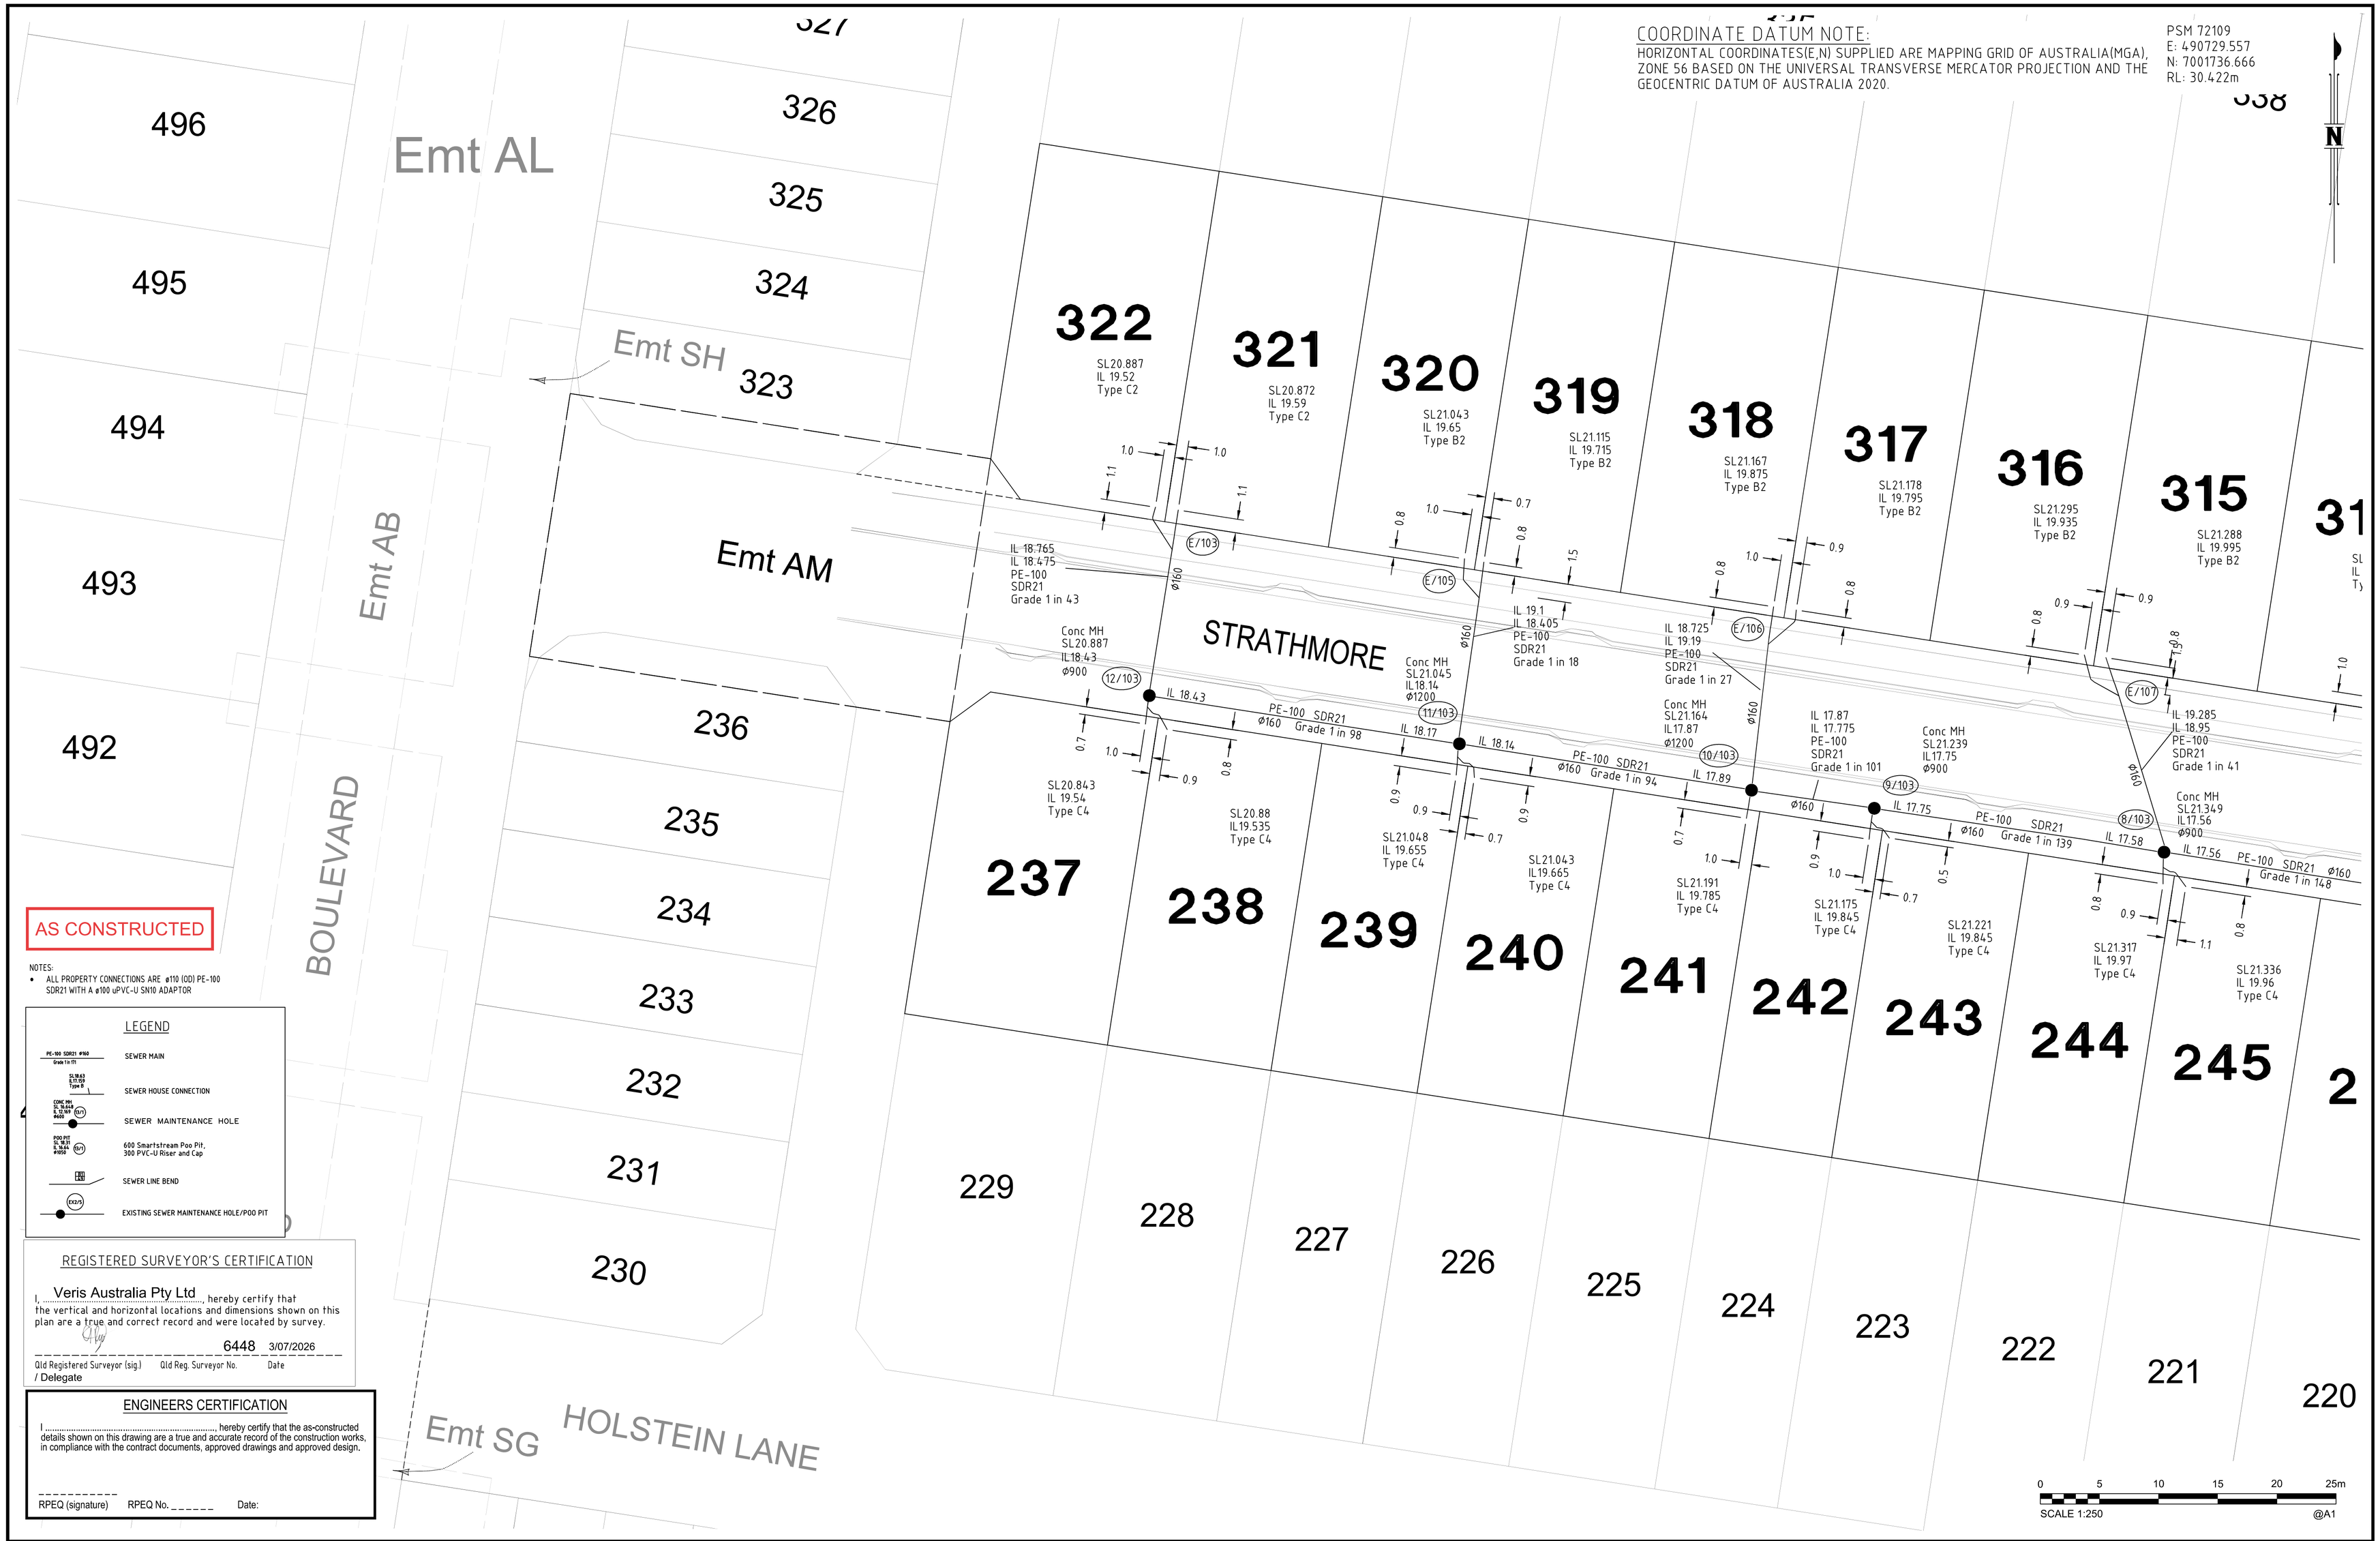

AS CONSTRUCTED

NOTES:
- ALL PROPERTY CONNECTIONS ARE ø110 (OD) PE-100 SDR21 WITH A ø100 uPVC-U SN10 ADAPTOR

LEGEND

PE-100 SDR21 ø160 Grade 1 in 171	SEWER MAIN
SL18.63 IL17.159 Type B	SEWER HOUSE CONNECTION
CONC MH SL 18.648 IL 12.169 ø600 (3/1)	SEWER MAINTENANCE HOLE
POO PIT SL 18.91 IL 16.64 ø1050 (3/1)	600 Smartstream Poo Pit, 300 PVC-U Riser and Cap
	SEWER LINE BEND
(EX2/1)	EXISTING SEWER MAINTENANCE HOLE/POO PIT

REGISTERED SURVEYOR'S CERTIFICATION

I, Veris Australia Pty Ltd, hereby certify that the vertical and horizontal locations and dimensions shown on this plan are a true and correct record and were located by survey.

6448 3/07/2026

Qld Registered Surveyor (sig.) / Delegate — Qld Reg. Surveyor No. — Date

ENGINEERS CERTIFICATION

I ....., hereby certify that the as-constructed details shown on this drawing are a true and accurate record of the construction works, in compliance with the contract documents, approved drawings and approved design.

RPEQ (signature) RPEQ No. _____ Date:

A1

INDEX	DATE	REVISIONS	DRAWN	CHECKED	PASSED
C	03/06/2026	AS CONSTRUCTED			
B	08/05/2026	AS CONSTRUCTED			
A	10/04/2026	AS CONSTRUCTED	JMc		

	INITIALS	DATE
DRAWN	JMc	10/04/2026
CHECKED		
PASSED		

CONSULTING SURVEYOR
veris
BRISBANE (07) 3656 4700 WHITSUNDAYS (07) 4945 6600
MACKAY (07) 4957 9700 CAIRNS (07) 4252 9400
veris.com.au
ACN 615 735 727
Veris Australia Pty Ltd

egis

Unitywater

Unitywater

LILYWOOD LANDINGS
STAGE 9
AS CONSTRUCTED SEWER AND WATER

SHEET 2 OF 5 SHEETS		SCALE	1:250
REVISION DATE	03/06/2026	REVISION	C
DISCIPLINE CODE	C		
DRAWING NO.	U-2025-6231-C		

COORDINATE DATUM NOTE:
HORIZONTAL COORDINATES(E,N) SUPPLIED ARE MAPPING GRID OF AUSTRALIA(MGA), ZONE 56 BASED ON THE UNIVERSAL TRANSVERSE MERCATOR PROJECTION AND THE GEOCENTRIC DATUM OF AUSTRALIA 2020.

PSM 72109
E: 490729.557
N: 7001736.666
RL: 30.422m

N

AS CONSTRUCTED

NOTES:
- ALL PROPERTY CONNECTIONS ARE ø110 (OD) PE-100 SDR21 WITH A ø100 uPVC-U SN10 ADAPTOR

LEGEND
- SEWER MAIN
- SEWER HOUSE CONNECTION
- SEWER MAINTENANCE HOLE
- 600 Smartstream Poo Pit, 300 PVC-U Riser and Cap
- SEWER LINE BEND
- EXISTING SEWER MAINTENANCE HOLE/POO PIT

REGISTERED SURVEYOR'S CERTIFICATION

I, Veris Australia Pty Ltd, hereby certify that the vertical and horizontal locations and dimensions shown on this plan are a true and correct record and were located by survey.

Qld Registered Surveyor (sig.) / Delegate — Qld Reg. Surveyor No. 6448 — Date 3/07/2026

ENGINEERS CERTIFICATION

I .... hereby certify that the as-constructed details shown on this drawing are a true and accurate record of the construction works, in compliance with the contract documents, approved drawings and approved design.

RPEQ (signature) — RPEQ No. ______ — Date:

0 5 10 15 20 25m
SCALE 1:250
@A1

A1

INDEX	DATE	REVISIONS	DRAWN	CHECKED	PASSED
C	03/06/2026	AS CONSTRUCTED			
B	08/05/2026	AS CONSTRUCTED			
A	10/04/2026	AS CONSTRUCTED	JMc		

	INITIALS	DATE
DRAWN	JMc	10/04/2026
CHECKED		
PASSED		

CONSULTING SURVEYOR
veris
BRISBANE (07) 3666 4700 — WHITSUNDAYS (07) 4945 6600
MACKAY (07) 4957 9700 — CAIRNS (07) 4252 9600
veris.com.au
ACN 615 735 727
Veris Australia Pty Ltd

egis

Unitywater

Unitywater

LILYWOOD LANDINGS
STAGE 9
AS CONSTRUCTED SEWER AND WATER

SHEET 3 OF 5 SHEETS		SCALE	1:250
REVISION DATE	03/06/2026	REVISION	C
DISCIPLINE CODE	C		
DRAWING NO.	U-2025-6231-C		

AS CONSTRUCTED

LEGEND

Conduit — *New Water Service Conduit (Ø100 uPVC PN9)*

New Water Meter

RT — *New Water House connection*

1. Ø100 Stop Valve
2. Ø100xØ100 Tee
3. Ø100 Temp Duckfoot Hydrant
4. Ø100 Fire Hydrant
5. Ø100 11.25° Bend
6. Ø100 45° Bend
7. Ø100 90° Bend

REGISTERED SURVEYOR'S CERTIFICATION

I, Veris Australia Pty Ltd, hereby certify that the vertical and horizontal locations and dimensions shown on this plan are a true and correct record and were located by survey.

6448 3/07/2026

Qld Registered Surveyor (sig.) / Delegate — Qld Reg. Surveyor No. — Date

ENGINEERS CERTIFICATION

I ....., hereby certify that the as-constructed details shown on this drawing are a true and accurate record of the construction works, in compliance with the contract documents, approved drawings and approved design.

RPEQ (signature) RPEQ No. _____ Date:

A1

INDEX	DATE	REVISIONS	DRAWN	CHECKED	PASSED
C	03/06/2026	AS CONSTRUCTED			
B	08/05/2026	AS CONSTRUCTED			
A	10/04/2026	AS CONSTRUCTED	JMc		

	INITIALS	DATE
DRAWN	JMc	10/04/2026
CHECKED		
PASSED		

CONSULTING SURVEYOR
veris
BRISBANE (07) 3666 4700 — WHITSUNDAYS (07) 4945 6600
MACKAY (07) 4957 9700 — CAIRNS (07) 4252 9400
veris.com.au
ACN 615 735 727
Veris Australia Pty Ltd

egis

Unitywater

Unitywater

LILYWOOD LANDINGS
STAGE 9
AS CONSTRUCTED SEWER AND WATER

SHEET 4 OF 5 SHEETS		SCALE	1:250
REVISION DATE	03/06/2026	REVISION	C
DISCIPLINE CODE	C		
DRAWING NO.	U-2025-6231-C		

COORDINATE DATUM NOTE:
HORIZONTAL COORDINATES(E,N) SUPPLIED ARE MAPPING GRID OF AUSTRALIA(MGA), ZONE 56 BASED ON THE UNIVERSAL TRANSVERSE MERCATOR PROJECTION AND THE GEOCENTRIC DATUM OF AUSTRALIA 2020.

PSM 72109
E: 490729.557
N: 7001736.666
RL: 30.422m

AS CONSTRUCTED

LEGEND

- Conduit — New Water Service Conduit (Ø100 uPVC PN9)
- New Water Meter
- RT — New Water House connection
- (1) Ø100 Stop Valve
- (2) Ø100xØ100 Tee
- (3) Ø100 Temp Duckfoot Hydrant
- (4) Ø100 Fire Hydrant
- (5) Ø100 11.25° Bend
- (6) Ø100 45° Bend
- (7) Ø100 90° Bend

REGISTERED SURVEYOR'S CERTIFICATION

I, Veris Australia Pty Ltd, hereby certify that the vertical and horizontal locations and dimensions shown on this plan are a true and correct record and were located by survey.

6448 — 3/07/2026

Qld Registered Surveyor (sig.) / Delegate — Qld Reg. Surveyor No. — Date

ENGINEERS CERTIFICATION

I ....., hereby certify that the as-constructed details shown on this drawing are a true and accurate record of the construction works, in compliance with the contract documents, approved drawings and approved design.

RPEQ (signature) RPEQ No. _____ Date:

0 5 10 15 20 25m
SCALE 1:250 @A1

A1

INDEX	DATE	REVISIONS	DRAWN	CHECKED	PASSED
C	03/06/2026	AS CONSTRUCTED			
B	08/05/2026	AS CONSTRUCTED			
A	10/04/2026	AS CONSTRUCTED	JMc		

	INITIALS	DATE
DRAWN	JMc	10/04/2026
CHECKED		
PASSED		

CONSULTING SURVEYOR
veris
BRISBANE (07) 3666 4700 · WHITSUNDAYS (07) 4945 6600
MACKAY (07) 4957 9700 · CAIRNS (07) 4252 9400
veris.com.au
ACN 615 735 727
Veris Australia Pty Ltd

egis

Unitywater

Unitywater

LILYWOOD LANDINGS
STAGE 9
AS CONSTRUCTED SEWER AND WATER

SHEET 5 OF 5 SHEETS	SCALE 1:250
REVISION DATE 03/06/2026	REVISION C
DISCIPLINE CODE C	
DRAWING NO. U-2025-6231-C	