SHEET 5

SHEET 6

SHEET 4

SHEET 3

SHEET 2

AS CONSTRUCTED

REGISTERED SURVEYOR'S CERTIFICATION

I, Veris Australia Pty Ltd, hereby certify that the vertical and horizontal locations and dimensions shown on this plan are a true and correct record and were located by survey.

_____ 6448 _____

Qld Registered Surveyor (sig.) Qld Reg. Surveyor No. Date

ENGINEERS CERTIFICATION

I ..... hereby certify that:

1. The information contained in this drawing / document is in compliance with approved drawings and design.
2. This represents an accurate record of as-constructed works.
3. I accept responsibility for the information contained in this drawing / document. In accepting this responsibility we have relied upon information provided by others.

CERTIFICATION FOR LILYWOOD LANDINGS STAGE 10

RPEQ Signature ..... RPEQ No..... Date.....

For and on behalf of EGIS CONSULTING PTY LTD:

COORDINATE DATUM NOTE:

HORIZONTAL COORDINATES(E,N) SUPPLIED ARE MAPPING GRID OF AUSTRALIA(MGA), ZONE 56 BASED ON THE UNIVERSAL TRANSVERSE MERCATOR PROJECTION AND THE GEOCENTRIC DATUM OF AUSTRALIA 2020.

PSM 72109
E: 490729.557
N: 7001736.666
RL: 30.422m

DRAWING REVISIONS		
REV.	REVISION DESCRIPTION	
A	ORIGINAL	08/06/2026
B	PROGRESS	27/07/2026

REFERENCE DRAWINGS
DESCRIPTION

DESIGN FILE No.		DESIGNED	
CONSTRUCT. No.		DATE	
SURVEY FILE No.	401871-10-ASW01-B	DRAWN	JMc
FIELD BOOK		DATE	08/06/2026
LOG BOOK		CHECKED	
LEVEL DATUM	AHD	DATE	
DATUM			

veris — BRISBANE (07) 3696 4700 · WHITSUNDAYS (07) 4945 6600 · MACKAY (07) 4957 9700 · CAIRNS (07) 4052 9400 · veris.com.au · ACN 615 735 727 · Veris Australia Pty Ltd

egis

SCALE 1:1000 | ORIGINAL SIZE A1

CITY OF MORETON BAY
CABOOLTURE DISTRICT OFFICE
2 HASKING STREET CABOOLTURE QLD 4510
PO BOX 159 CABOOLTURE QLD 4510
Telephone: (07) 3205 0555
Email: council@moretonbay.qld.gov.au

OW NUMBER 22-000082_10
LILYWOOD LANDINGS STAGE 10
AS CONSTRUCTED STORMWATER

MBRC SUBDIVISION REFERENCE
DA 2022/2253
No. 1 OF 6 PLANS
DRAWING NUMBER: 401871-10-ASW01-B
REV.: B

REGISTERED SURVEYOR'S CERTIFICATION

I, Veris Australia Pty Ltd, hereby certify that the vertical and horizontal locations and dimensions shown on this plan are a true and correct record and were located by survey.

Qld Registered Surveyor (sig.) | Qld Reg. Surveyor No. 6448 | Date

ENGINEERS CERTIFICATION

I ....., hereby certify that:

1. The information contained in this drawing / document is in compliance with approved drawings and design.
2. This represents an accurate record of as-constructed works.
3. I accept responsibility for the information contained in this drawing / document. In accepting this responsibility we have relied upon information provided by others.

CERTIFICATION FOR LILYWOOD LANDINGS STAGE 10

RPEQ Signature ..... RPEQ No..... Date.....

For and on behalf of EGIS CONSULTING PTY LTD:

COORDINATE DATUM NOTE:

HORIZONTAL COORDINATES(E,N) SUPPLIED ARE MAPPING GRID OF AUSTRALIA(MGA), ZONE 56 BASED ON THE UNIVERSAL TRANSVERSE MERCATOR PROJECTION AND THE GEOCENTRIC DATUM OF AUSTRALIA 2020.

PSM 72109
E: 490729.557
N: 7001736.666
RL: 30.422m

DRAWING REVISIONS		
REV.	REVISION DESCRIPTION	
A	ORIGINAL	08/06/2026
B	PROGRESS	27/07/2026

REFERENCE DRAWINGS
DESCRIPTION

DESIGN FILE No.		DESIGNED	
CONSTRUCT. No.		DATE	
SURVEY FILE No.	401871-10-ASW01-B	DRAWN	JMc
FIELD BOOK		DATE	08/06/2026
LOG BOOK		CHECKED	
LEVEL DATUM	AHD	DATE	
DATUM			

veris
BRISBANE (07) 3666 4700 | WHITSUNDAYS (07) 4945 6600
MACKAY (07) 4957 9700 | CAIRNS (07) 4052 9400
veris.com.au
ACN 615 735 727
Veris Australia Pty Ltd

egis

SCALE 1:250 | ORIGINAL SIZE A1

CITY OF MORETON BAY

CITY OF MORETON BAY
CABOOLTURE DISTRICT OFFICE
2 HASKING STREET CABOOLTURE QLD 4510
PO BOX 159 CABOOLTURE QLD 4510
Telephone: (07) 3205 0555
Email: council@moretonbay.qld.gov.au

OW NUMBER 22-000082_10
LILYWOOD LANDINGS STAGE 10
AS CONSTRUCTED STORMWATER

MBRC SUBDIVISION REFERENCE	
DA 2022/2253	
No. 2 OF 6 PLANS	
DRAWING NUMBER	REV.
401871-10-ASW01-B	B

REGISTERED SURVEYOR'S CERTIFICATION

I, Veris Australia Pty Ltd, hereby certify that the vertical and horizontal locations and dimensions shown on this plan are a true and correct record and were located by survey.

Qld Registered Surveyor (sig.) | 6448 Qld Reg. Surveyor No. | Date

ENGINEERS CERTIFICATION

I ..... hereby certify that:

1. The information contained in this drawing / document is in compliance with approved drawings and design.
2. This represents an accurate record of as-constructed works.
3. I accept responsibility for the information contained in this drawing / document. In accepting this responsibility we have relied upon information provided by others.

CERTIFICATION FOR LILYWOOD LANDINGS STAGE 10

RPEQ Signature ..... RPEQ No..... Date.....

For and on behalf of EGIS CONSULTING PTY LTD:

COORDINATE DATUM NOTE:

HORIZONTAL COORDINATES(E,N) SUPPLIED ARE MAPPING GRID OF AUSTRALIA(MGA), ZONE 56 BASED ON THE UNIVERSAL TRANSVERSE MERCATOR PROJECTION AND THE GEOCENTRIC DATUM OF AUSTRALIA 2020.

PSM 72109
E: 490729.557
N: 7001736.666
RL: 30.422m

DRAWING REVISIONS			REFERENCE DRAWINGS
REV.	REVISION DESCRIPTION		DESCRIPTION
A	ORIGINAL	08/06/2026	
B	PROGRESS	27/07/2026	

DESIGN FILE No.		DESIGNED	
CONSTRUCT. No.		DATE	
SURVEY FILE No.	401871-10-ASW01-B	DRAWN	JMc
FIELD BOOK		DATE	08/06/2026
LOG BOOK		CHECKED	
LEVEL DATUM	AHD	DATE	
DATUM			

veris — BRISBANE (07) 3666 4700 · WHITSUNDAYS (07) 4945 9600 · MACKAY (07) 4957 9700 · CAIRNS (07) 4052 9400 · veris.com.au · ACN 615 735 727 Veris Australia Pty Ltd

egis

SCALE 1:250 | ORIGINAL SIZE A1

CITY OF MORETON BAY
CABOOLTURE DISTRICT OFFICE
2 HASKING STREET CABOOLTURE QLD 4510
PO BOX 159 CABOOLTURE QLD 4510
Telephone: (07) 3205 0555
Email: council@moretonbay.qld.gov.au

OW NUMBER 22-000082_10
LILYWOOD LANDINGS STAGE 10
AS CONSTRUCTED STORMWATER

MBRC SUBDIVISION REFERENCE	
DA 2022/2253	
No. 3 OF 6 PLANS	
DRAWING NUMBER	REV.
401871-10-ASW01-B	B

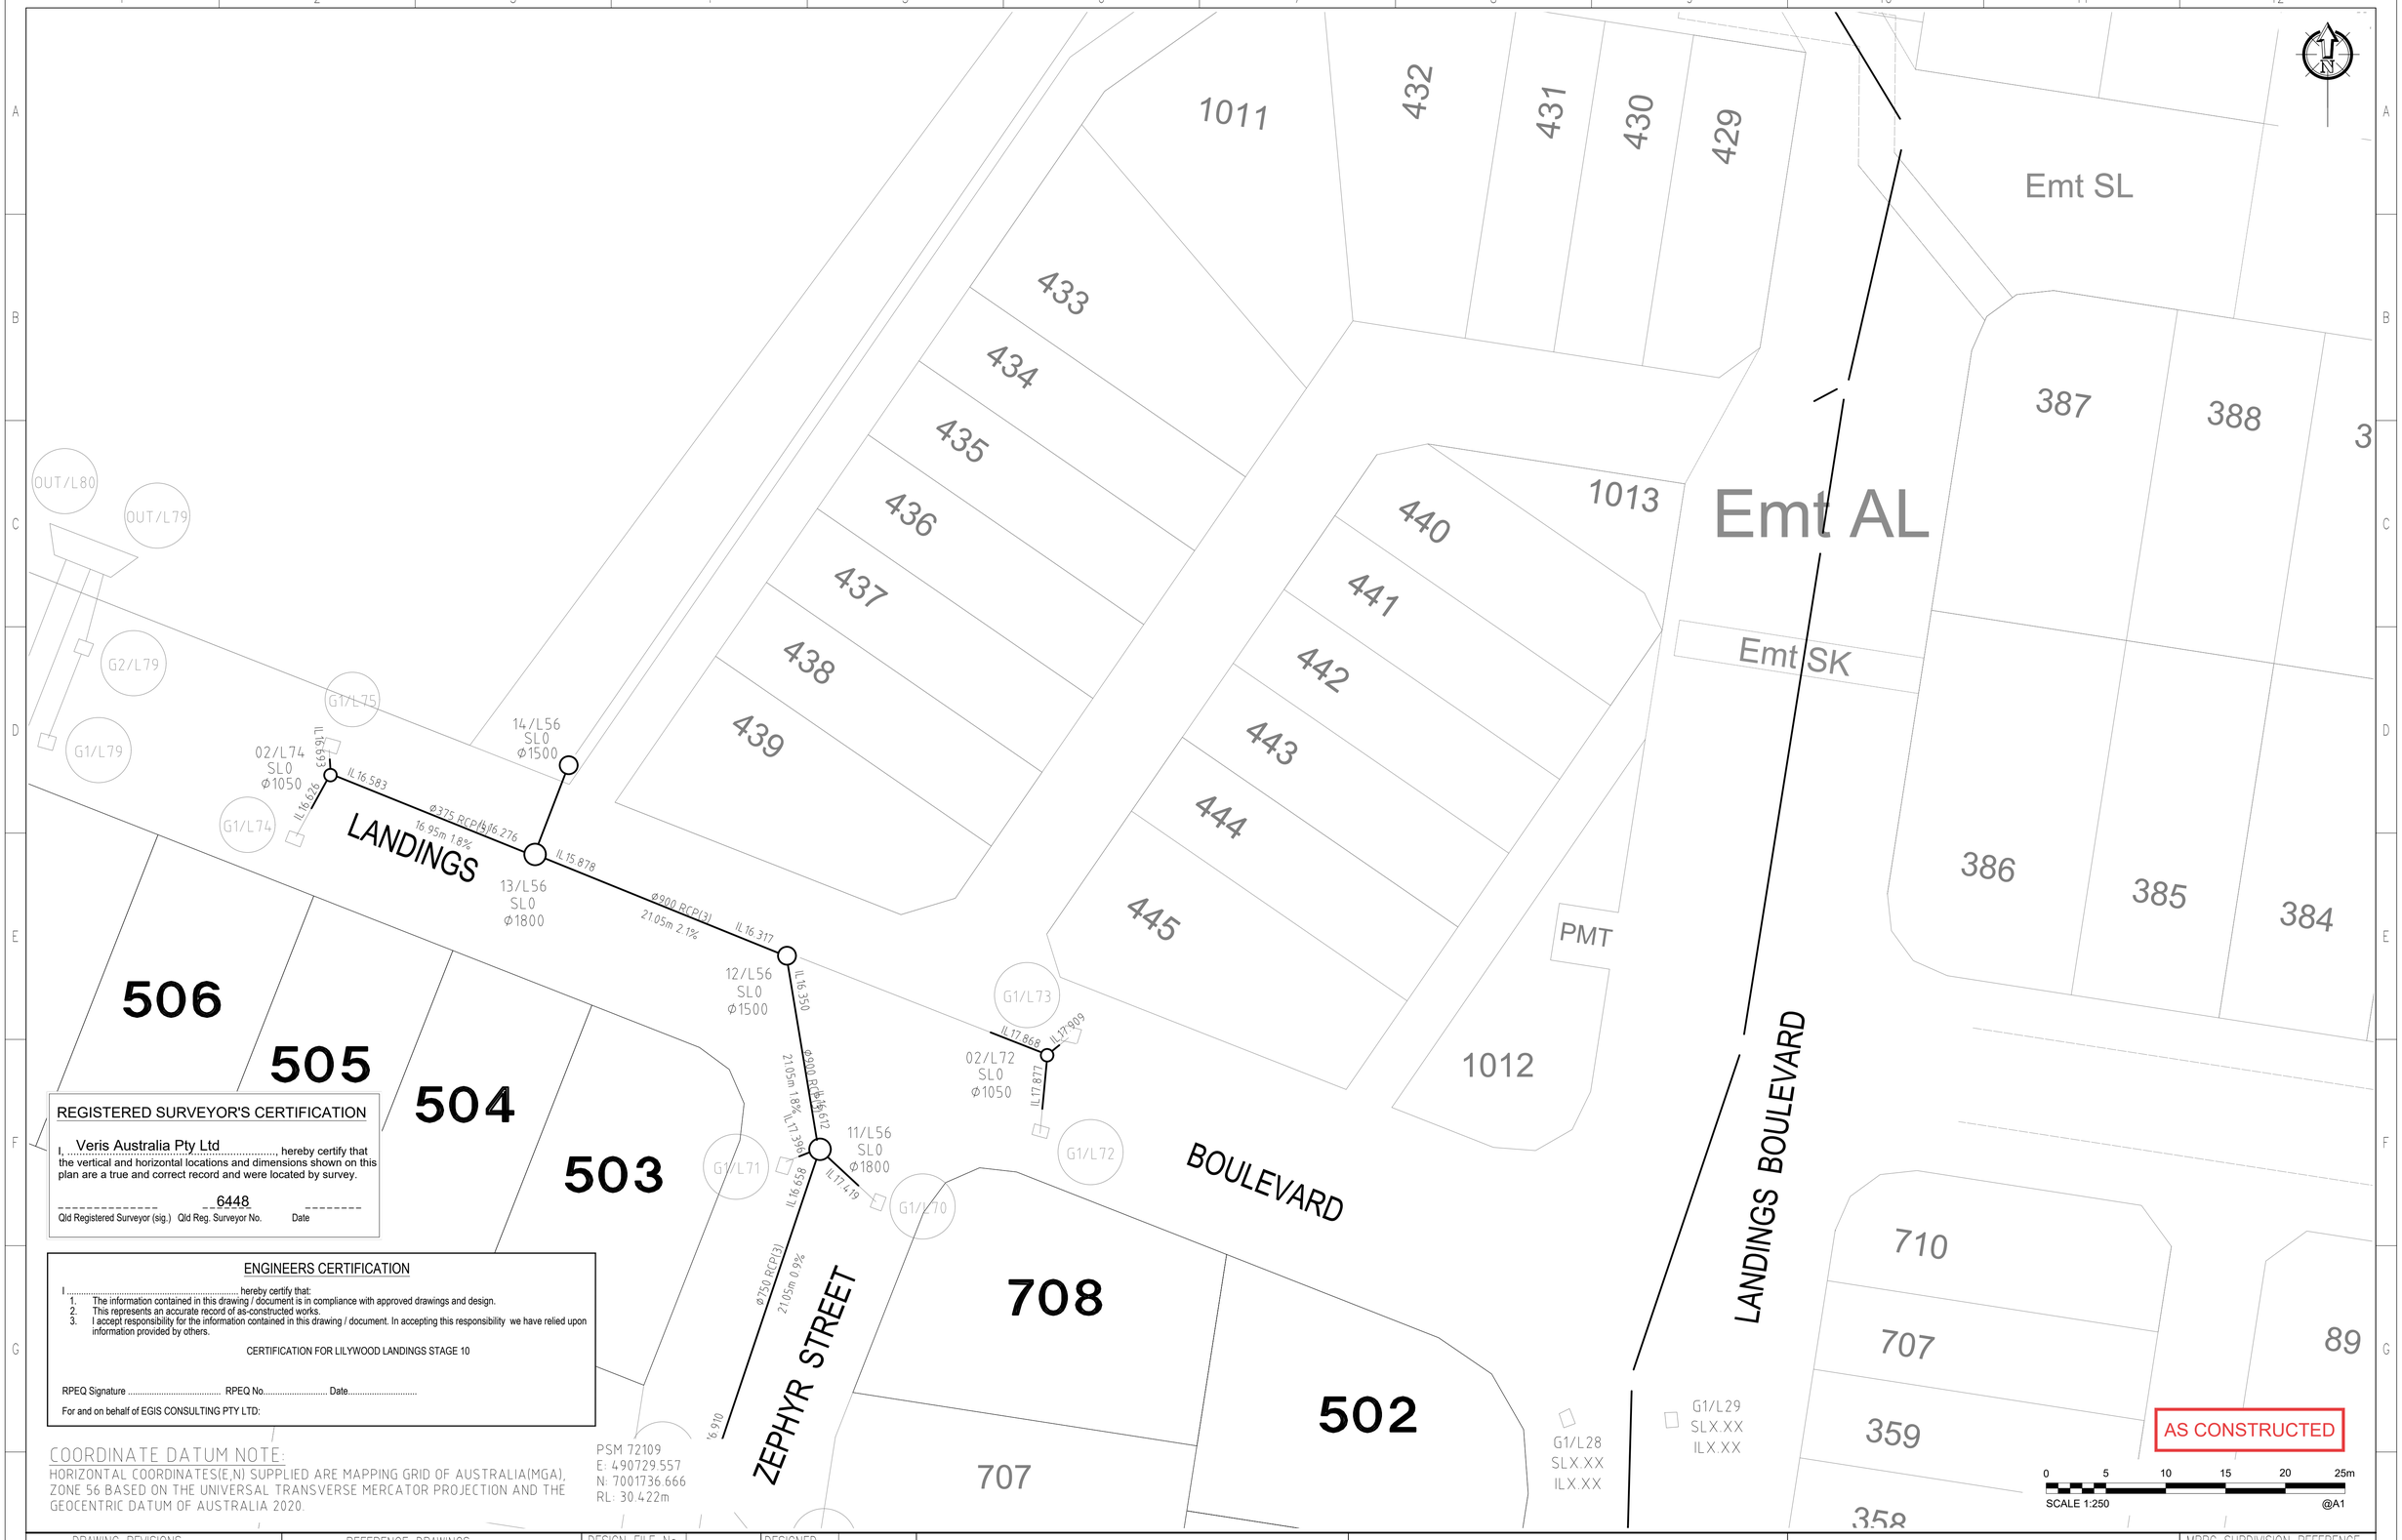

REGISTERED SURVEYOR'S CERTIFICATION

I, Veris Australia Pty Ltd, hereby certify that the vertical and horizontal locations and dimensions shown on this plan are a true and correct record and were located by survey.

Qld Registered Surveyor (sig.) | Qld Reg. Surveyor No. 6448 | Date

ENGINEERS CERTIFICATION

I ..... hereby certify that:

1. The information contained in this drawing / document is in compliance with approved drawings and design.
2. This represents an accurate record of as-constructed works.
3. I accept responsibility for the information contained in this drawing / document. In accepting this responsibility we have relied upon information provided by others.

CERTIFICATION FOR LILYWOOD LANDINGS STAGE 10

RPEQ Signature ..... RPEQ No..... Date.....

For and on behalf of EGIS CONSULTING PTY LTD:

COORDINATE DATUM NOTE:

HORIZONTAL COORDINATES(E,N) SUPPLIED ARE MAPPING GRID OF AUSTRALIA(MGA), ZONE 56 BASED ON THE UNIVERSAL TRANSVERSE MERCATOR PROJECTION AND THE GEOCENTRIC DATUM OF AUSTRALIA 2020.

PSM 72109
E: 490729.557
N: 7001736.666
RL: 30.422m

DRAWING REVISIONS			REFERENCE DRAWINGS	DESIGN FILE No.		DESIGNED	
REV.	REVISION DESCRIPTION		DESCRIPTION	CONSTRUCT. No.		DATE	
A	ORIGINAL	08/06/2026		SURVEY FILE No.	401871-10-ASW01-B	DRAWN	JMc
B	PROGRESS	27/07/2026		FIELD BOOK		DATE	08/06/2026
				LOG BOOK		CHECKED	
				LEVEL DATUM	AHD	DATE	
				DATUM			

veris
BRISBANE (07) 3666 4700 · WHITSUNDAYS (07) 4945 6600 · MACKAY (07) 4957 9700 · CAIRNS (07) 4052 9400
veris.com.au
ACN 615 735 727
Veris Australia Pty Ltd

egis

CITY OF MORETON BAY
CABOOLTURE DISTRICT OFFICE
2 HASKING STREET CABOOLTURE QLD 4510
PO BOX 159 CABOOLTURE QLD 4510
Telephone: (07) 3205 0555
Email: council@moretonbay.qld.gov.au

SCALE 1:250 | ORIGINAL SIZE A1

OW NUMBER 22-000082_10
LILYWOOD LANDINGS STAGE 10
AS CONSTRUCTED STORMWATER

MBRC SUBDIVISION REFERENCE	
DA 2022/2253	
No. 4 OF 6 PLANS	
DRAWING NUMBER	REV.
401871-10-ASW01-B	B

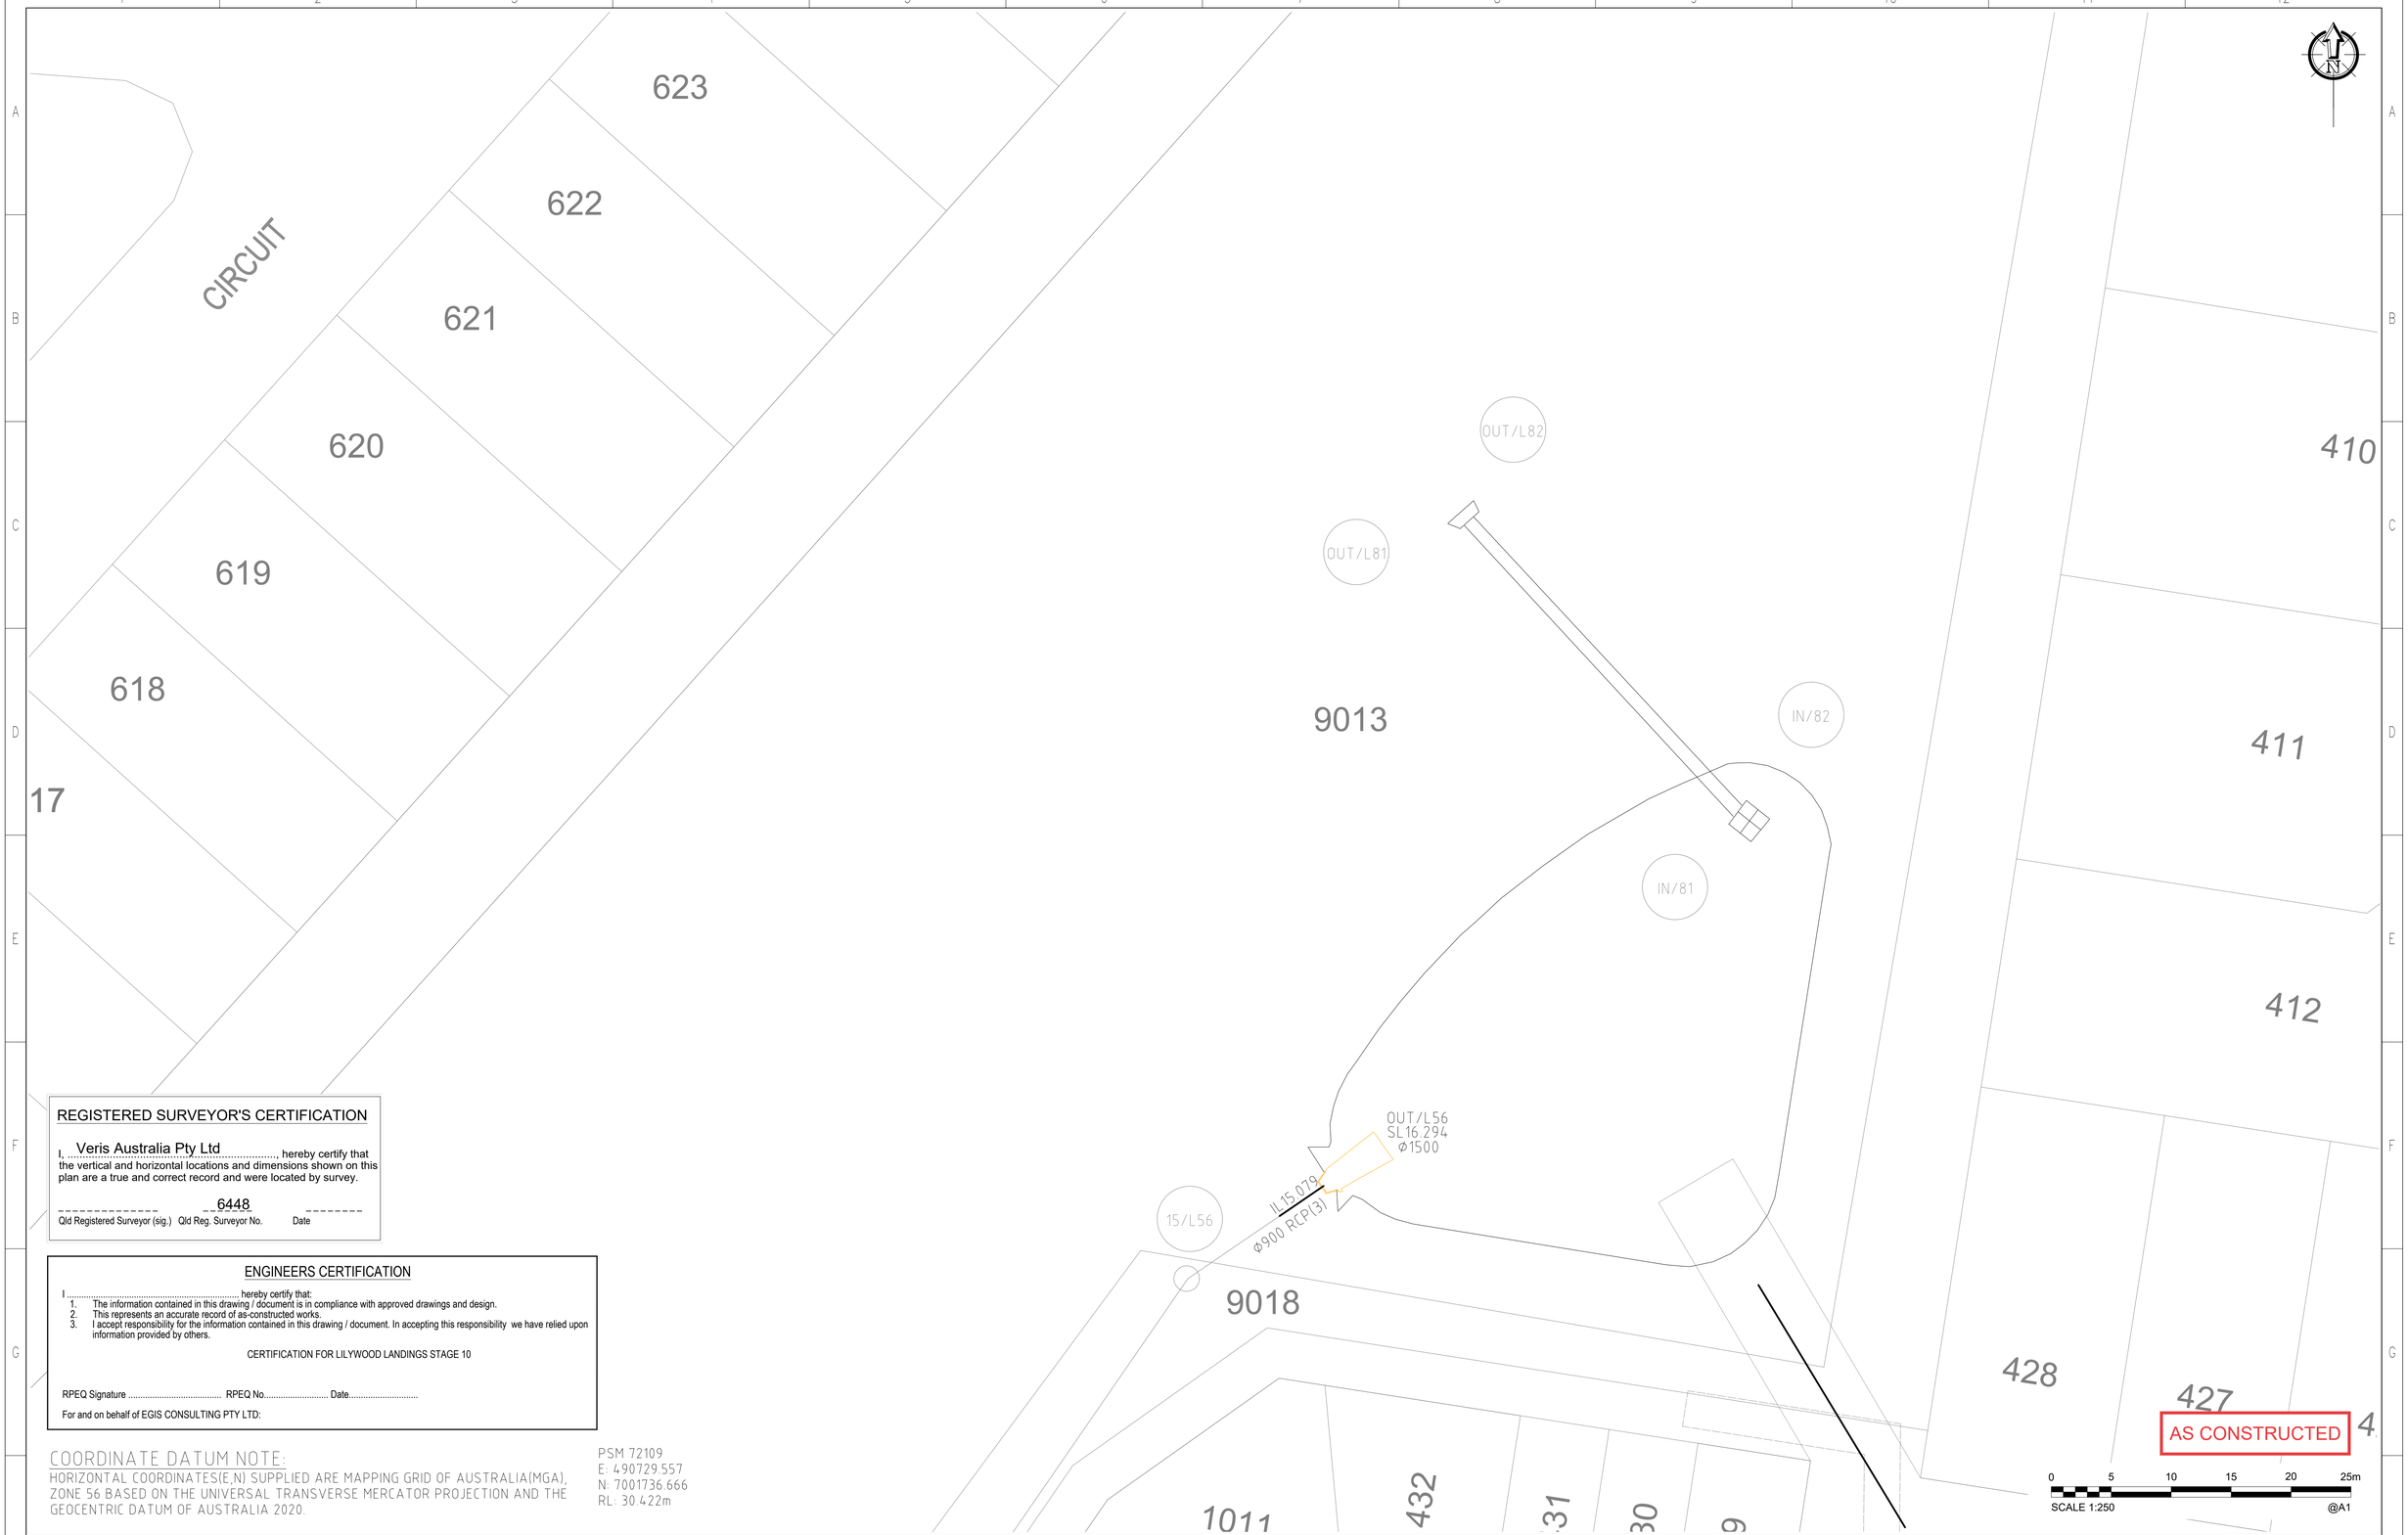

REGISTERED SURVEYOR'S CERTIFICATION

I, Veris Australia Pty Ltd, hereby certify that the vertical and horizontal locations and dimensions shown on this plan are a true and correct record and were located by survey.

Qld Registered Surveyor (sig.)	Qld Reg. Surveyor No.	Date
	6448	

ENGINEERS CERTIFICATION

I ..... hereby certify that:

1. The information contained in this drawing / document is in compliance with approved drawings and design.
2. This represents an accurate record of as-constructed works.
3. I accept responsibility for the information contained in this drawing / document. In accepting this responsibility we have relied upon information provided by others.

CERTIFICATION FOR LILYWOOD LANDINGS STAGE 10

RPEQ Signature ..... RPEQ No..... Date.....

For and on behalf of EGIS CONSULTING PTY LTD:

COORDINATE DATUM NOTE:

HORIZONTAL COORDINATES(E,N) SUPPLIED ARE MAPPING GRID OF AUSTRALIA(MGA), ZONE 56 BASED ON THE UNIVERSAL TRANSVERSE MERCATOR PROJECTION AND THE GEOCENTRIC DATUM OF AUSTRALIA 2020.

PSM 72109
E: 490729.557
N: 7001736.666
RL: 30.422m

DRAWING REVISIONS		
REV.	REVISION DESCRIPTION	
A	ORIGINAL	08/06/2026
B	PROGRESS	27/07/2026

REFERENCE DRAWINGS
DESCRIPTION

DESIGN FILE No.		DESIGNED	
CONSTRUCT. No.		DATE	
SURVEY FILE No.	401871-10-ASW01-B	DRAWN	JMc
FIELD BOOK		DATE	08/06/2026
LOG BOOK		CHECKED	
LEVEL DATUM	AHD	DATE	
DATUM			

veris
BRISBANE (07) 3666 4700 · WHITSUNDAYS (07) 4945 9800
MACKAY (07) 4957 9700 · CAIRNS (07) 4052 9400
veris.com.au
ACN 615 735 727
Veris Australia Pty Ltd

egis

SCALE 1:250 ORIGINAL SIZE A1

CITY OF MORETON BAY
CABOOLTURE DISTRICT OFFICE
2 HASKING STREET CABOOLTURE QLD 4510
PO BOX 159 CABOOLTURE QLD 4510
Telephone: (07) 3205 0555
Email: council@moretonbay.qld.gov.au

OW NUMBER 22-000082_10
LILYWOOD LANDINGS STAGE 10
AS CONSTRUCTED STORMWATER

MBRC SUBDIVISION REFERENCE	
DA 2022/2253	
No. 5 OF 6 PLANS	
DRAWING NUMBER	REV.
401871-10-ASW01-B	B

615
614
613
612
611
608
609
610
513
512
511
510
509
508
507
1014
506
505
504
434
435
436
437
438
439
CIRCUIT
ABERDEEN
Emt AQ
PMT
OUT/L80
OUT/L79
G2/L79
G1/L79
IN/L80
G1/L75
G1/L74
G1/L73
02/L74
SL0
Ø1050
IL 16.693
IL 16.626
IL 16.583
Ø375 RCP(4)
16.95m 1.8%
IL 16.276
14/L56
SL0
Ø1500
LANDINGS
IL 15.878
13/L56
SL0
Ø1800
Ø900 RCP(3)
21.05m 2.1%
IL 16.317
12/L56
SL0
Ø1500
IL 16.350
Ø900 RCP(3)
21.05m 1.8%
IL 16.617
IL 17.868
02/L72
SL0
Ø1050
IL 17.877

REGISTERED SURVEYOR'S CERTIFICATION

I, Veris Australia Pty Ltd, hereby certify that the vertical and horizontal locations and dimensions shown on this plan are a true and correct record and were located by survey.

_____ 6448 _____
Qld Registered Surveyor (sig.) Qld Reg. Surveyor No. Date

ENGINEERS CERTIFICATION

I ..... hereby certify that:

1. The information contained in this drawing / document is in compliance with approved drawings and design.
2. This represents an accurate record of as-constructed works.
3. I accept responsibility for the information contained in this drawing / document. In accepting this responsibility we have relied upon information provided by others.

CERTIFICATION FOR LILYWOOD LANDINGS STAGE 10

RPEQ Signature ..... RPEQ No..... Date.....

For and on behalf of EGIS CONSULTING PTY LTD:

AS CONSTRUCTED

COORDINATE DATUM NOTE:

HORIZONTAL COORDINATES(E,N) SUPPLIED ARE MAPPING GRID OF AUSTRALIA(MGA), ZONE 56 BASED ON THE UNIVERSAL TRANSVERSE MERCATOR PROJECTION AND THE GEOCENTRIC DATUM OF AUSTRALIA 2020.

PSM 72109
E: 490729.557
N: 7001736.666
RL: 30.422m

0 5 10 15 20 25m
SCALE 1:250 @A1

DRAWING REVISIONS		
REV.	REVISION DESCRIPTION	
A	ORIGINAL	08/06/2026
B	PROGRESS	27/07/2026

REFERENCE DRAWINGS
DESCRIPTION

DESIGN FILE No.		DESIGNED	
CONSTRUCT. No.		DATE	
SURVEY FILE No.	401871-10-ASW01-B	DRAWN	JMc
FIELD BOOK		DATE	08/06/2026
LOG BOOK		CHECKED	
LEVEL DATUM	AHD	DATE	
DATUM			

veris — BRISBANE (07) 3666 4700 · WHITSUNDAYS (07) 4945 6600 · MACKAY (07) 4957 9700 · CAIRNS (07) 4052 8400 · veris.com.au · ACN 615 735 727 · Veris Australia Pty Ltd

egis

SCALE 1:250 ORIGINAL SIZE A1

CITY OF MORETON BAY
CABOOLTURE DISTRICT OFFICE
2 HASKING STREET CABOOLTURE QLD 4510
PO BOX 159 CABOOLTURE QLD 4510
Telephone: (07) 3205 0555
Email: council@moretonbay.qld.gov.au

OW NUMBER 22-000082_10
LILYWOOD LANDINGS STAGE 10
AS CONSTRUCTED STORMWATER

MBRC SUBDIVISION REFERENCE
DA 2022/2253
No. 6 OF 6 PLANS

DRAWING NUMBER	REV.
401871-10-ASW01-B	B